


NOTE:- WARSHEL MINE - QUIT MINING 5-21-56
EQUIPMENT PULLED - DRIFT SEALED.

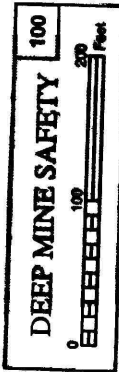

"B" SEAM

AS LEASED FROM

BIRD COAL COMPANY

SITUATE: RICHLAND-TWP-CAMBRIA-CO-PA

SCALE 1"=100' FEB. 17TH 1933

L. H. ALTENUS
DUVAYOR
NB. 3374

Revised Aug. 3, 1936
Sept. 28, 1944: