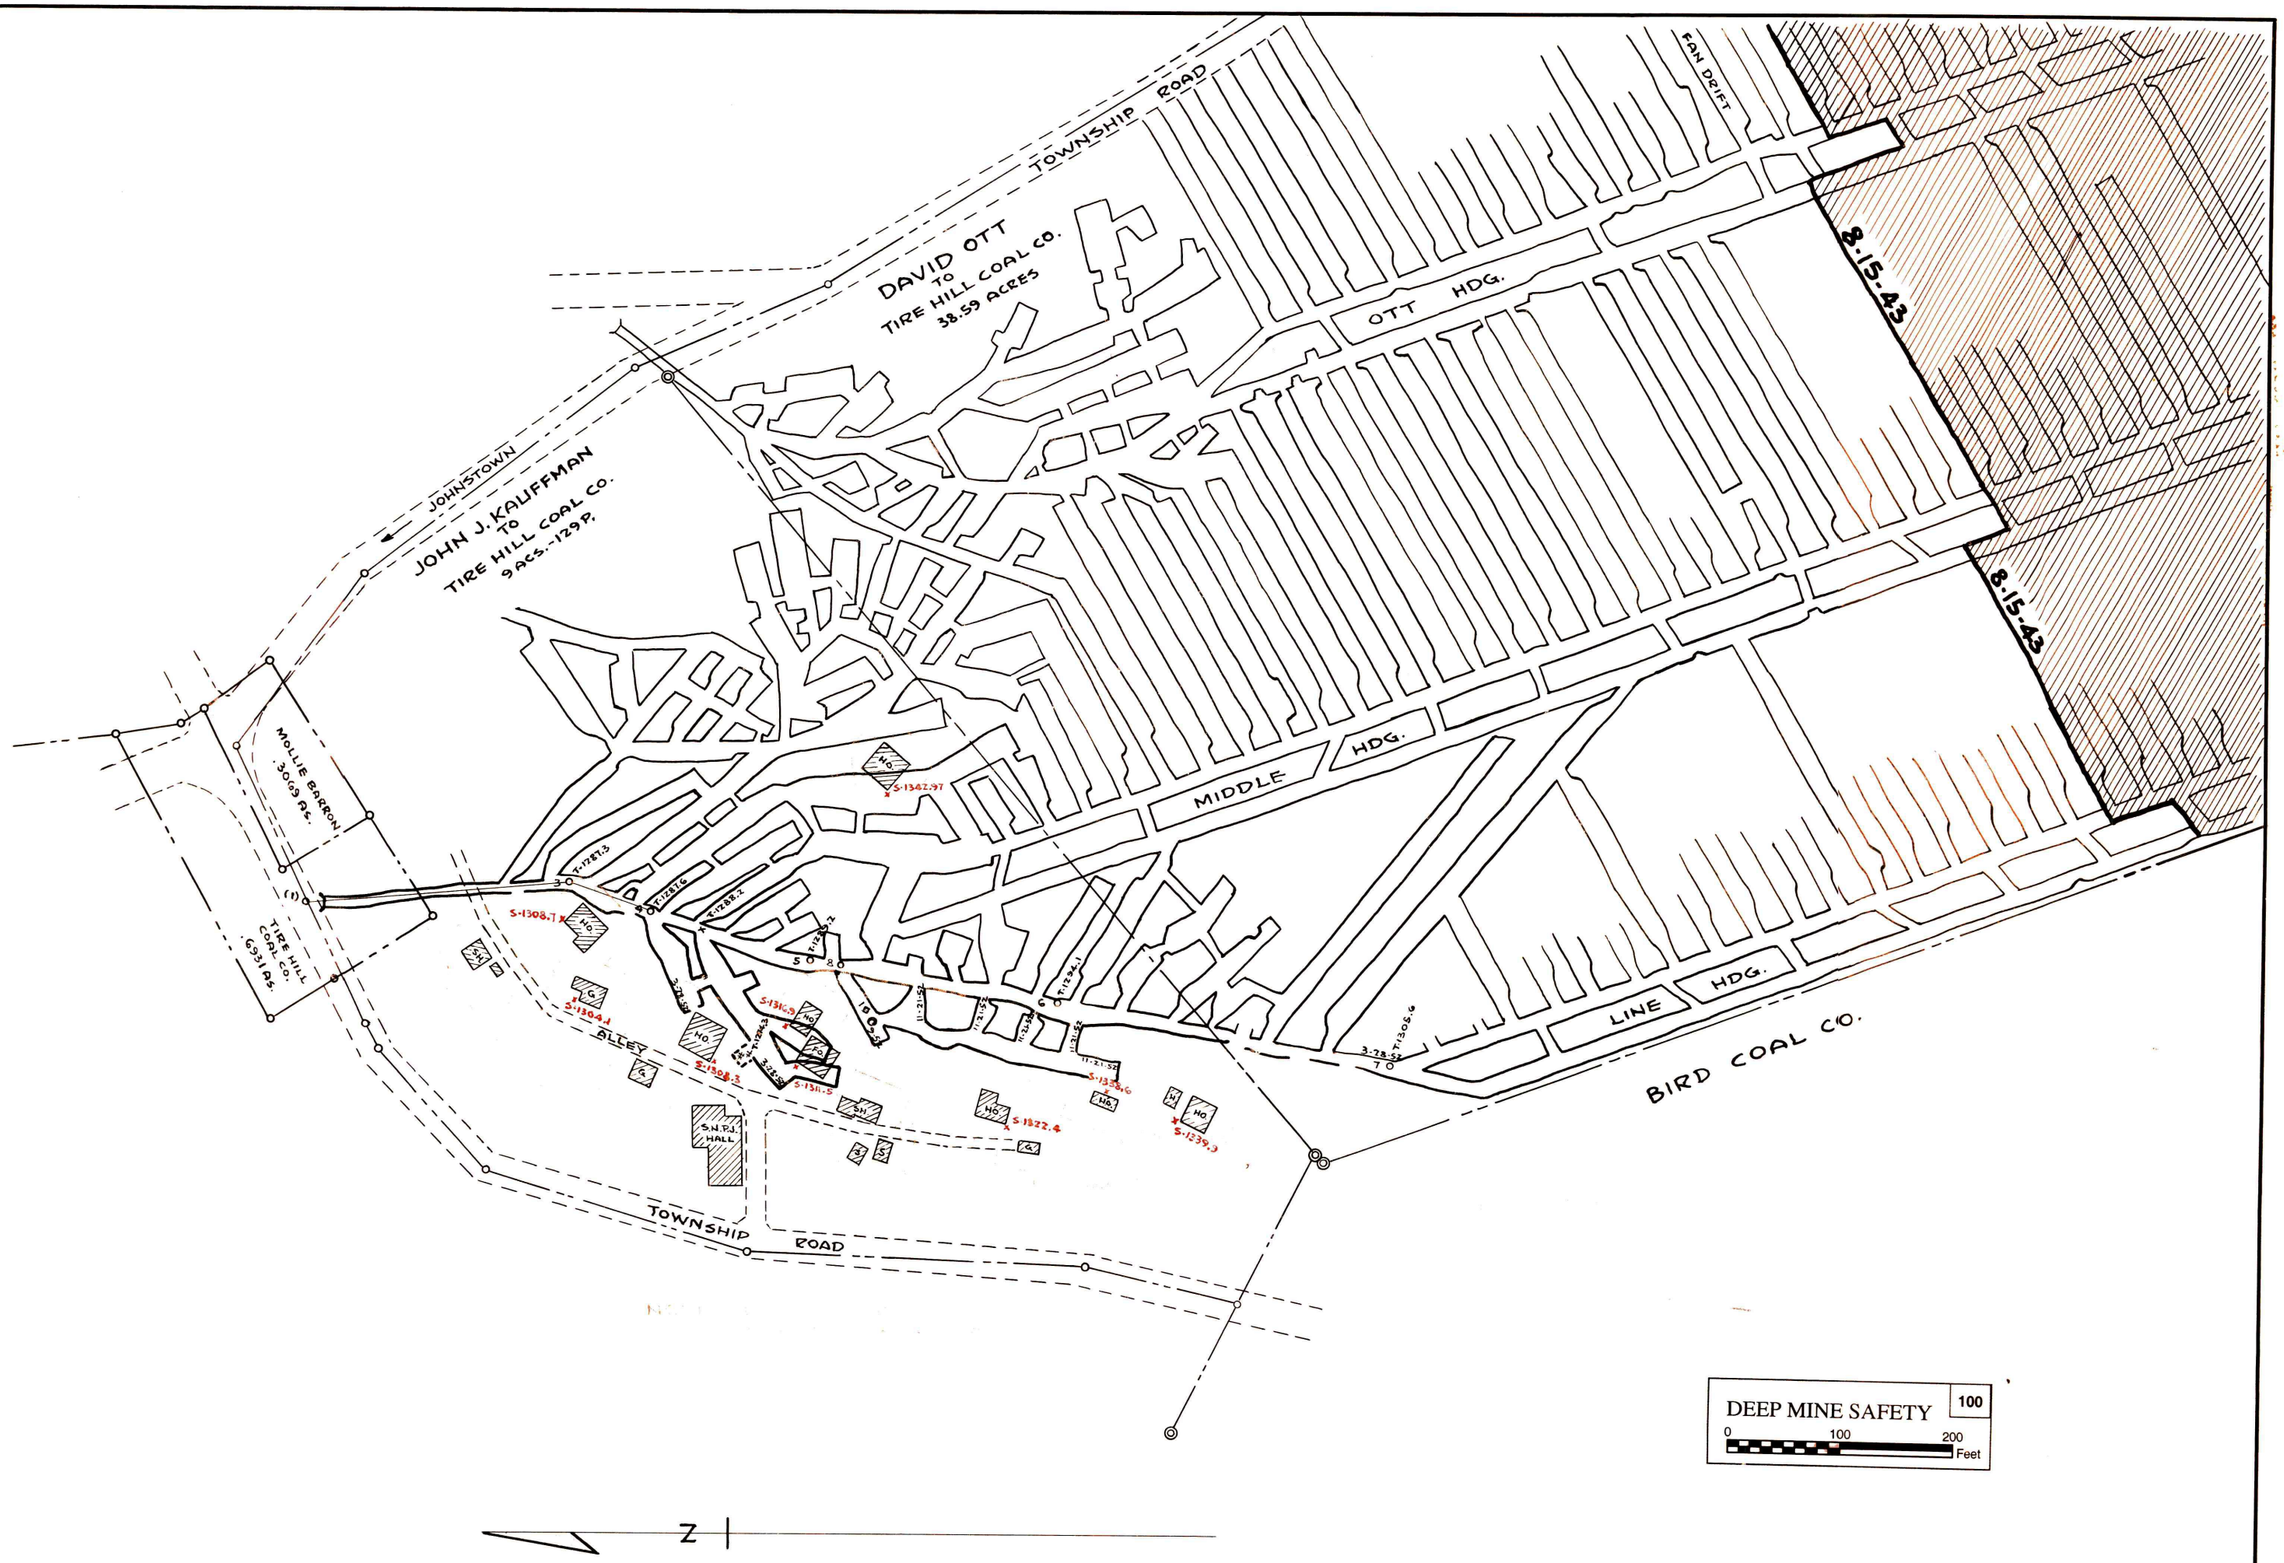

BILL'S COAL CO. (LESSE)

"C" PRIME

TIRE HILL, PA. CONEMAUGH TWP.

SCALE - 1" = 100' FT. 4-19-52

MBB-100