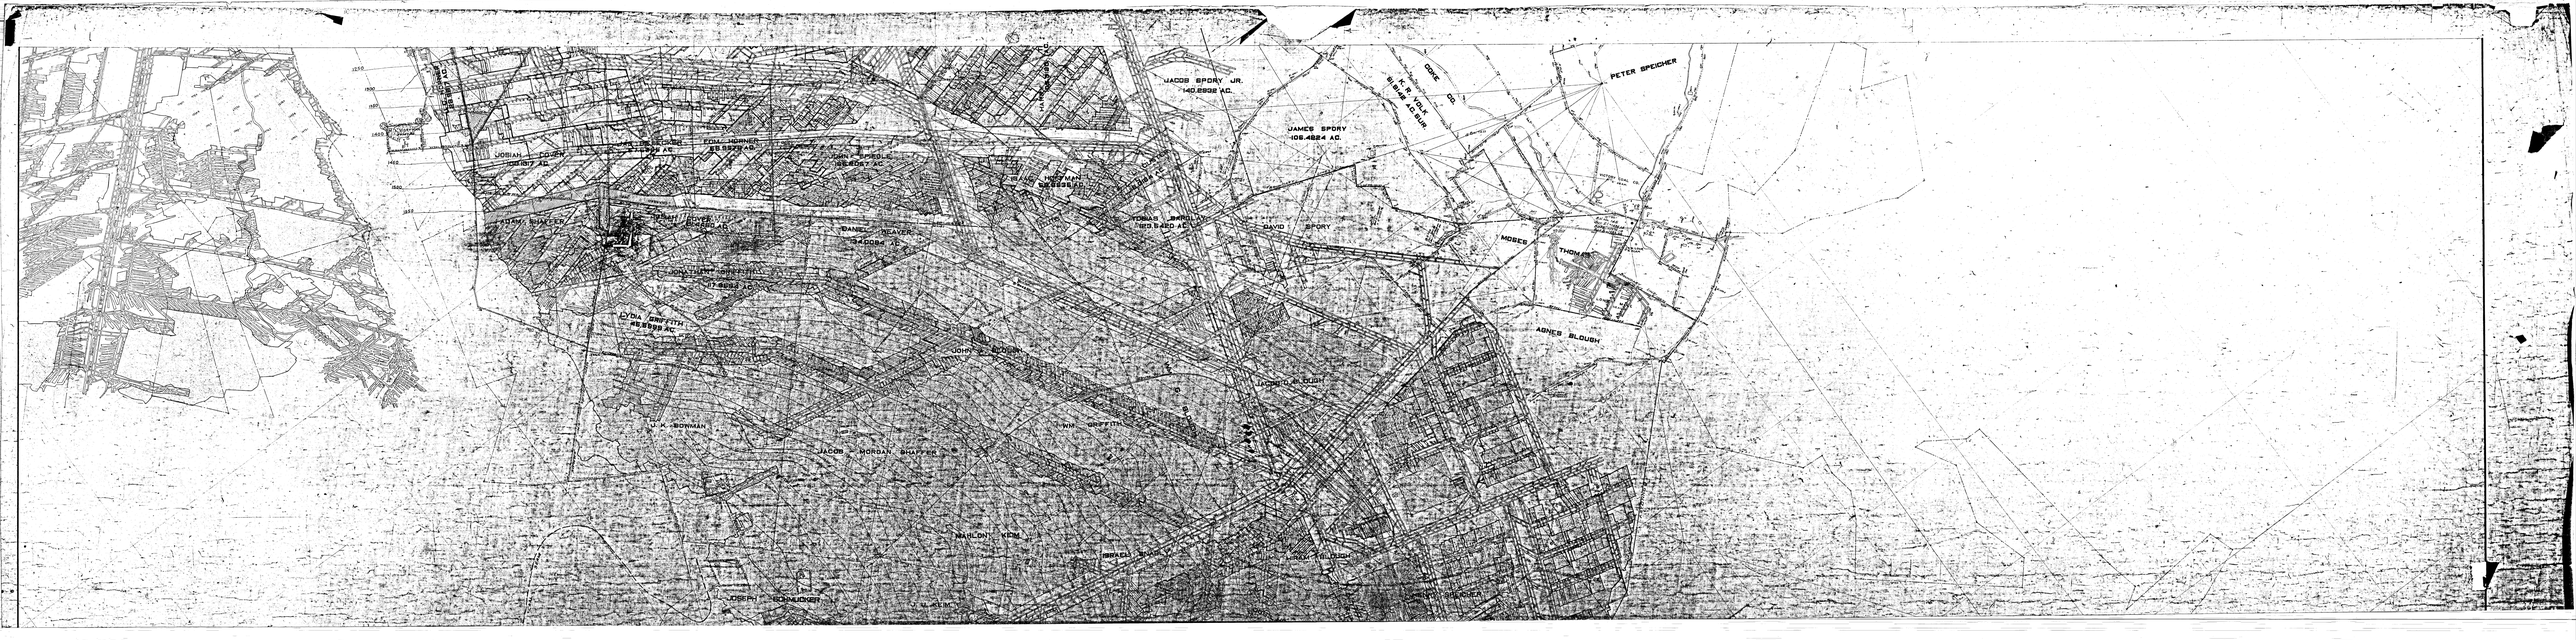

COAL SEAM
J. K. BOWMAN
LYDIA GRIFFITH
45.5999 AC.
JOSEPH SCHMUCKER
JACOB MORGAN SHAFFER
J. L. KEIM
MAHLON KEIM
ADAM SHAFFER
JOSIAH COVER
100.1917 AC.
J. C. HORNER
28.9917 AC.
1550
1500
1450
1400
1350
1300
1250
JONATHAN GRIFFITH
17.3664 AC.
JOSIAH COVER
51.4680 AC.
EDW. HORNER
58.9578 AC.
DANIEL WEAVER
134.0084 AC.
JOHN SPIEGLE
156.8057 AC.
JOHN BLOUGH
WM. GRIFFITH
WM. G. BLOUGH
HIRAM BLOUGH
JACOB D. BLOUGH
ISAAC HOFFMAN
58.5365 AC.
HARRY
103.5120 AC.
TOBIAS
123.6420 AC.
JACOB SPORY JR.
140.2932 AC.
DAVID SPORY
JAMES SPORY
106.4824 AC.
K. R. VOLK
51.8148 AC. SUR.
COKE CO.
MOSES THOMAS
AGNES BLOUGH
VICTORY COAL CO.
PETER SPEICHER
BOUNDARY