


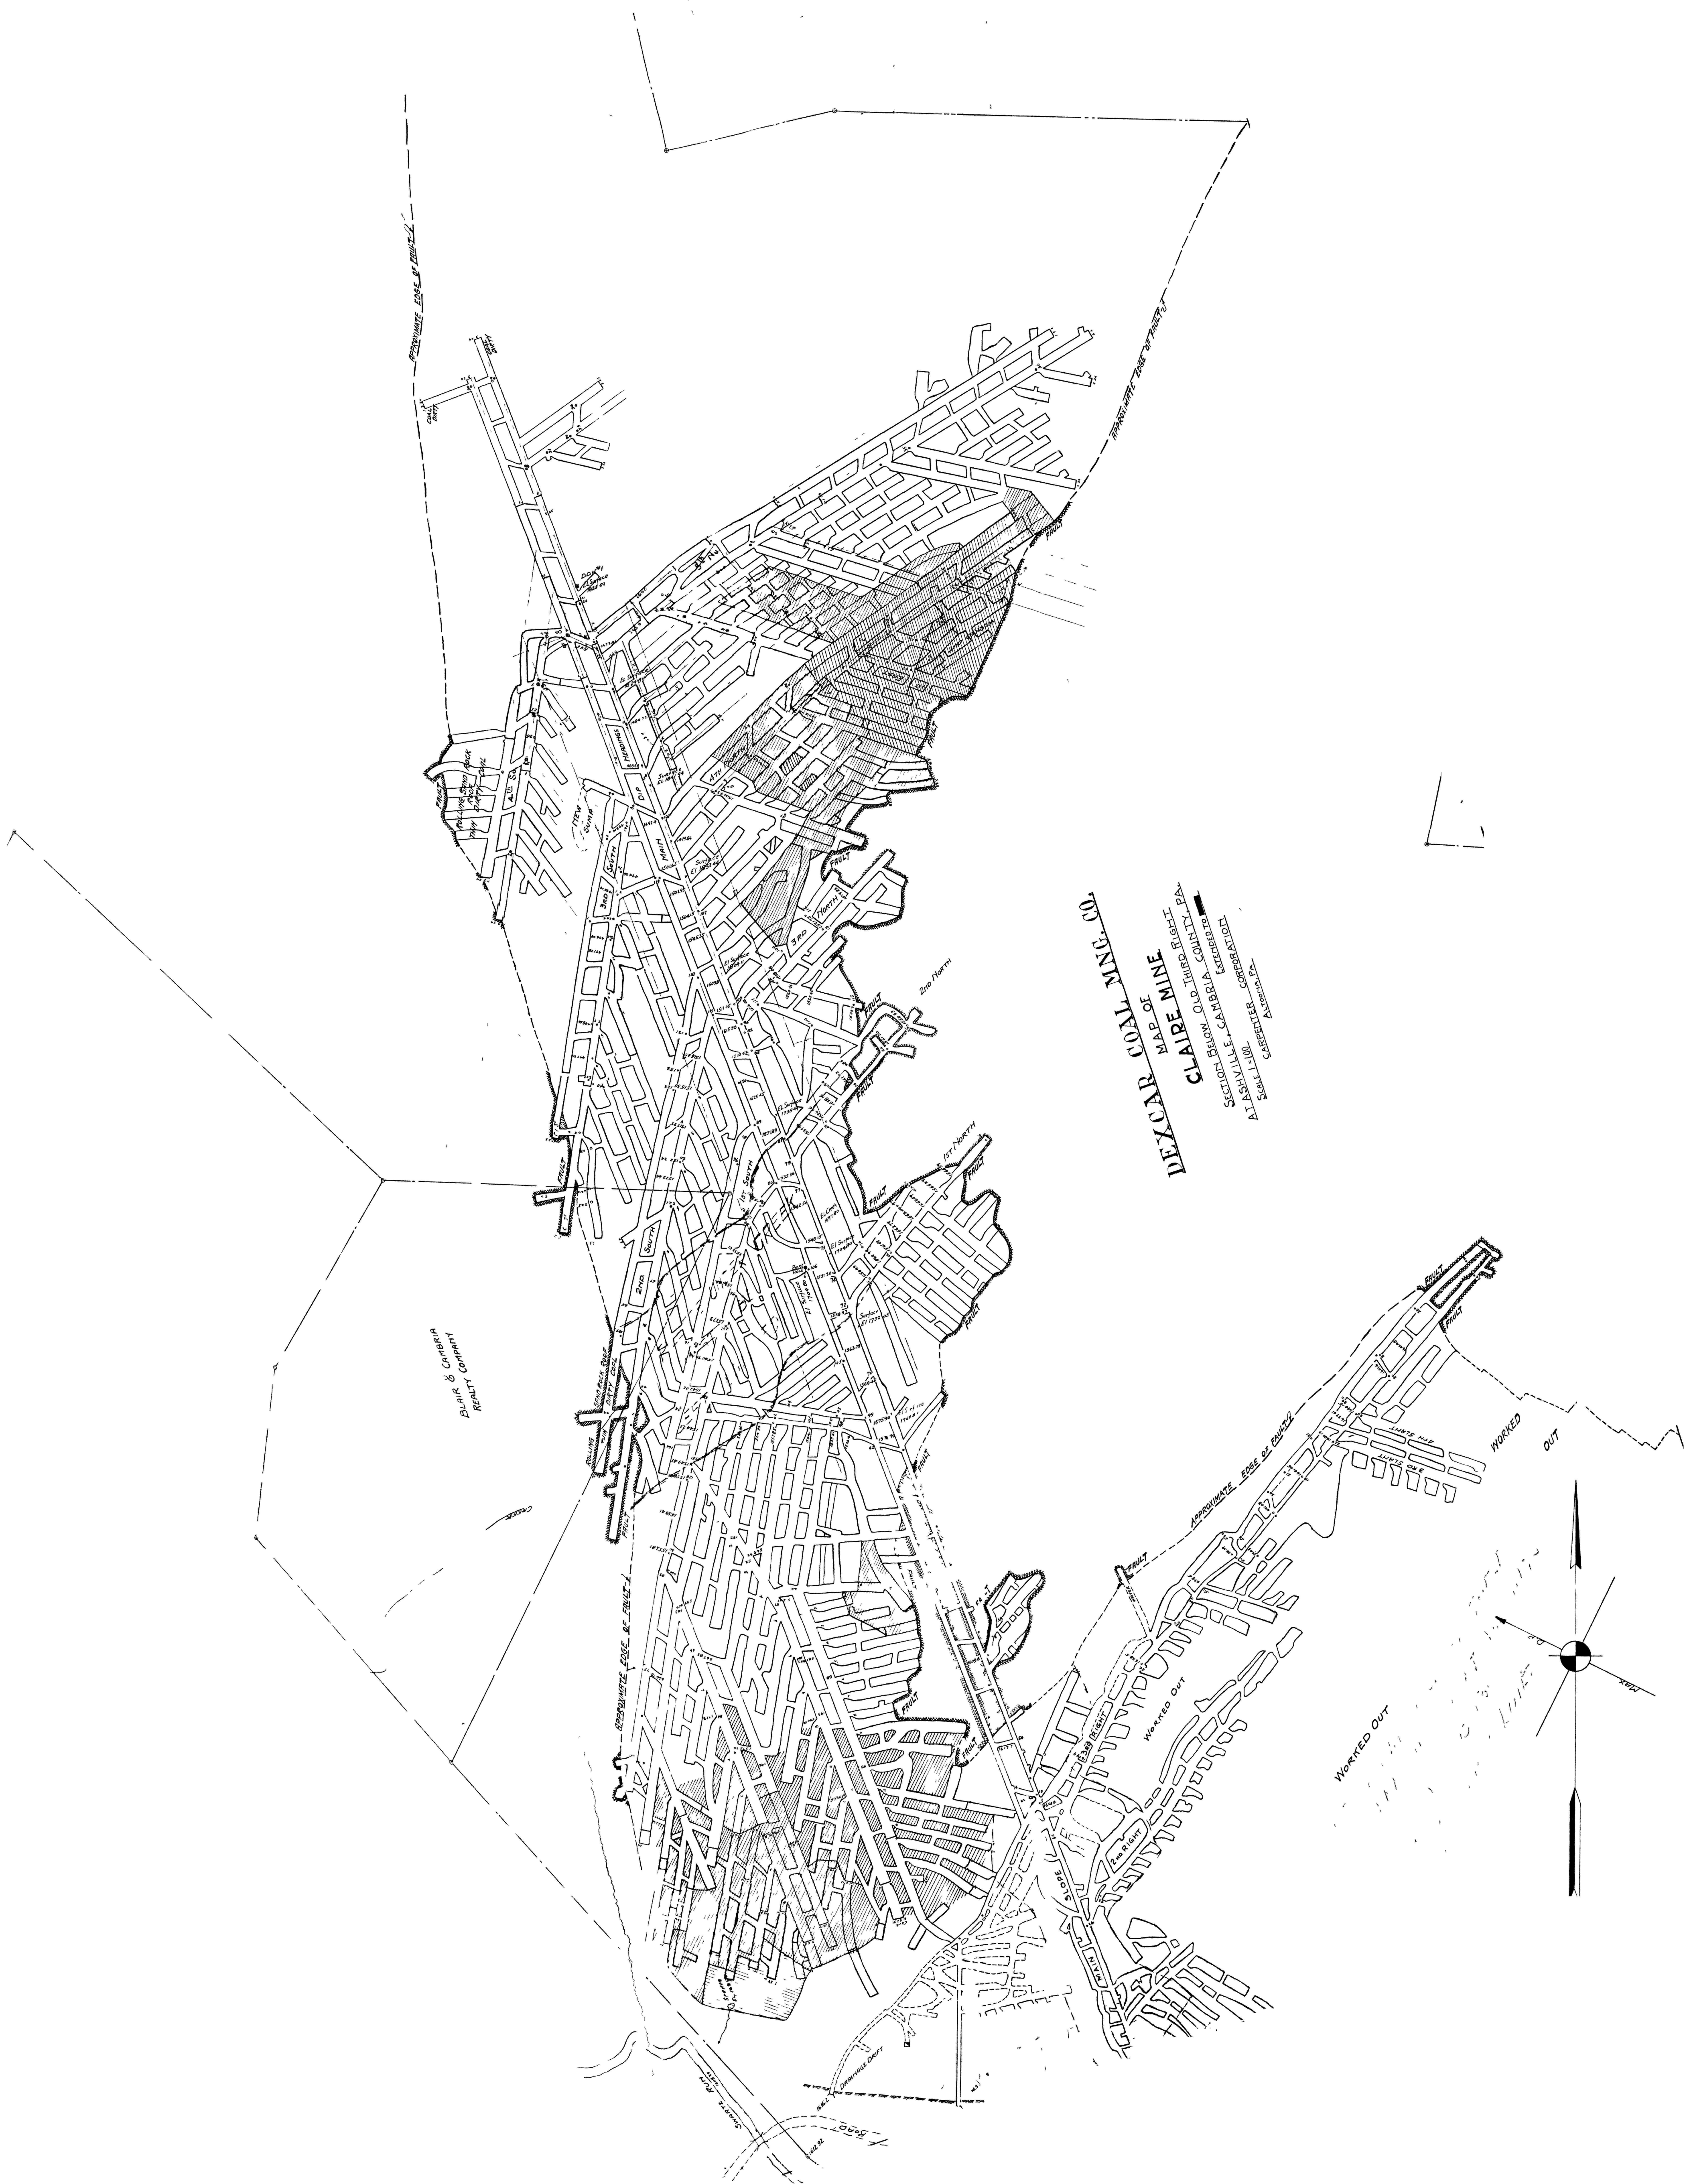

MAP OF
CLARE MINE
SECTION BEYOND OLD THIRD RIGHT PA
ATASHVILLE, CAMBRIA COUNTY, PENNSYLVANIA

