


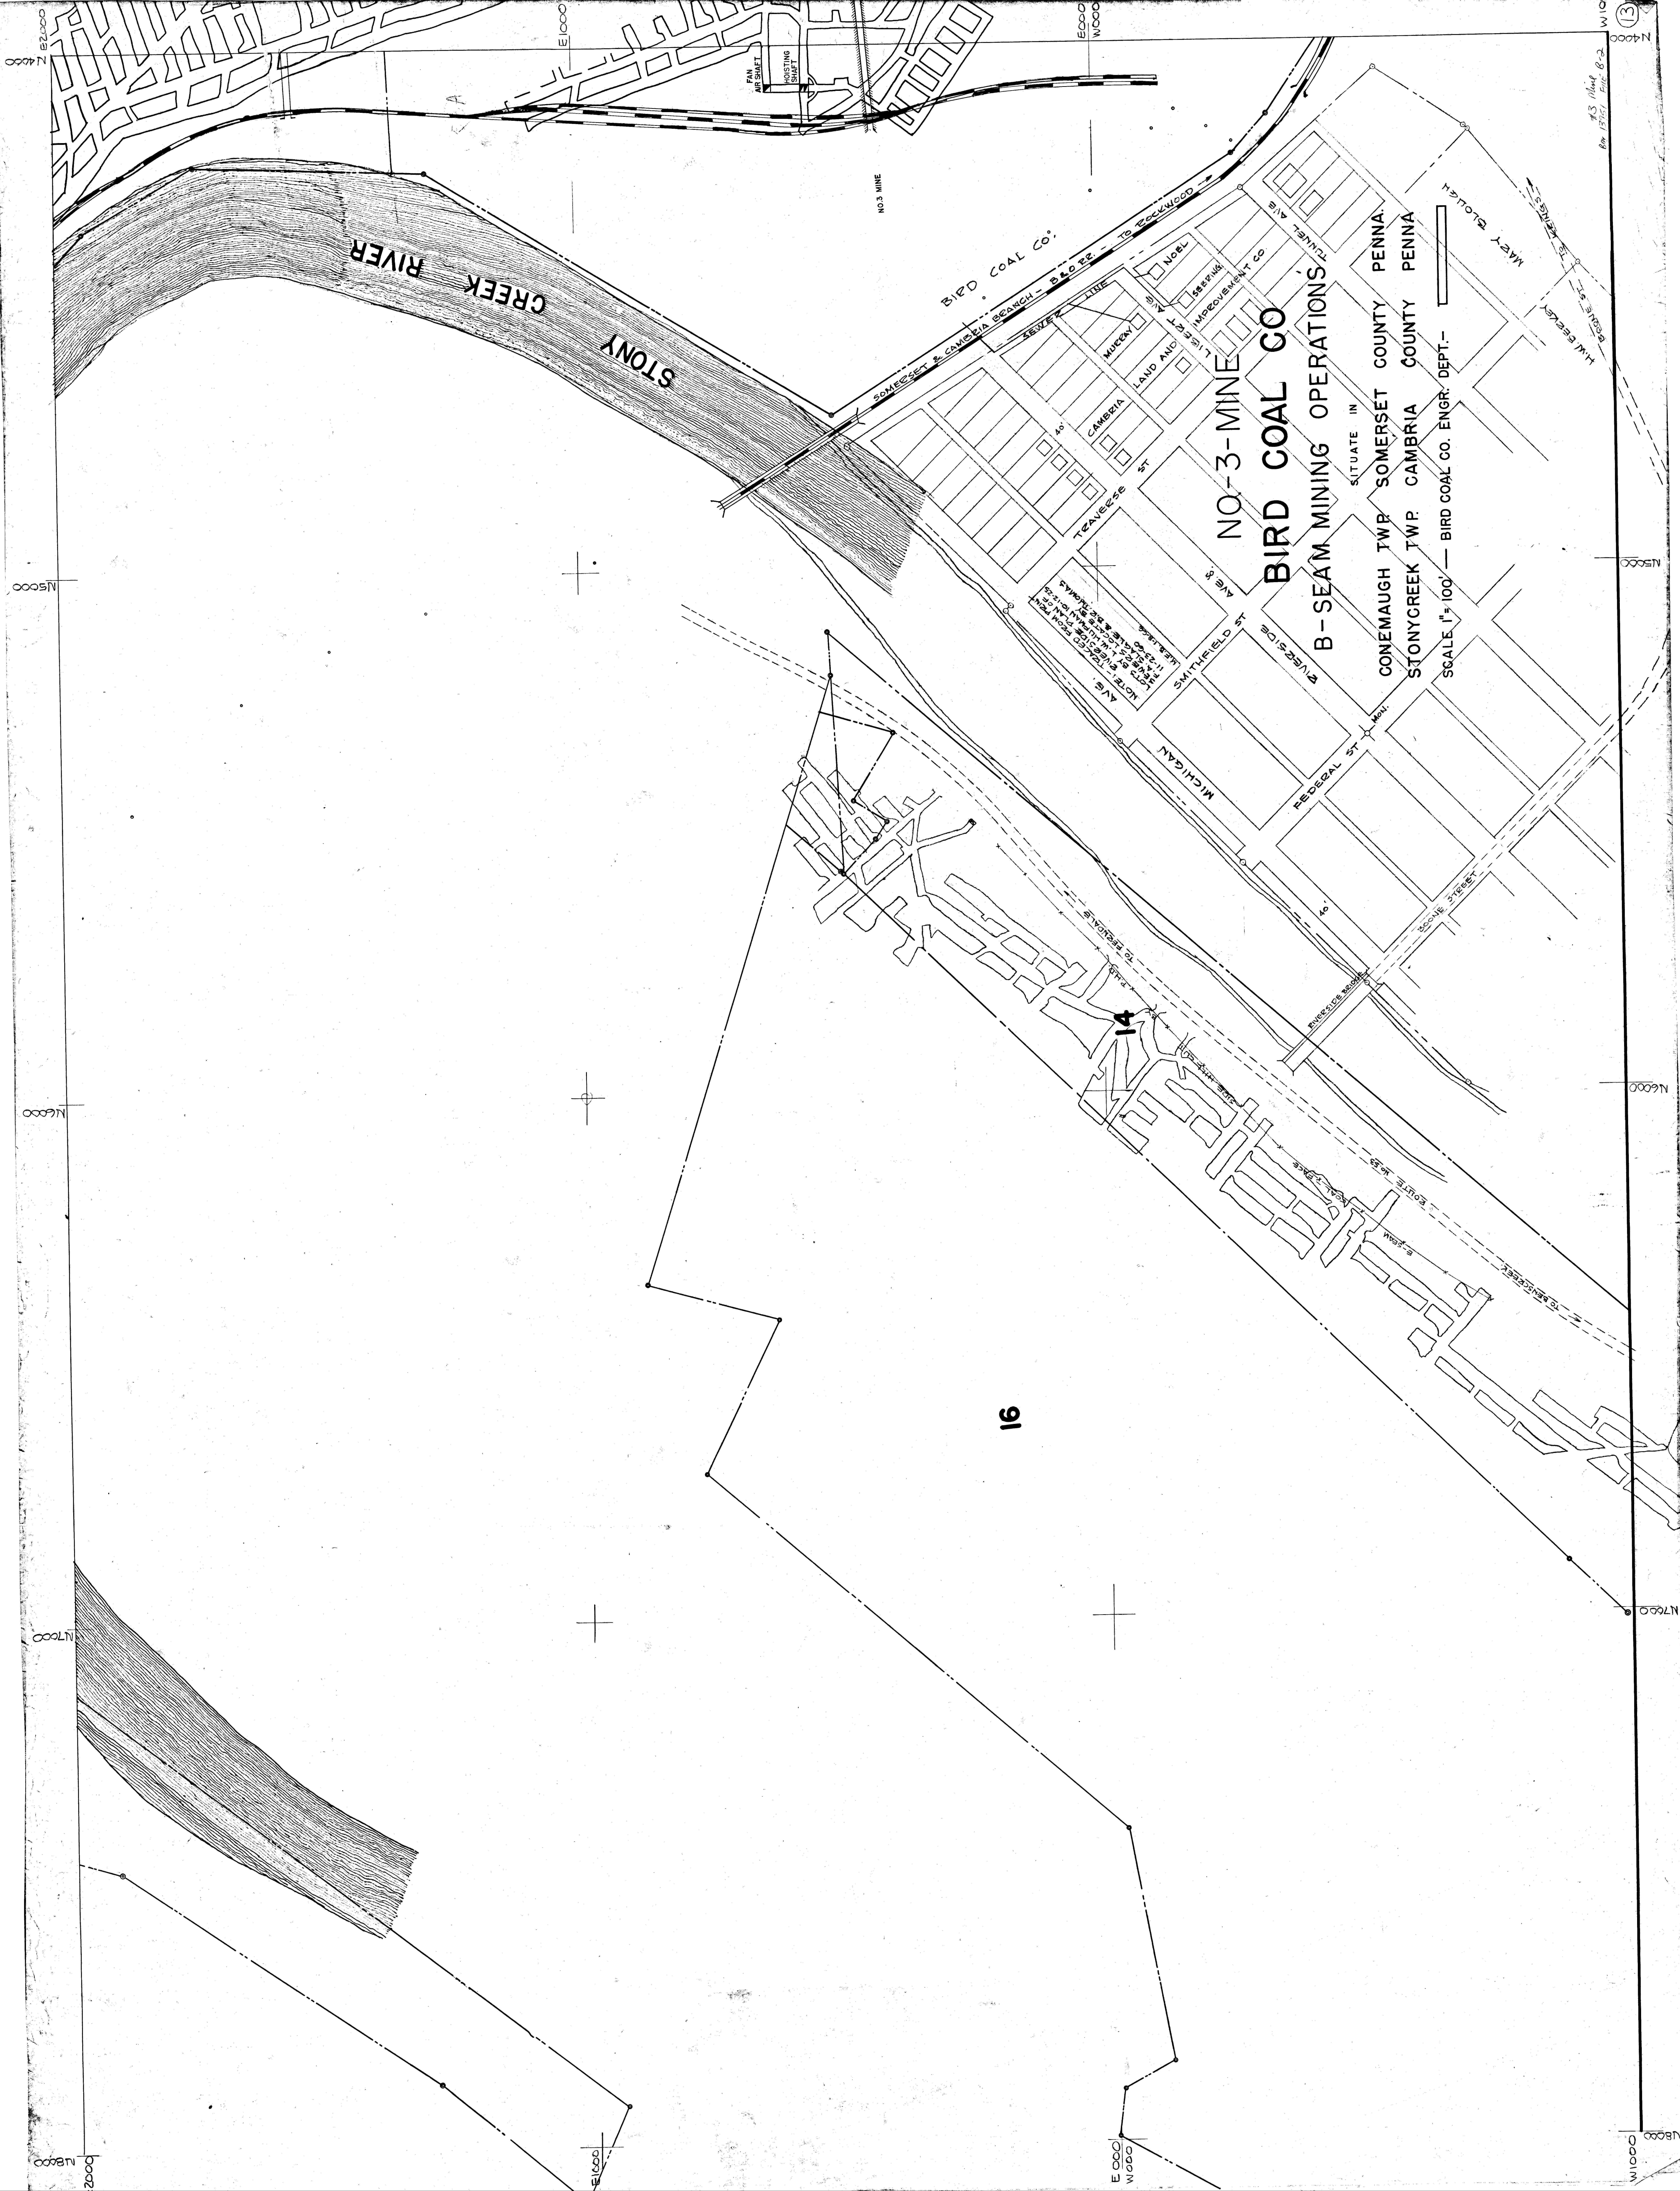

NO-3-MINE
BIRD COAL CO
B-SEAM MINING OPERATIONS

SITUATE IN
CONEMAUGH TWP SOMERSET COUNTY PENNA.
STONYCREEK TWP CAMBRIA COUNTY PENNA.
SCALE 1"=100' — BIRD COAL CO. ENGR. DEPT. —

16

