


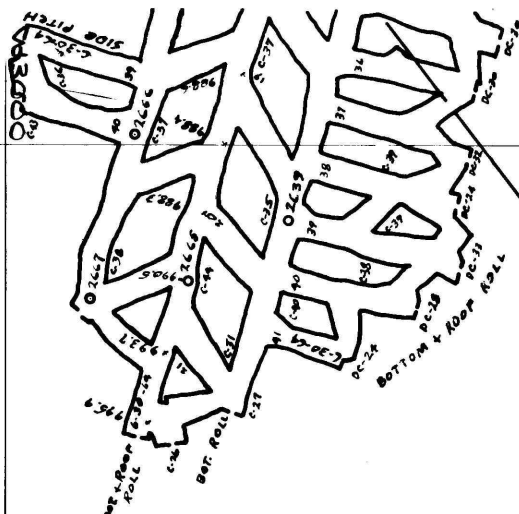

④

N 4000

N 5000

N 6000

N 7000

N 8000

N 3000

N 2000

N 1000

SHEET ④