


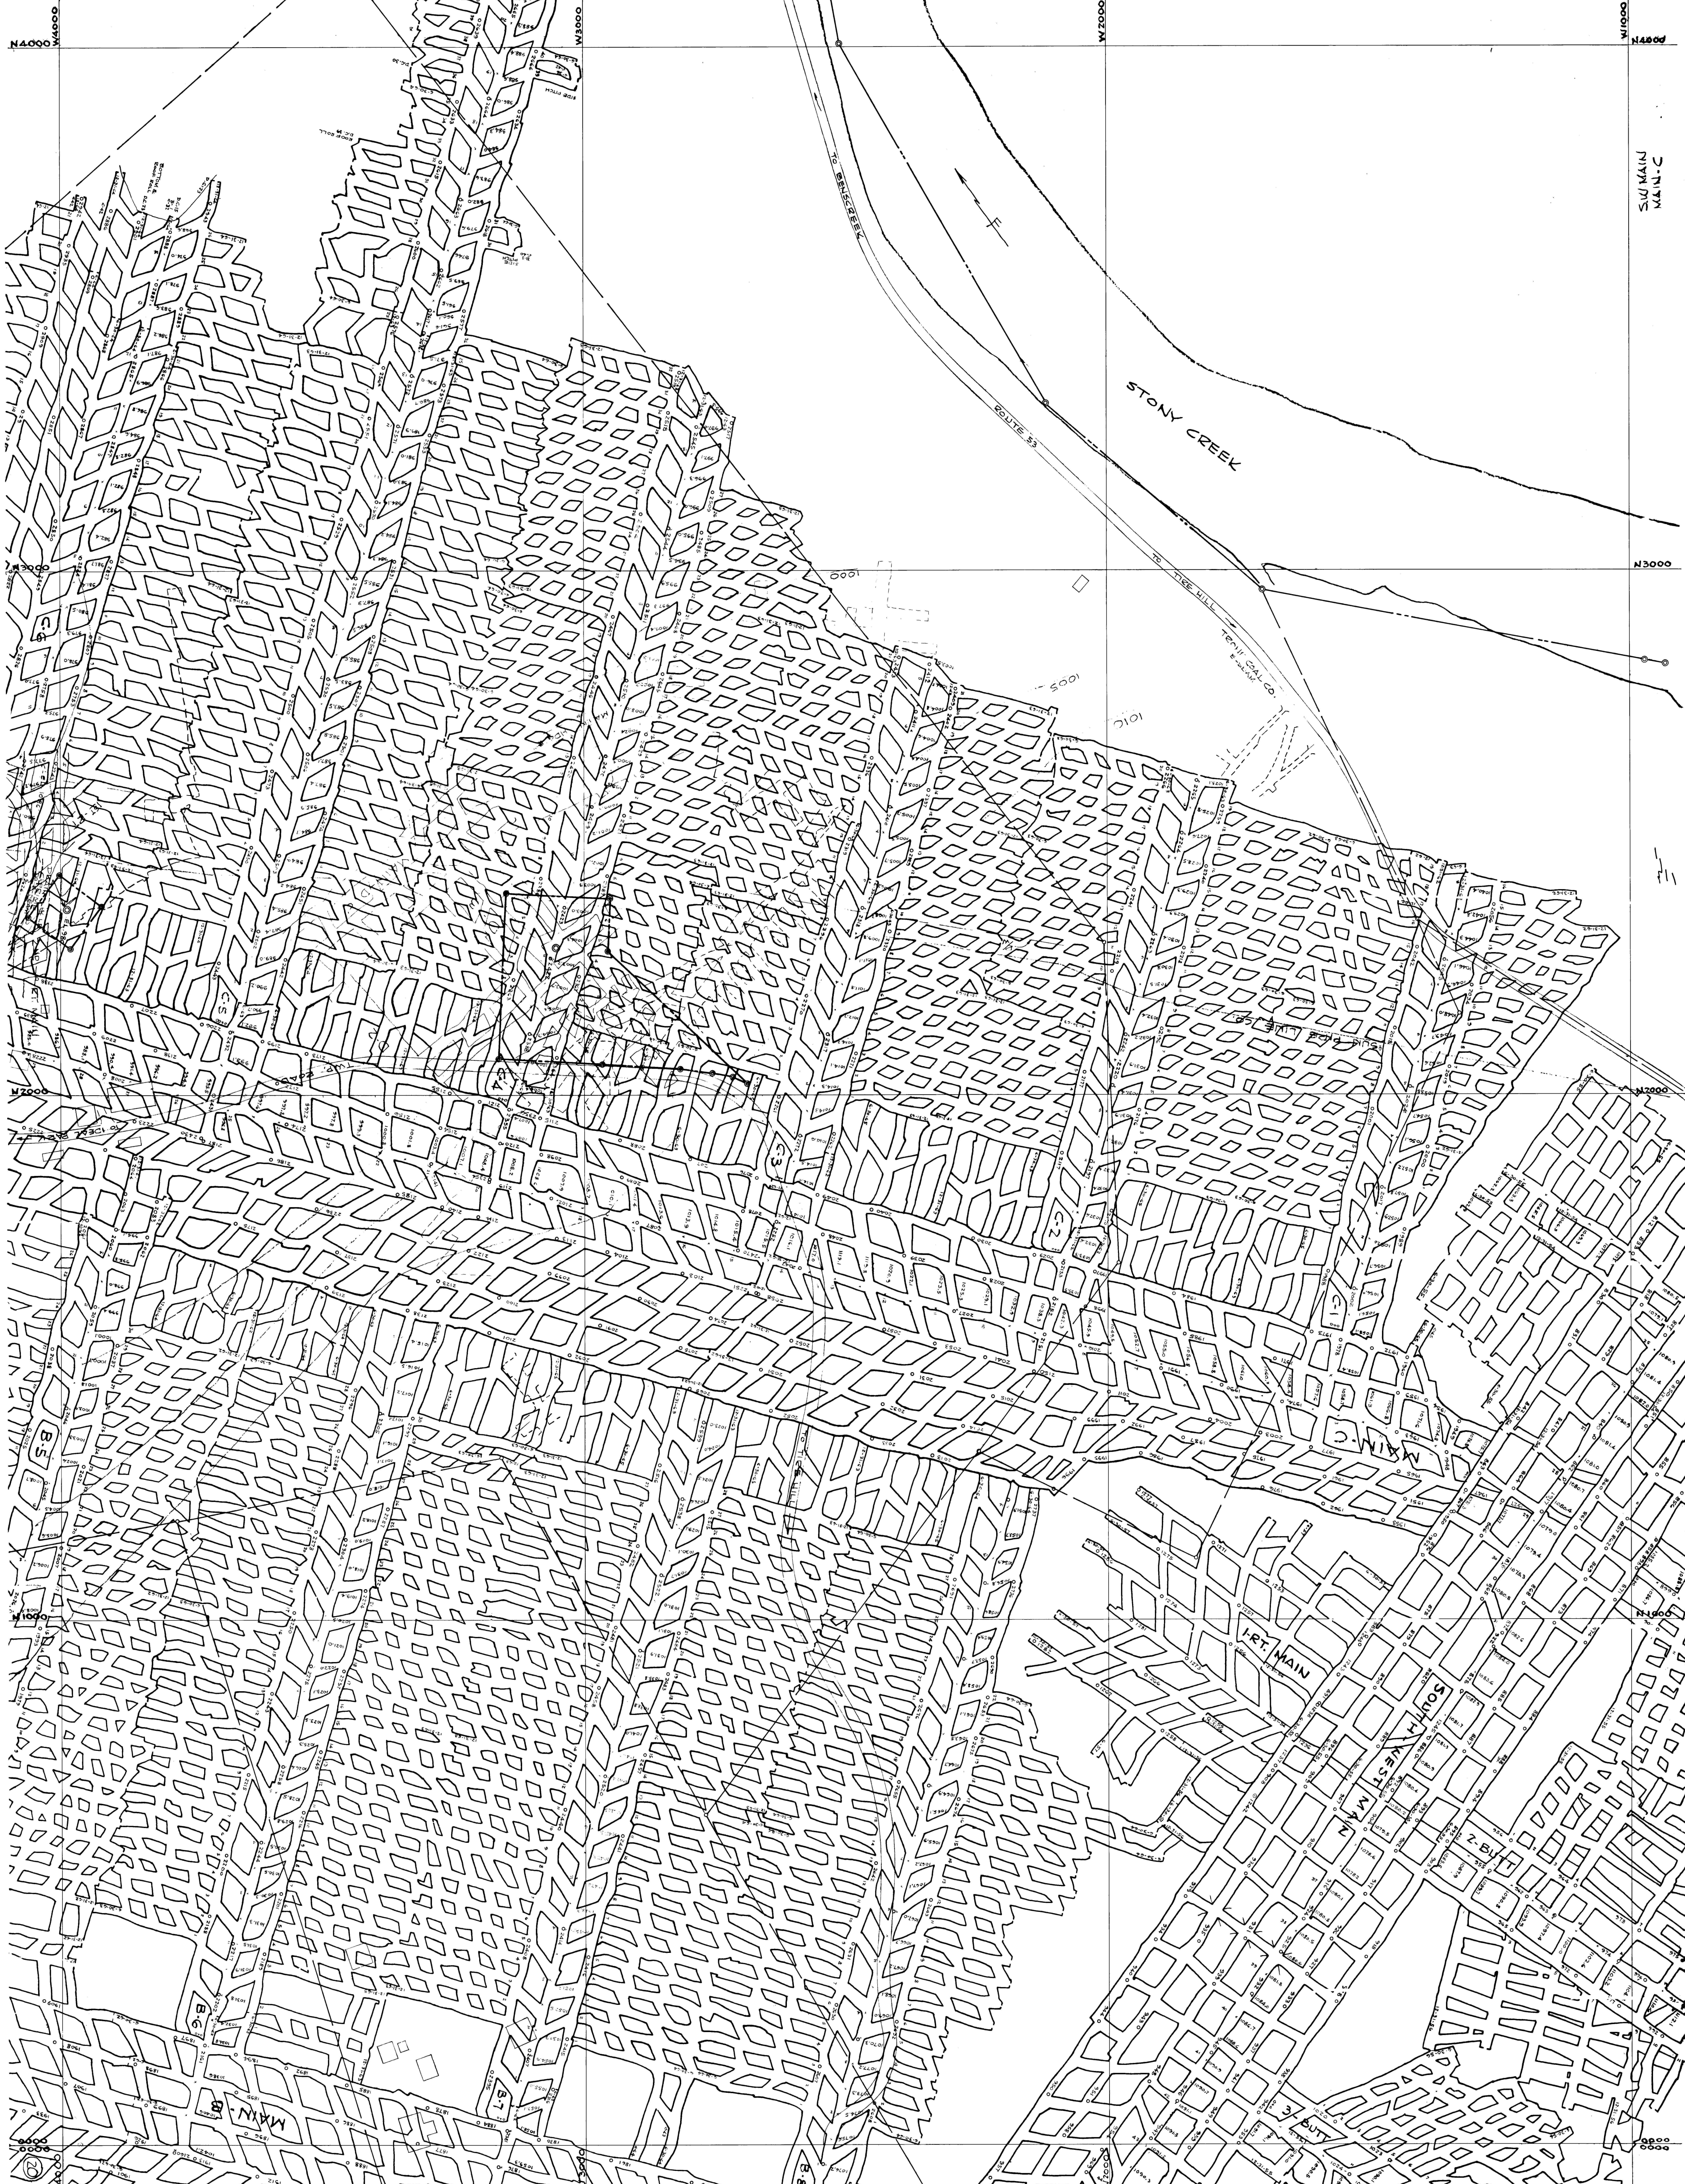

STONY CREEK

ROUTE 53


TO TREE HILL

TO TOWN

1ST MAIN

SOUTH WEST MAIN

3RD BUT

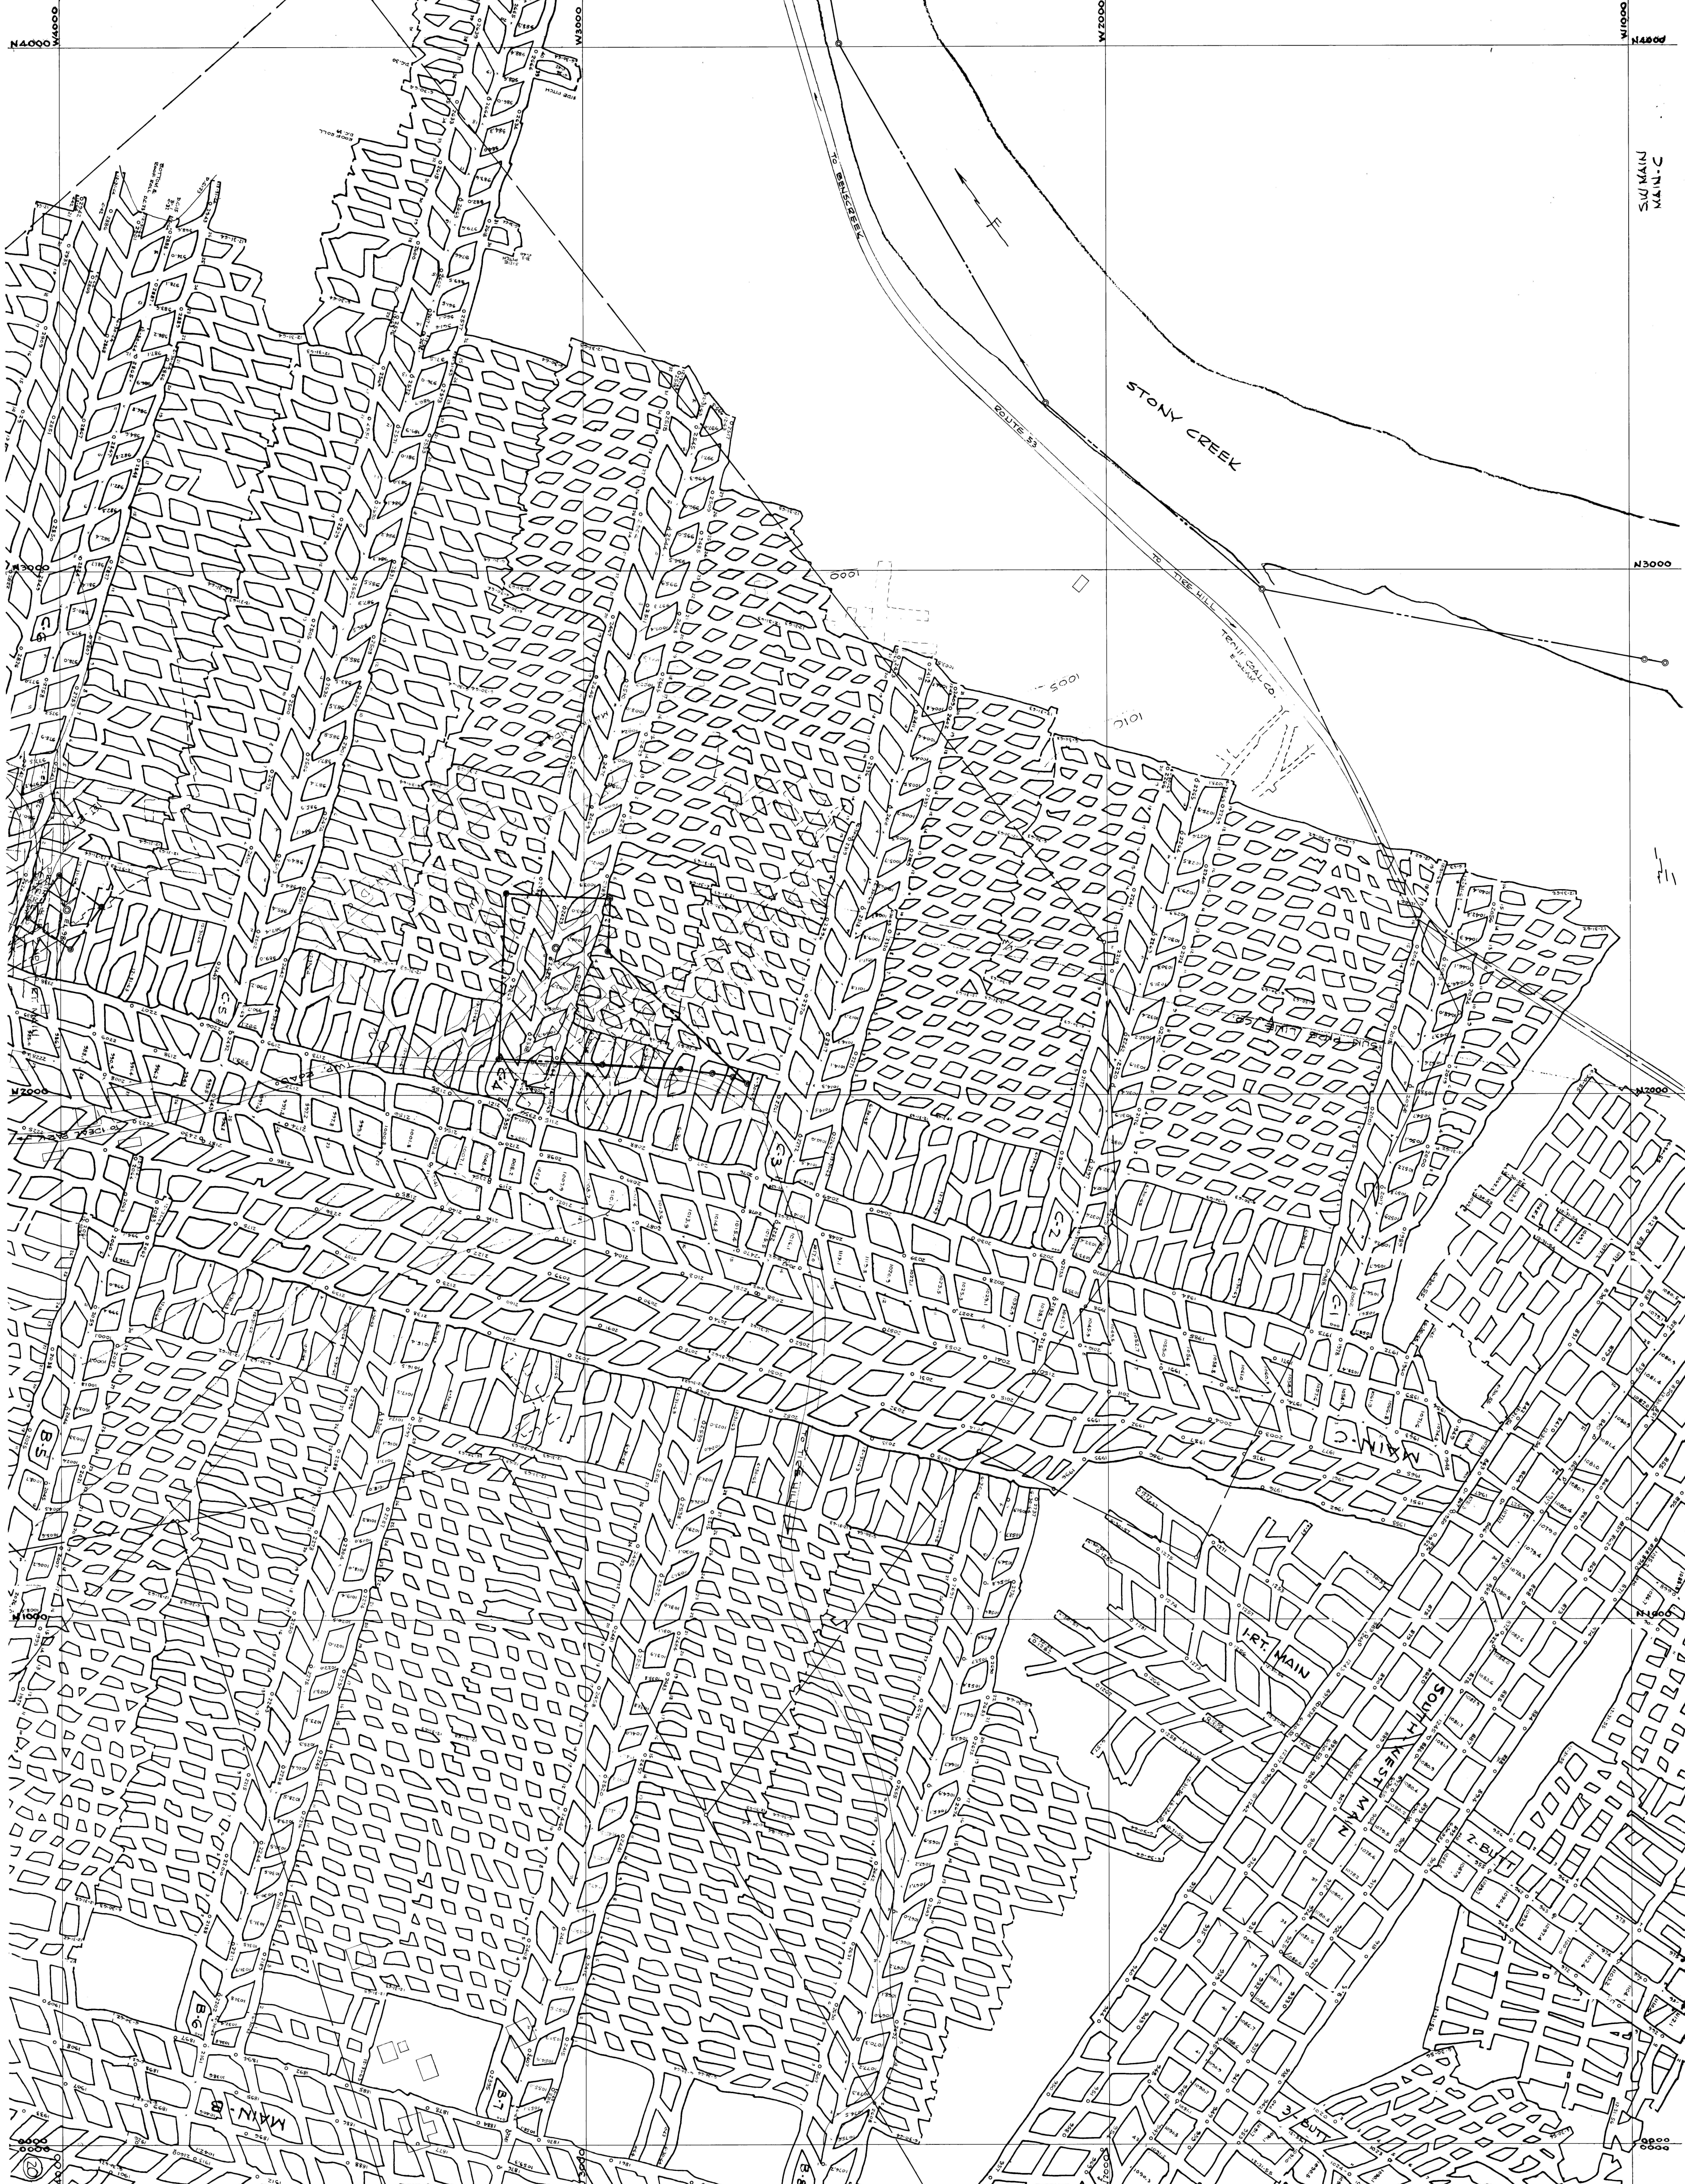

STONY CREEK

ROUTE 53

TO TREE HILL

TO TOWN

1ST MAIN

SOUTH WEST MAIN

3RD BUT