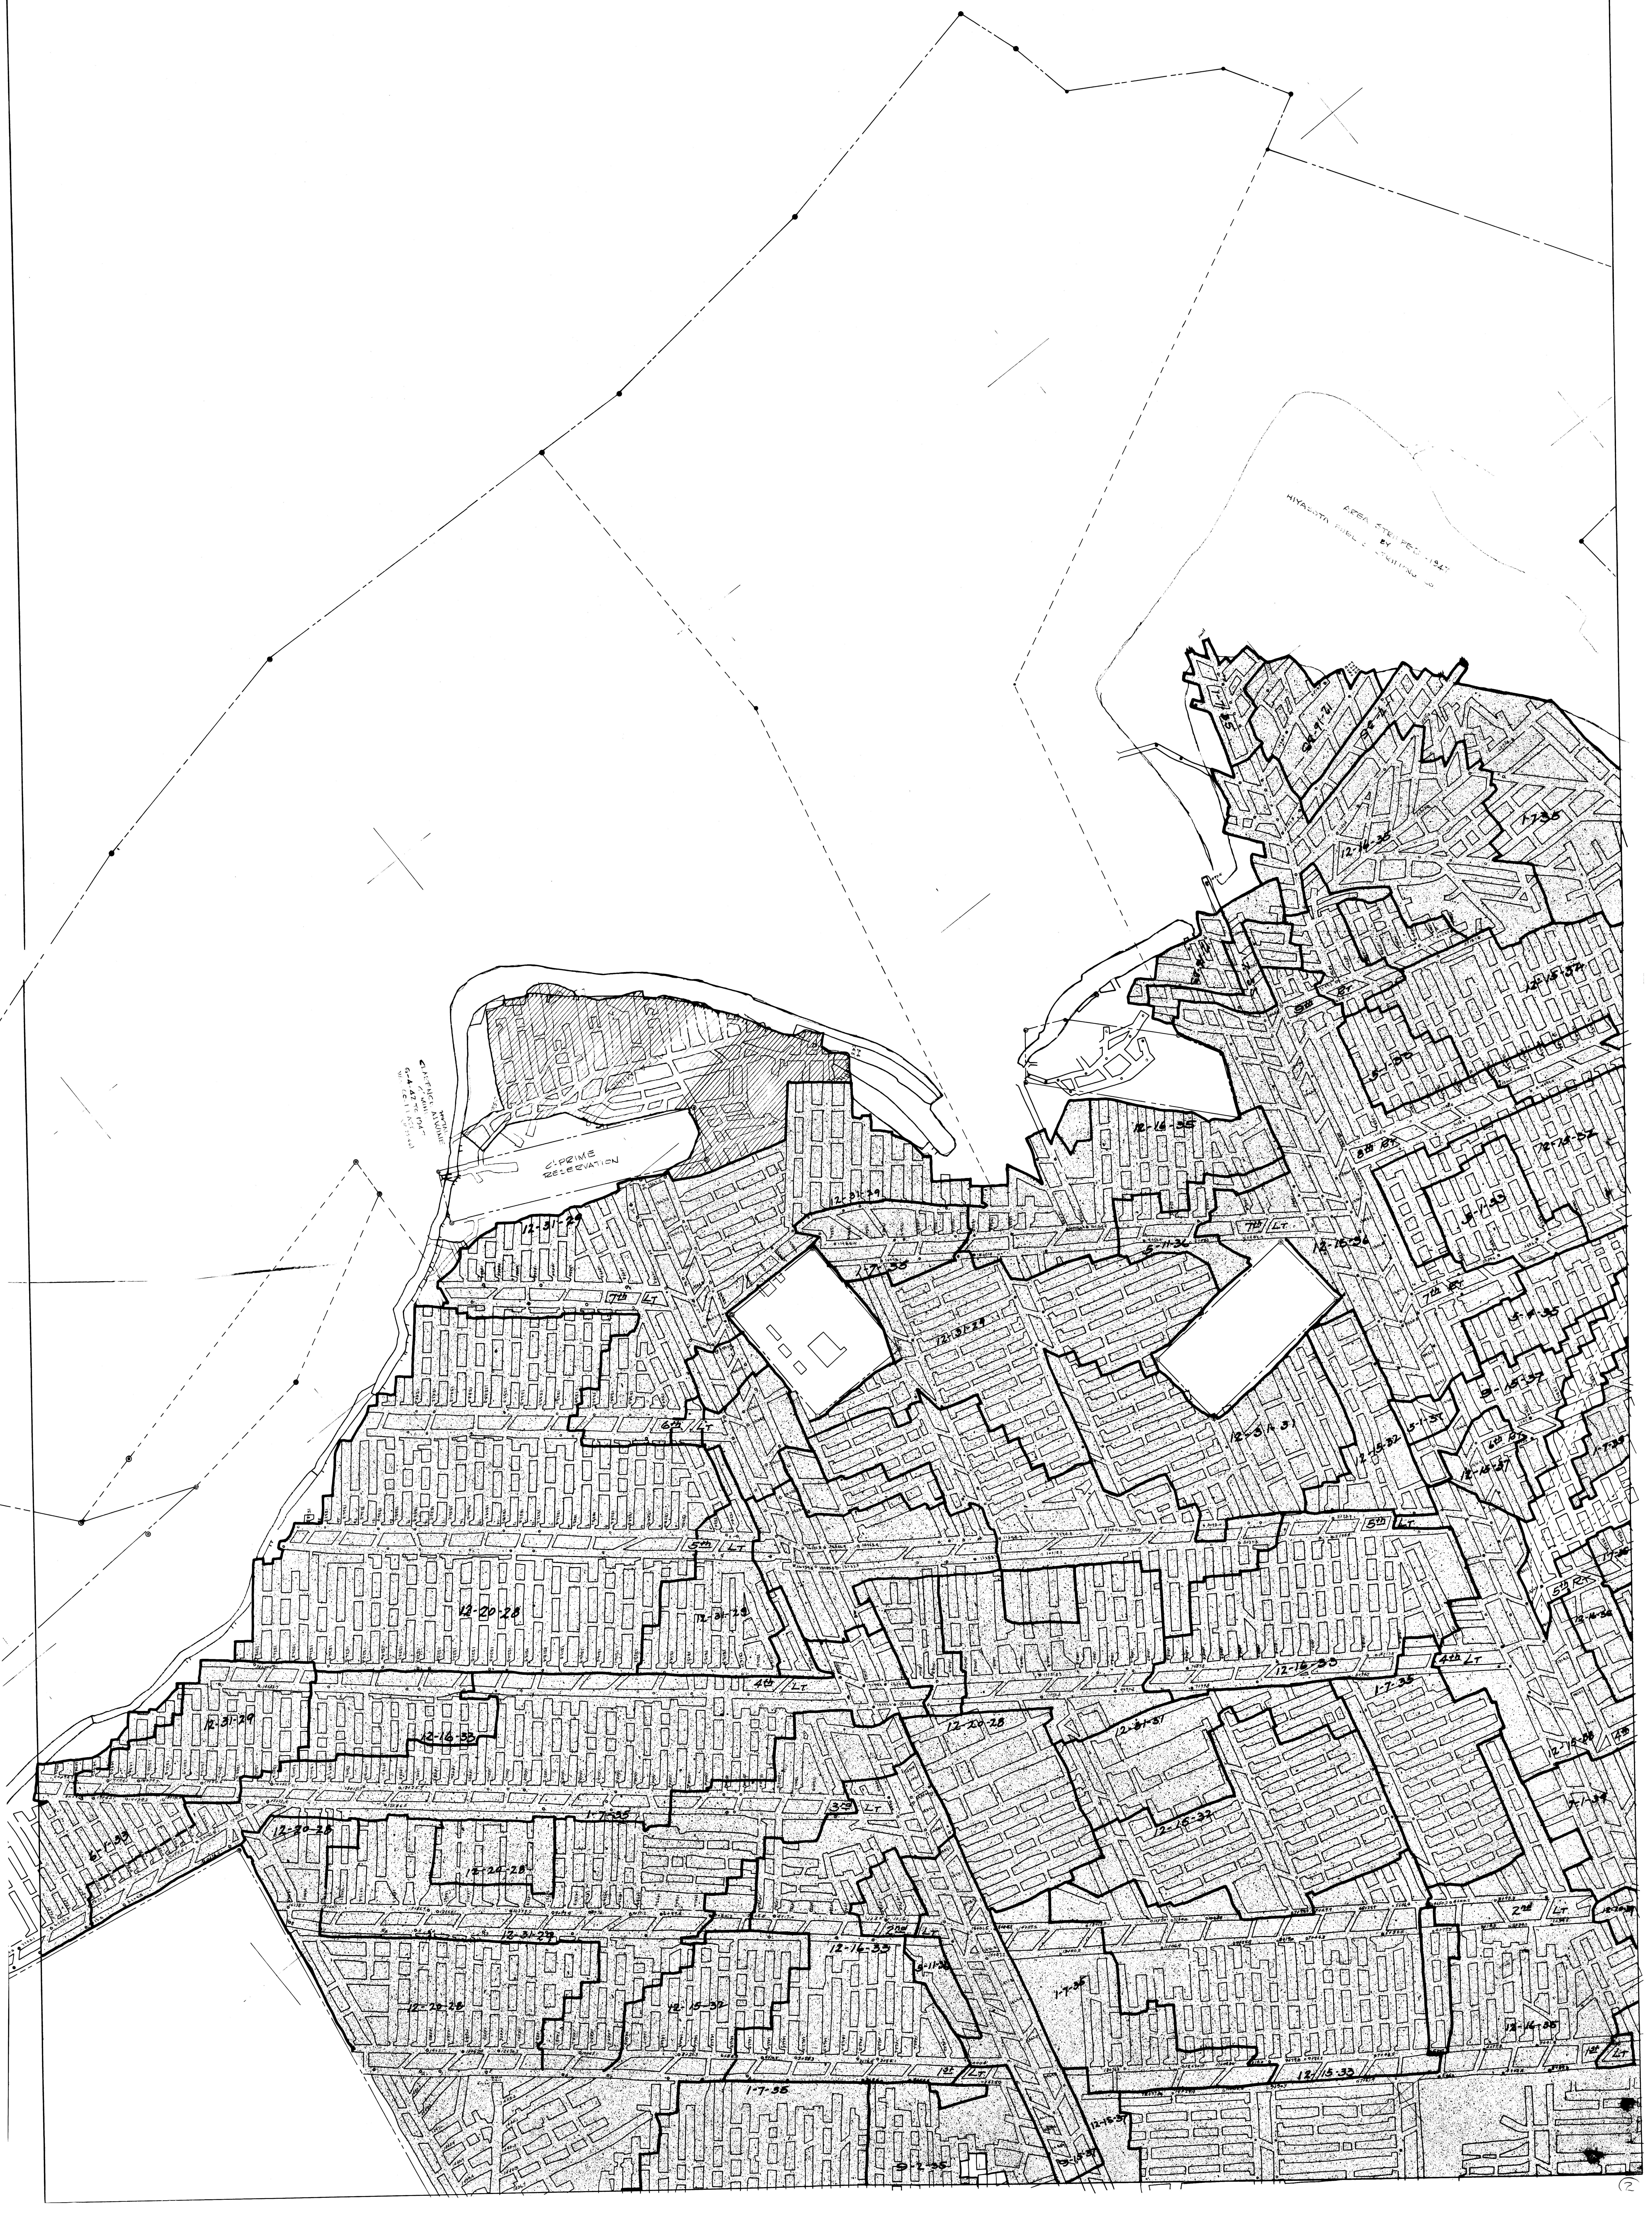
AREA STRIPPED 1947
BY
HIYASOTA FUEL & STRIPPING CO.
C. PRIME RESERVATION
12-31-29
12-20-28
12-16-33
1-7-35
12-15-32
12-24-28
12-31-31
12-3-31
5-11-36
12-15-36
7-7-35
12-16-35
12-14-35
12-29-21
1st LT
2nd LT
3rd LT
4th LT
5th LT
6th LT
7th LT
8th Bt