
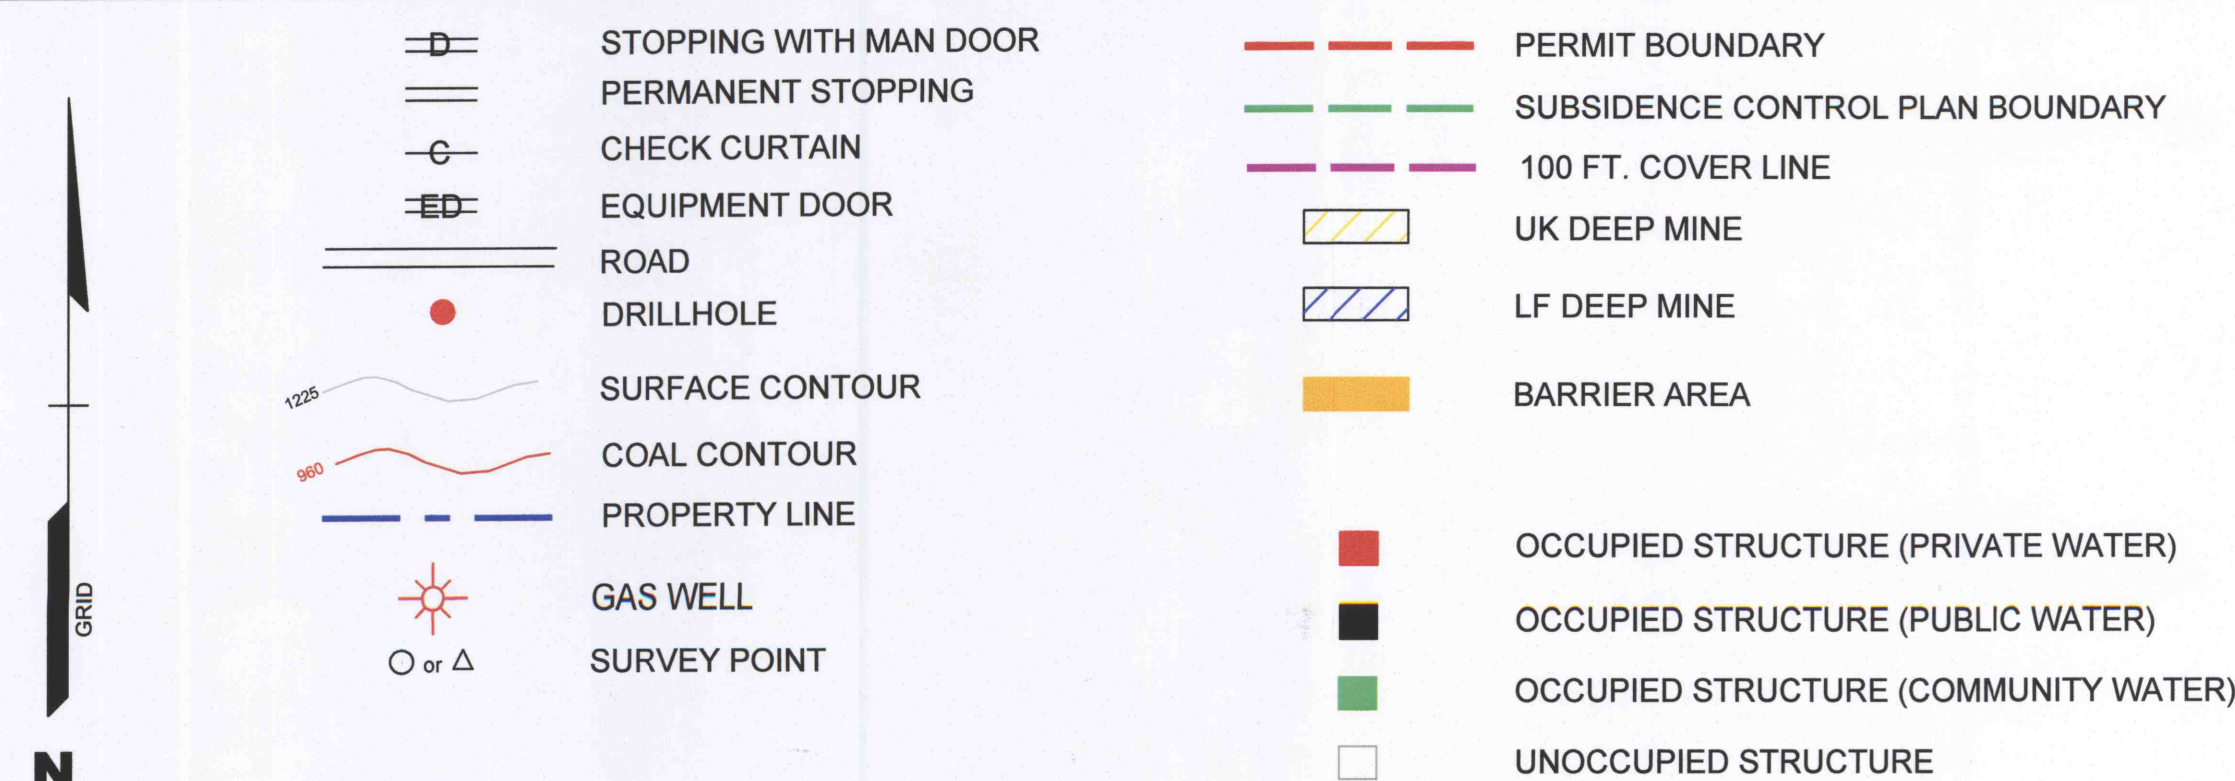


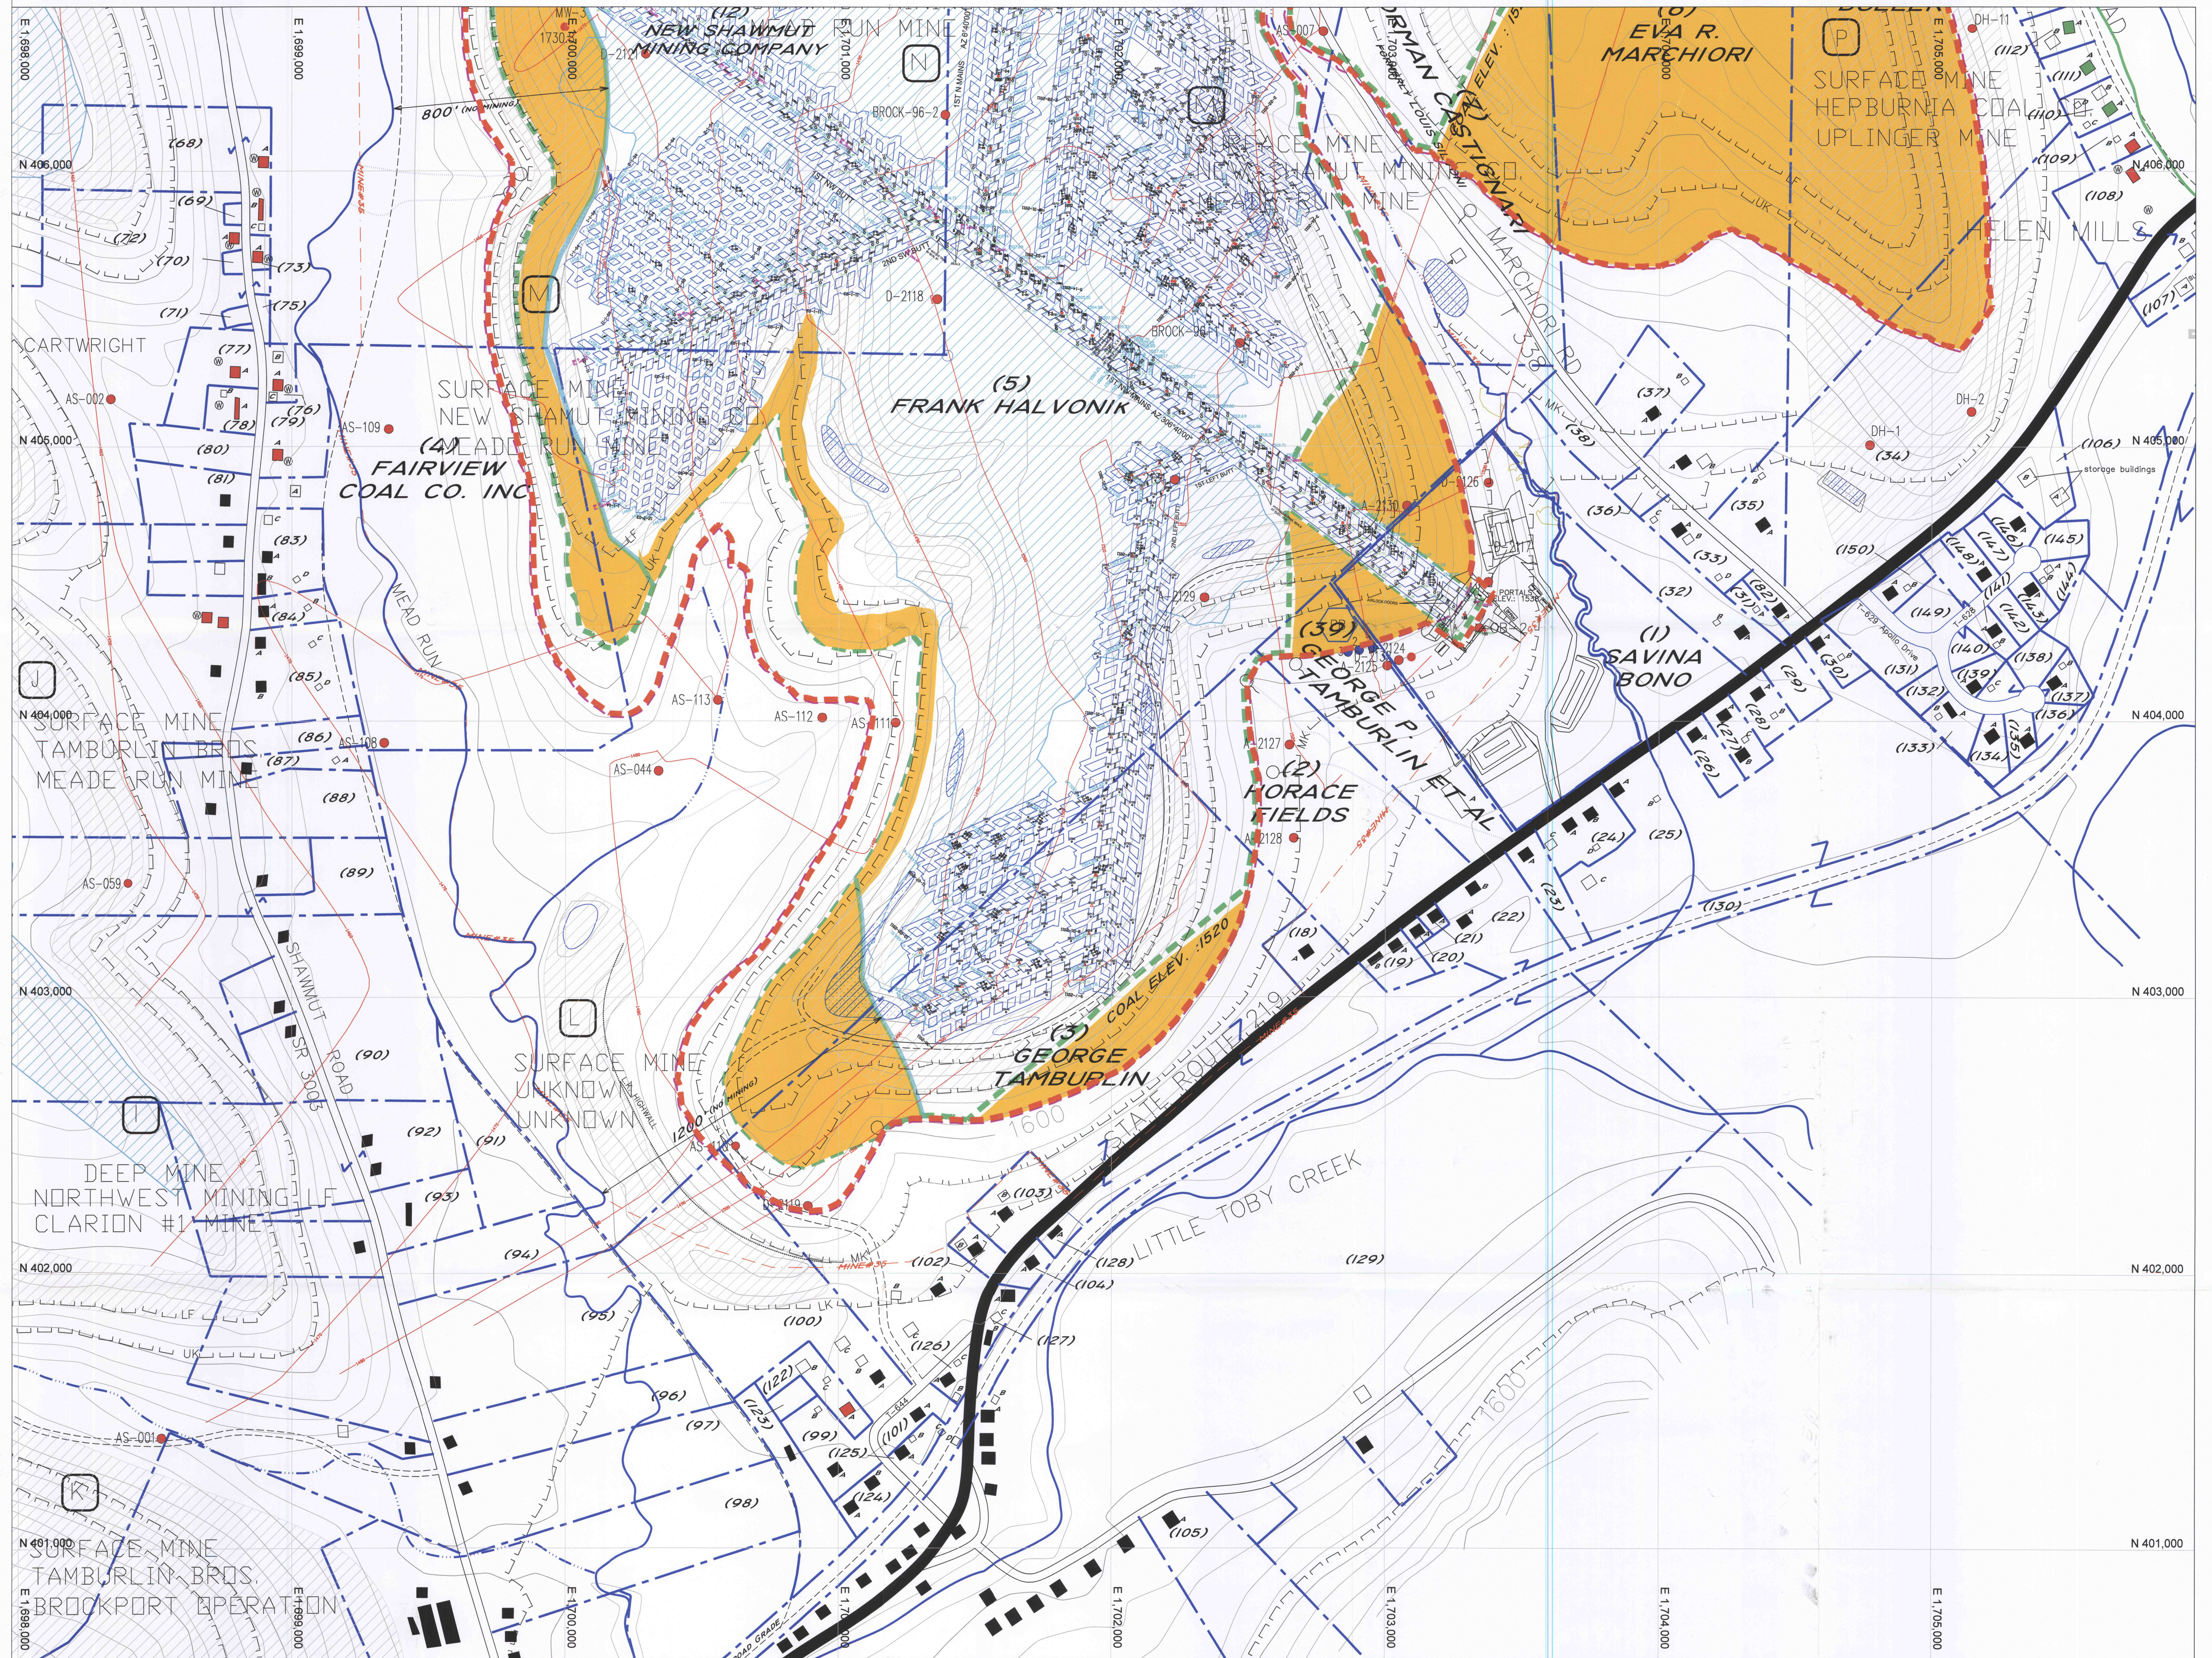

MINES #34 PERMIT LIMIT ENERGY RESOURCES INC.
MINES #35 PERMIT LIMIT ENERGY RESOURCES INC.

MINES IN THE SAME SEAM, OVERLYING SEAMS AND UNDERLYING SEAMS WHICH ARE WITHIN 1000 FT. OF EXISTING AND PROJECTED MINING ARE SHOWN ON THIS MAP.

INTERVAL BETWEEN UF & LK SEAMS APPROX 210'

Datum: PA State Plane Coordinate System, North Zone, NAD 83
NAVD88


I certify that to the best of my knowledge that this final map of the Little Toby Mine is an accurate representation of the limits and workings of the Little Toby Mine and is indeed the true "FINAL MAP"



Theodore J. Bearer, Jr., PLS

Date: 12/1/12


I certify that to the best of my knowledge that this final map of the Little Toby Mine is an accurate representation of the limits and workings of the Little Toby Mine and is indeed the true "FINAL MAP"

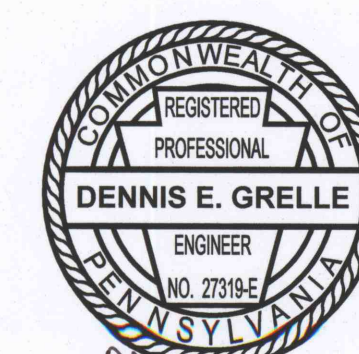

Dennis E. Grelle, PE Manager of Engineering

Date: _____

SHEET INDEX

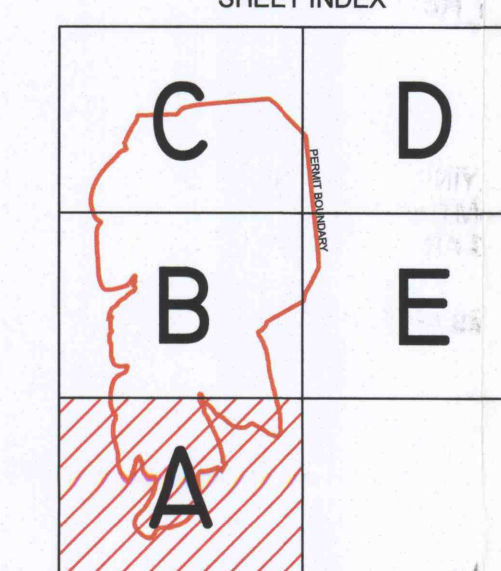Rosebud Mining Company

LITTLE TOBY MINE

Final Mine Map

Lower Kittanning Coal Seam

Horton Township, Elk County, PA

ID No. 36 08847 CMAP No. 24991301

Scale: 1 in. = 200 ft.