

- | | | | | | |
|--|------------------------|--|--------------------------------------|--|------------------------------------|
| | STOPPING WITH MAN DOOR | | PERMIT BOUNDARY | | PERMIT LIMIT ENERGY RESOURCES INC. |
| | PERMANENT STOPPING | | SUBSIDENCE CONTROL PLAN BOUNDARY | | PERMIT LIMIT ENERGY RESOURCES INC. |
| | CHECK CURTAIN | | 100 FT. COVER LINE | | |
| | EQUIPMENT DOOR | | UK DEEP MINE | | |
| | ROAD | | LF DEEP MINE | | |
| | DRILLHOLE | | BARRIER AREA | | |
| | SURFACE CONTOUR | | | | |
| | COAL CONTOUR | | | | |
| | PROPERTY LINE | | | | |
| | GAS WELL | | OCCUPIED STRUCTURE (PRIVATE WATER) | | |
| | SURVEY POINT | | OCCUPIED STRUCTURE (PUBLIC WATER) | | |
| | | | OCCUPIED STRUCTURE (COMMUNITY WATER) | | |
| | | | UNOCCUPIED STRUCTURE | | |
- Datum: PA State Plane Coordinate System, North Zone, NAD 83
NAVD88

I certify that to the best of my knowledge that this final map of the Little Toby Mine is an accurate representation of the limits and workings of the Little Toby Mine and is indeed the true "FINAL MAP".




Theodore J. Bearor, Jr.
Theodore J. Bearor, Jr., PLS
Date 12/7/12

I certify that to the best of my knowledge that this final map of the Little Toby Mine is an accurate representation of the limits and workings of the Little Toby Mine and is indeed the true "FINAL MAP".



Dennis E. Grelle
Dennis E. Grelle, PE, Manager of Engineering
Date 12/7/12

SHEET INDEX

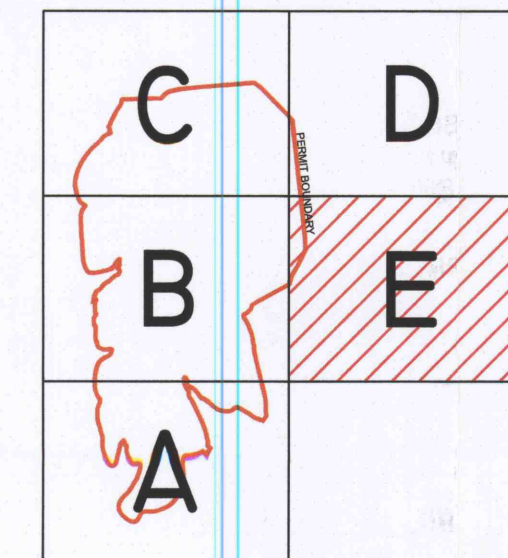

Rosebud Mining Company
LITTLE TOBY MINE
Final Mine Map
Sheet E
Lower Kittanning Coal Seam
Horton Township, Elk County, PA
ID No. 36 08847 CMAP No. 24991301
Scale: 1 in. = 200 ft.