


FIELD COPY
SAMUEL WILLISON
112.54 Acres - surface

CLARK
WILLIAM CLARK COAL COMPANY, INC.
MT. PLEASANT TOWNSHIP - WASHINGTON CO., PA.
COAL LEASED FROM MONTGOMERY LAND COMPANY - LOCATION CO.
OCTOBER 31 - 1966
K-R-DEVER - REGISTERED SURVEYOR
WASHINGTON, PA.
1066-14

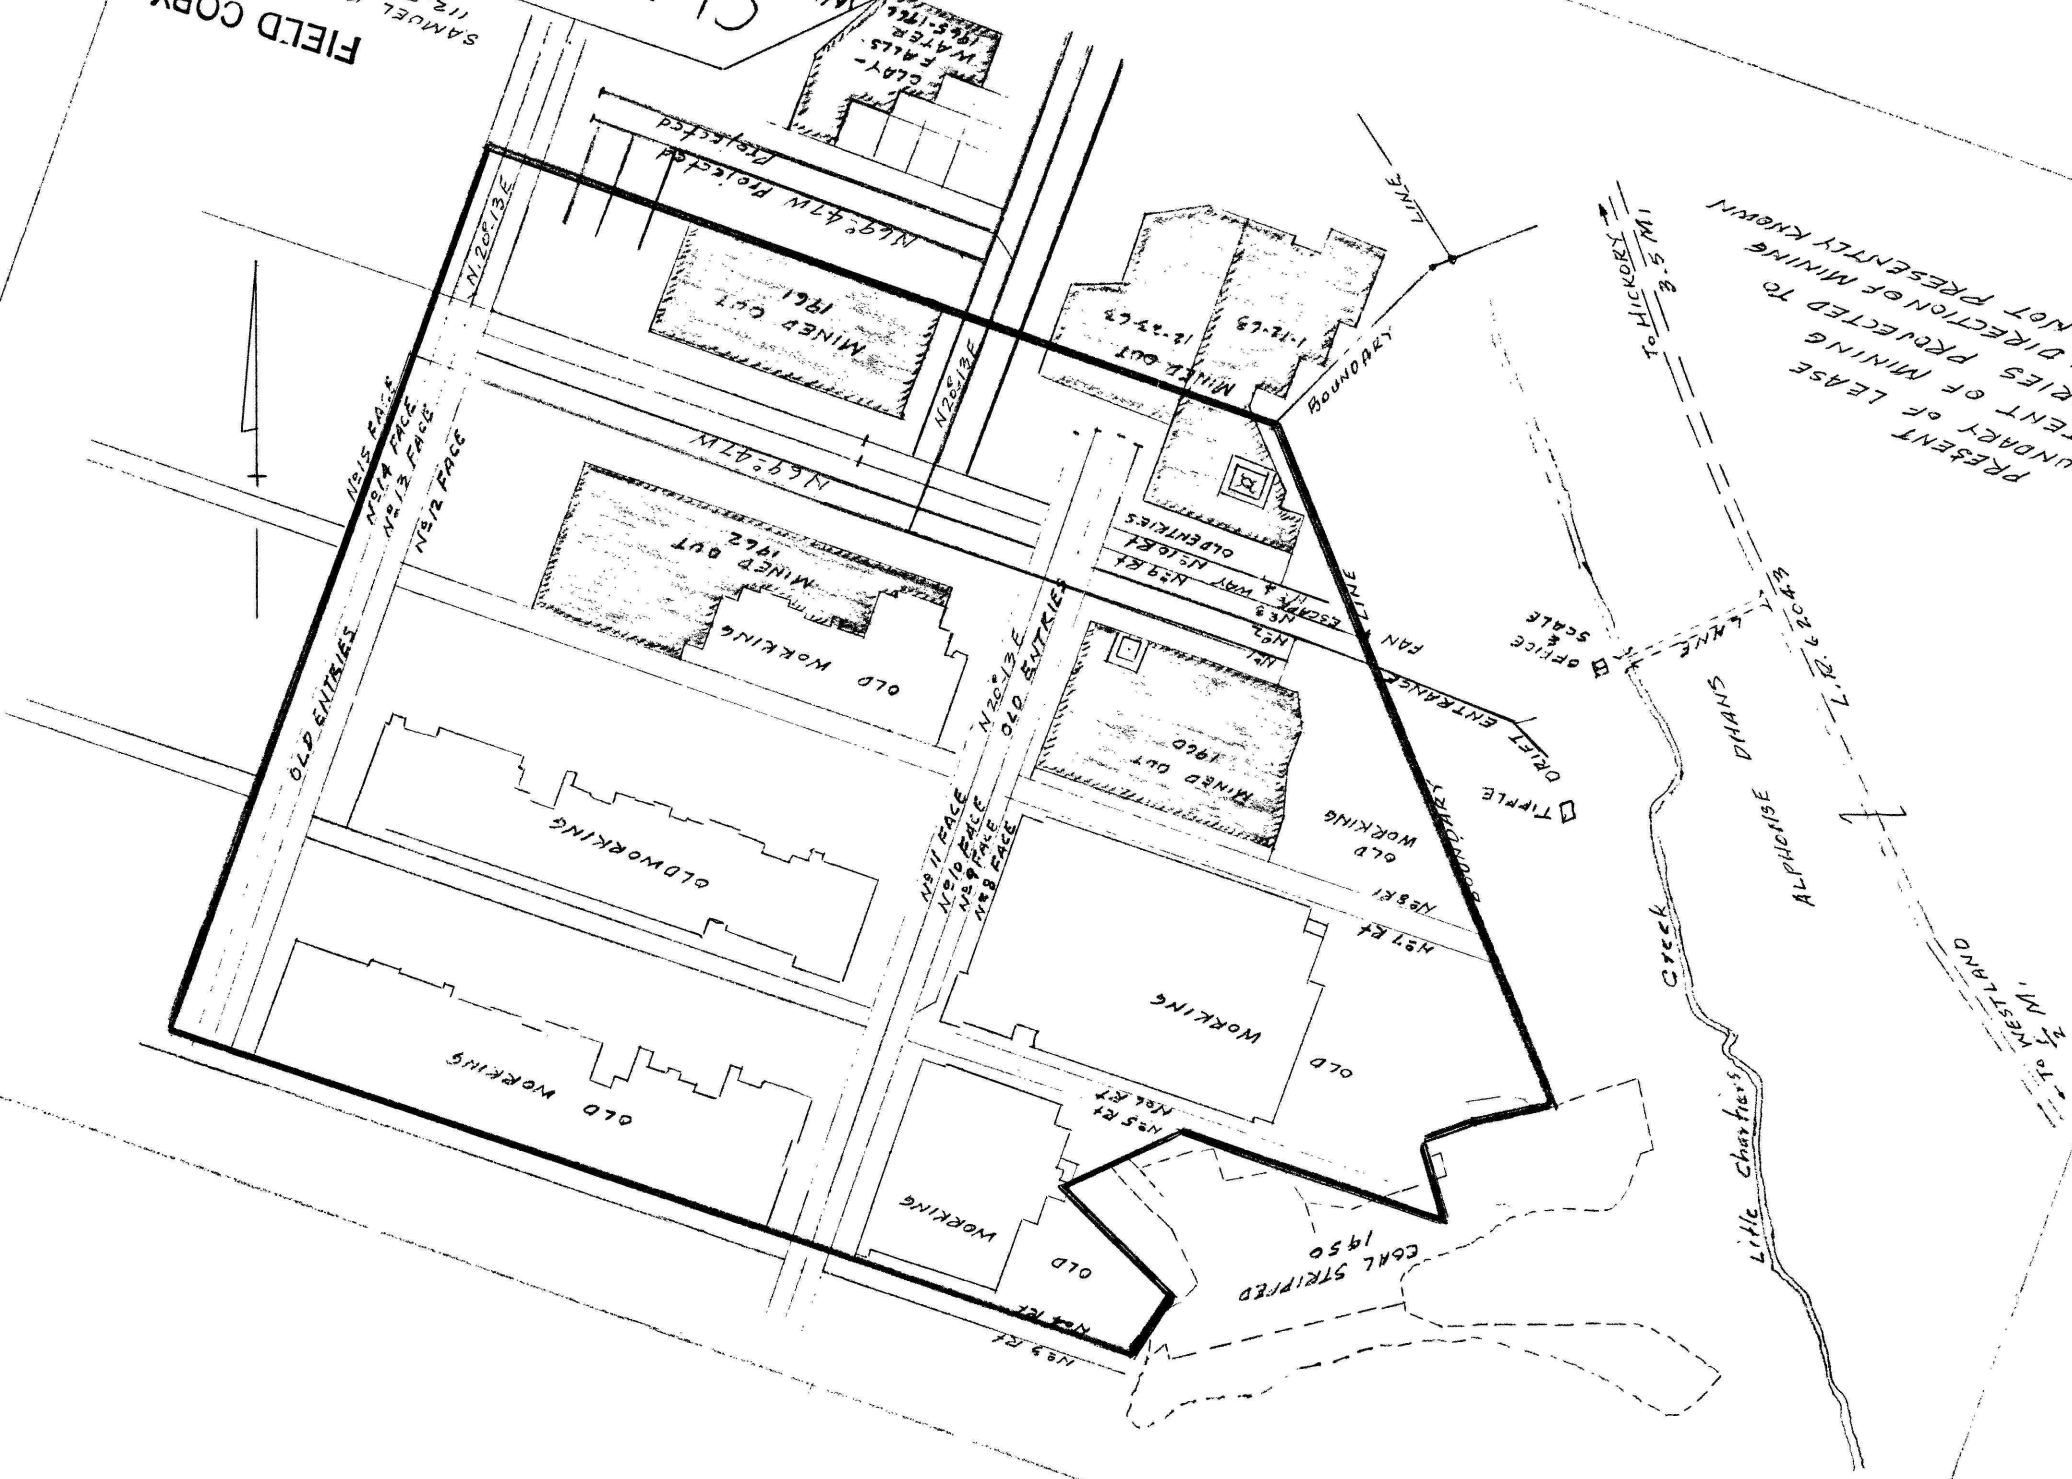

PRESENT OF LEASE
ENTRIES OF MINING
SHOW DIRECTION OF MINING
AREA NOT PRESENTLY KNOWN

TO HICKORY
3.5 MI





