LANDS OF THE

ALTOONA COAL AND COKE CO.

LOGAN TOWNSHIP, BLAIR COUNTY AND GALLITZIN TOWNSHIP, CAMBRIA COUNTY, PENNA.

SCALE:- 1" = 400'

MINE WORKINGS SHOWN TO DATE OF JAN-1ST-1921

JOS. S. SILLYMAN & CO.
ENGINEERS
ALTOONA, PENNA.

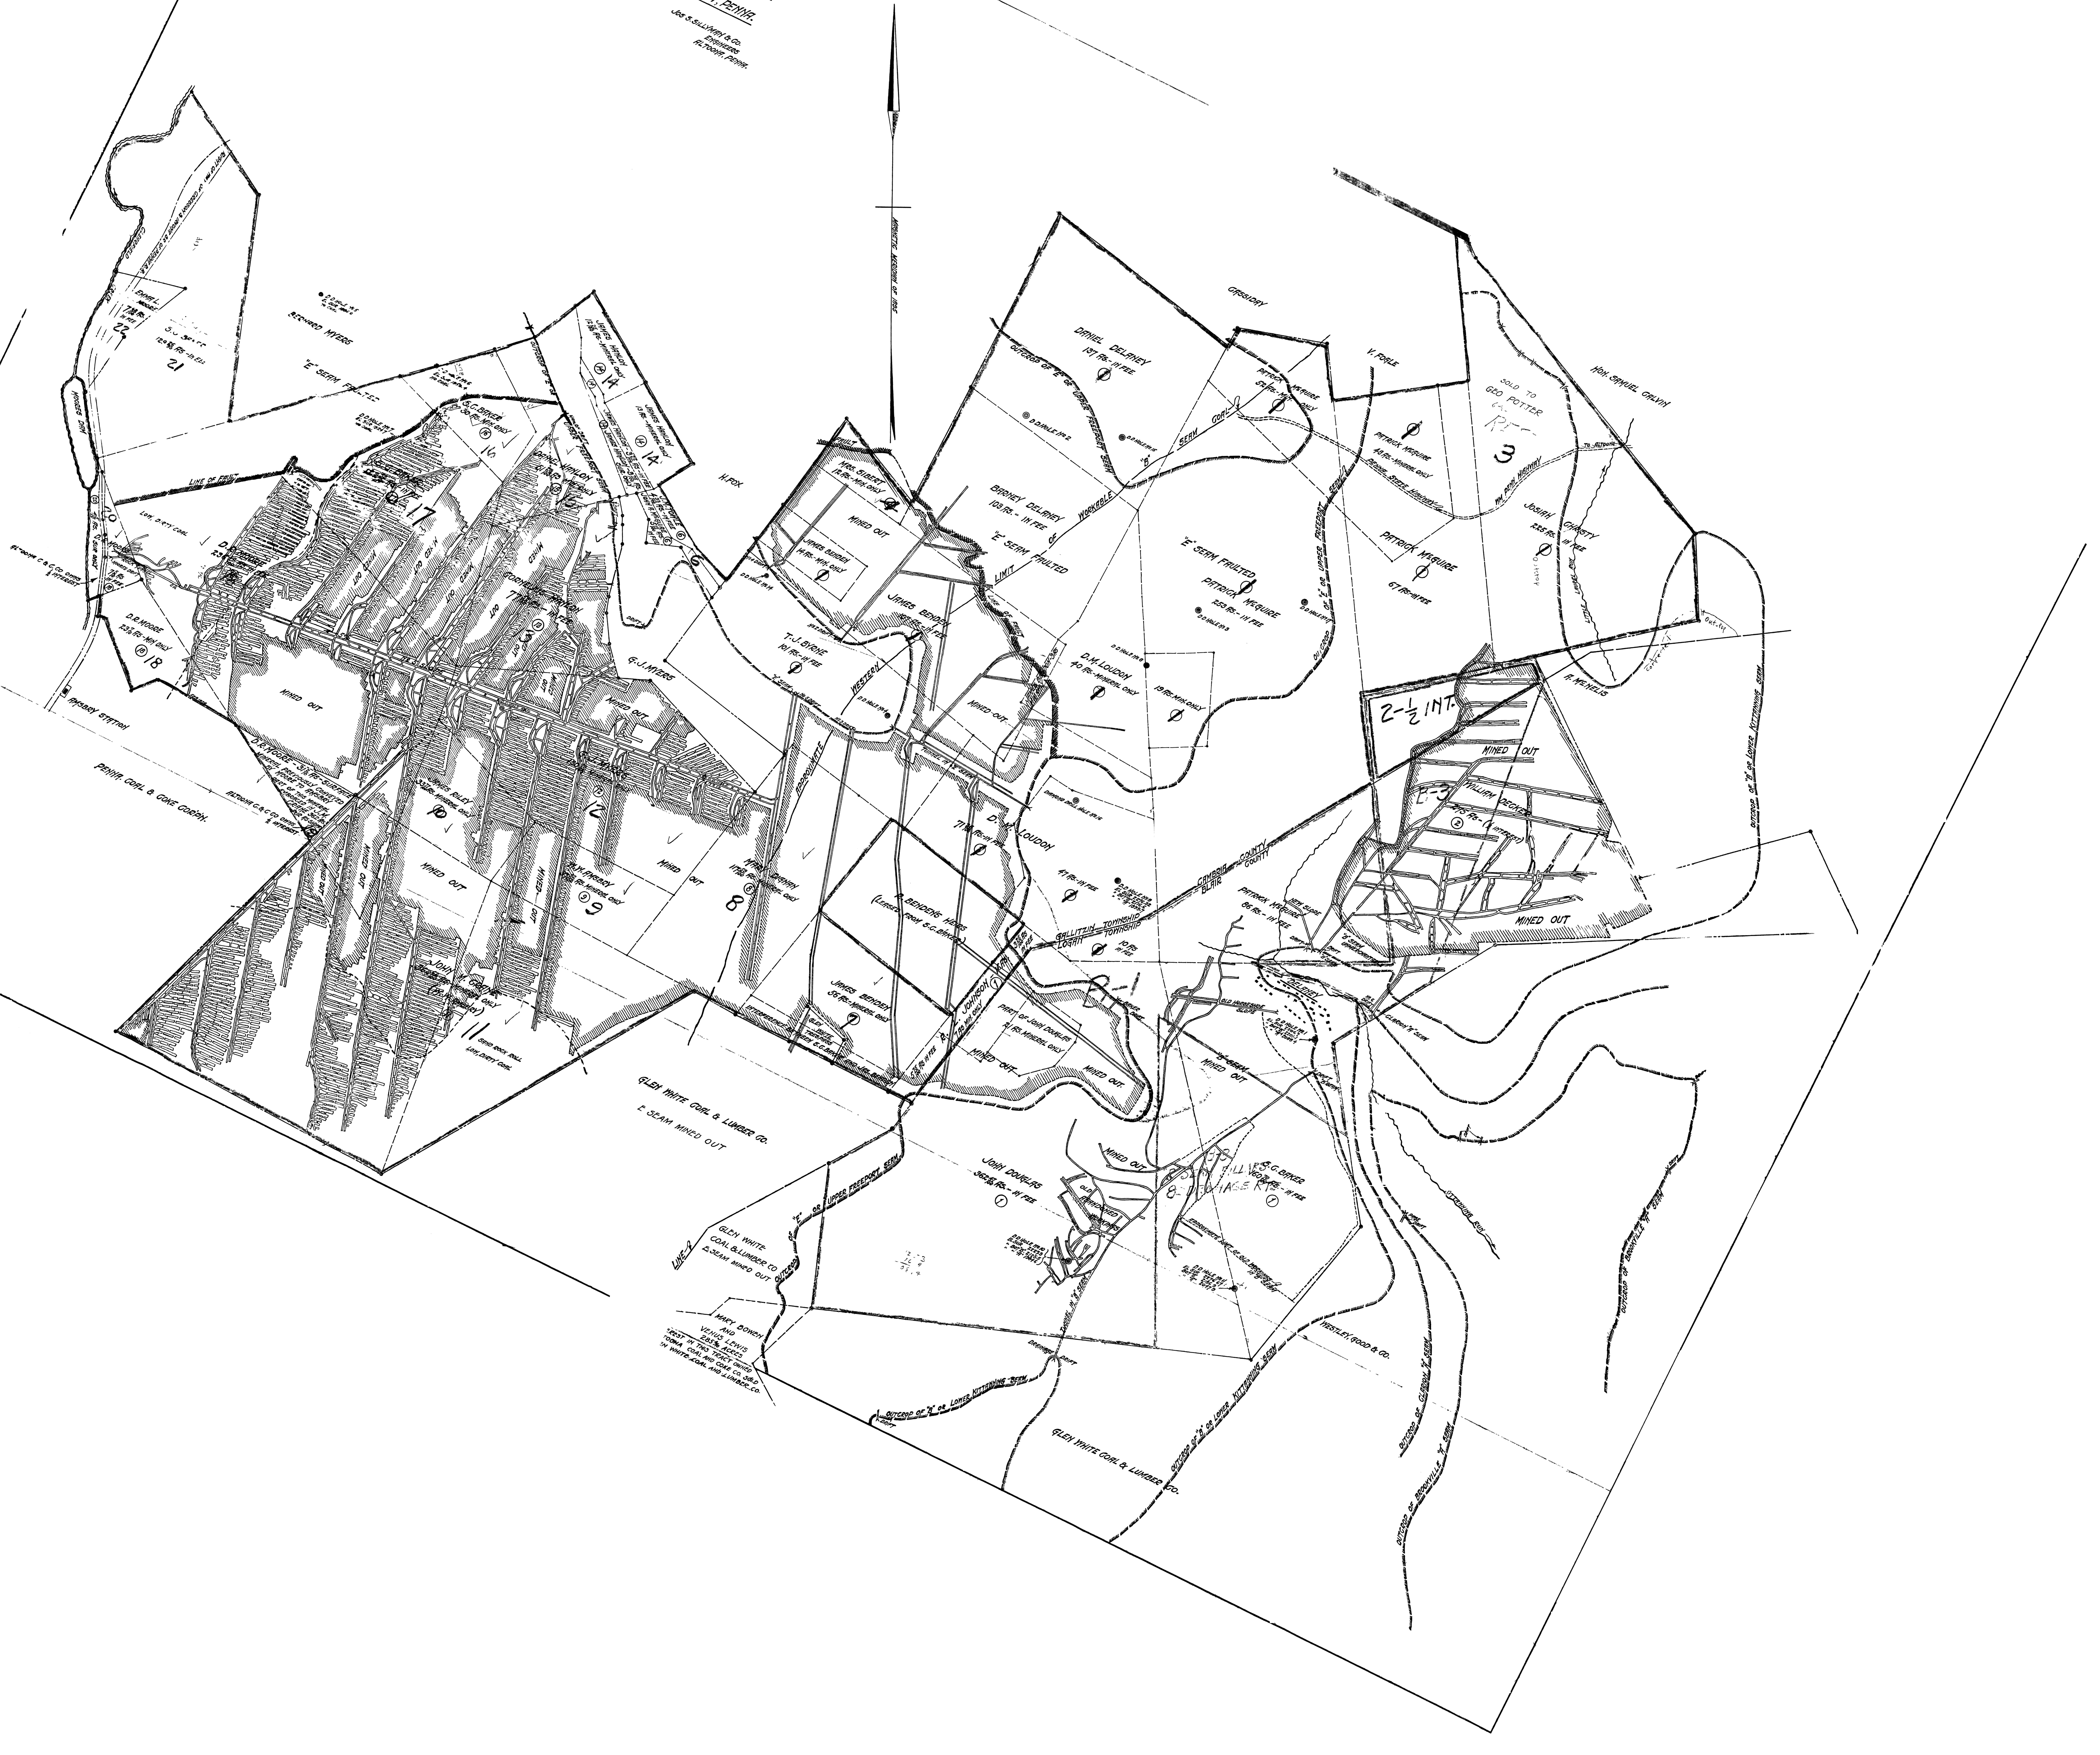

RICHARD MYERS
"E" SEAM FAULTED
22
21
17
16
14
6
4
18
10
12
9
8
11
3
H. FOX
G. J. MYERS
D. R. MOORE
T. J. BYRNE
MINED OUT
DANIEL DELANEY
CASSIDY
PATRICK McGUIRE
V. FOYLE
SOLD TO GEO POTTER
HON. SAMUEL CALVIN
JOSIAH CHRISTY
D. M. LOUDON
2-1/2 INT.
R. NICHOLS
PENNA. COAL & COKE CORPN.
GLEN WHITE COAL & LUMBER CO.
E SEAM MINED OUT
JOHN DOUGLAS
CAMBRIA COUNTY
BLAIR COUNTY
GALLITZIN TOWNSHIP
LOGAN TOWNSHIP
MARY BOWEN