AFFIDAVIT

STATE OF PENNSYLVANIA)
) ss;
COUNTY OF WESTMORELAND)

Personally appeared before me, the Subscriber, a Notary Public, in and for the Said County and State, E. C. Fitz Simons, who being duly sworn according to law, desposes and says that he is a Registered Professional Engineer of the Pittsburgh Steel Company and that the attached drawing marked "Monessen Coal and Coke Company, Drawing No. 727-6", is a true and correct map showing the coal mined out of Clipper Mine, Borough of Allenport, Washington County, Pennsylvania; by Charles Renstrom, Lessee and later by Sarah Renstrom, Lessee; as of February 10th, 1938.

E. C. Fitz Simons

Sworn and subscribed to before me, this 11th day of February, 1938.

NOTARY PUBLIC
My Commission Expires Feb. 23, 1941.

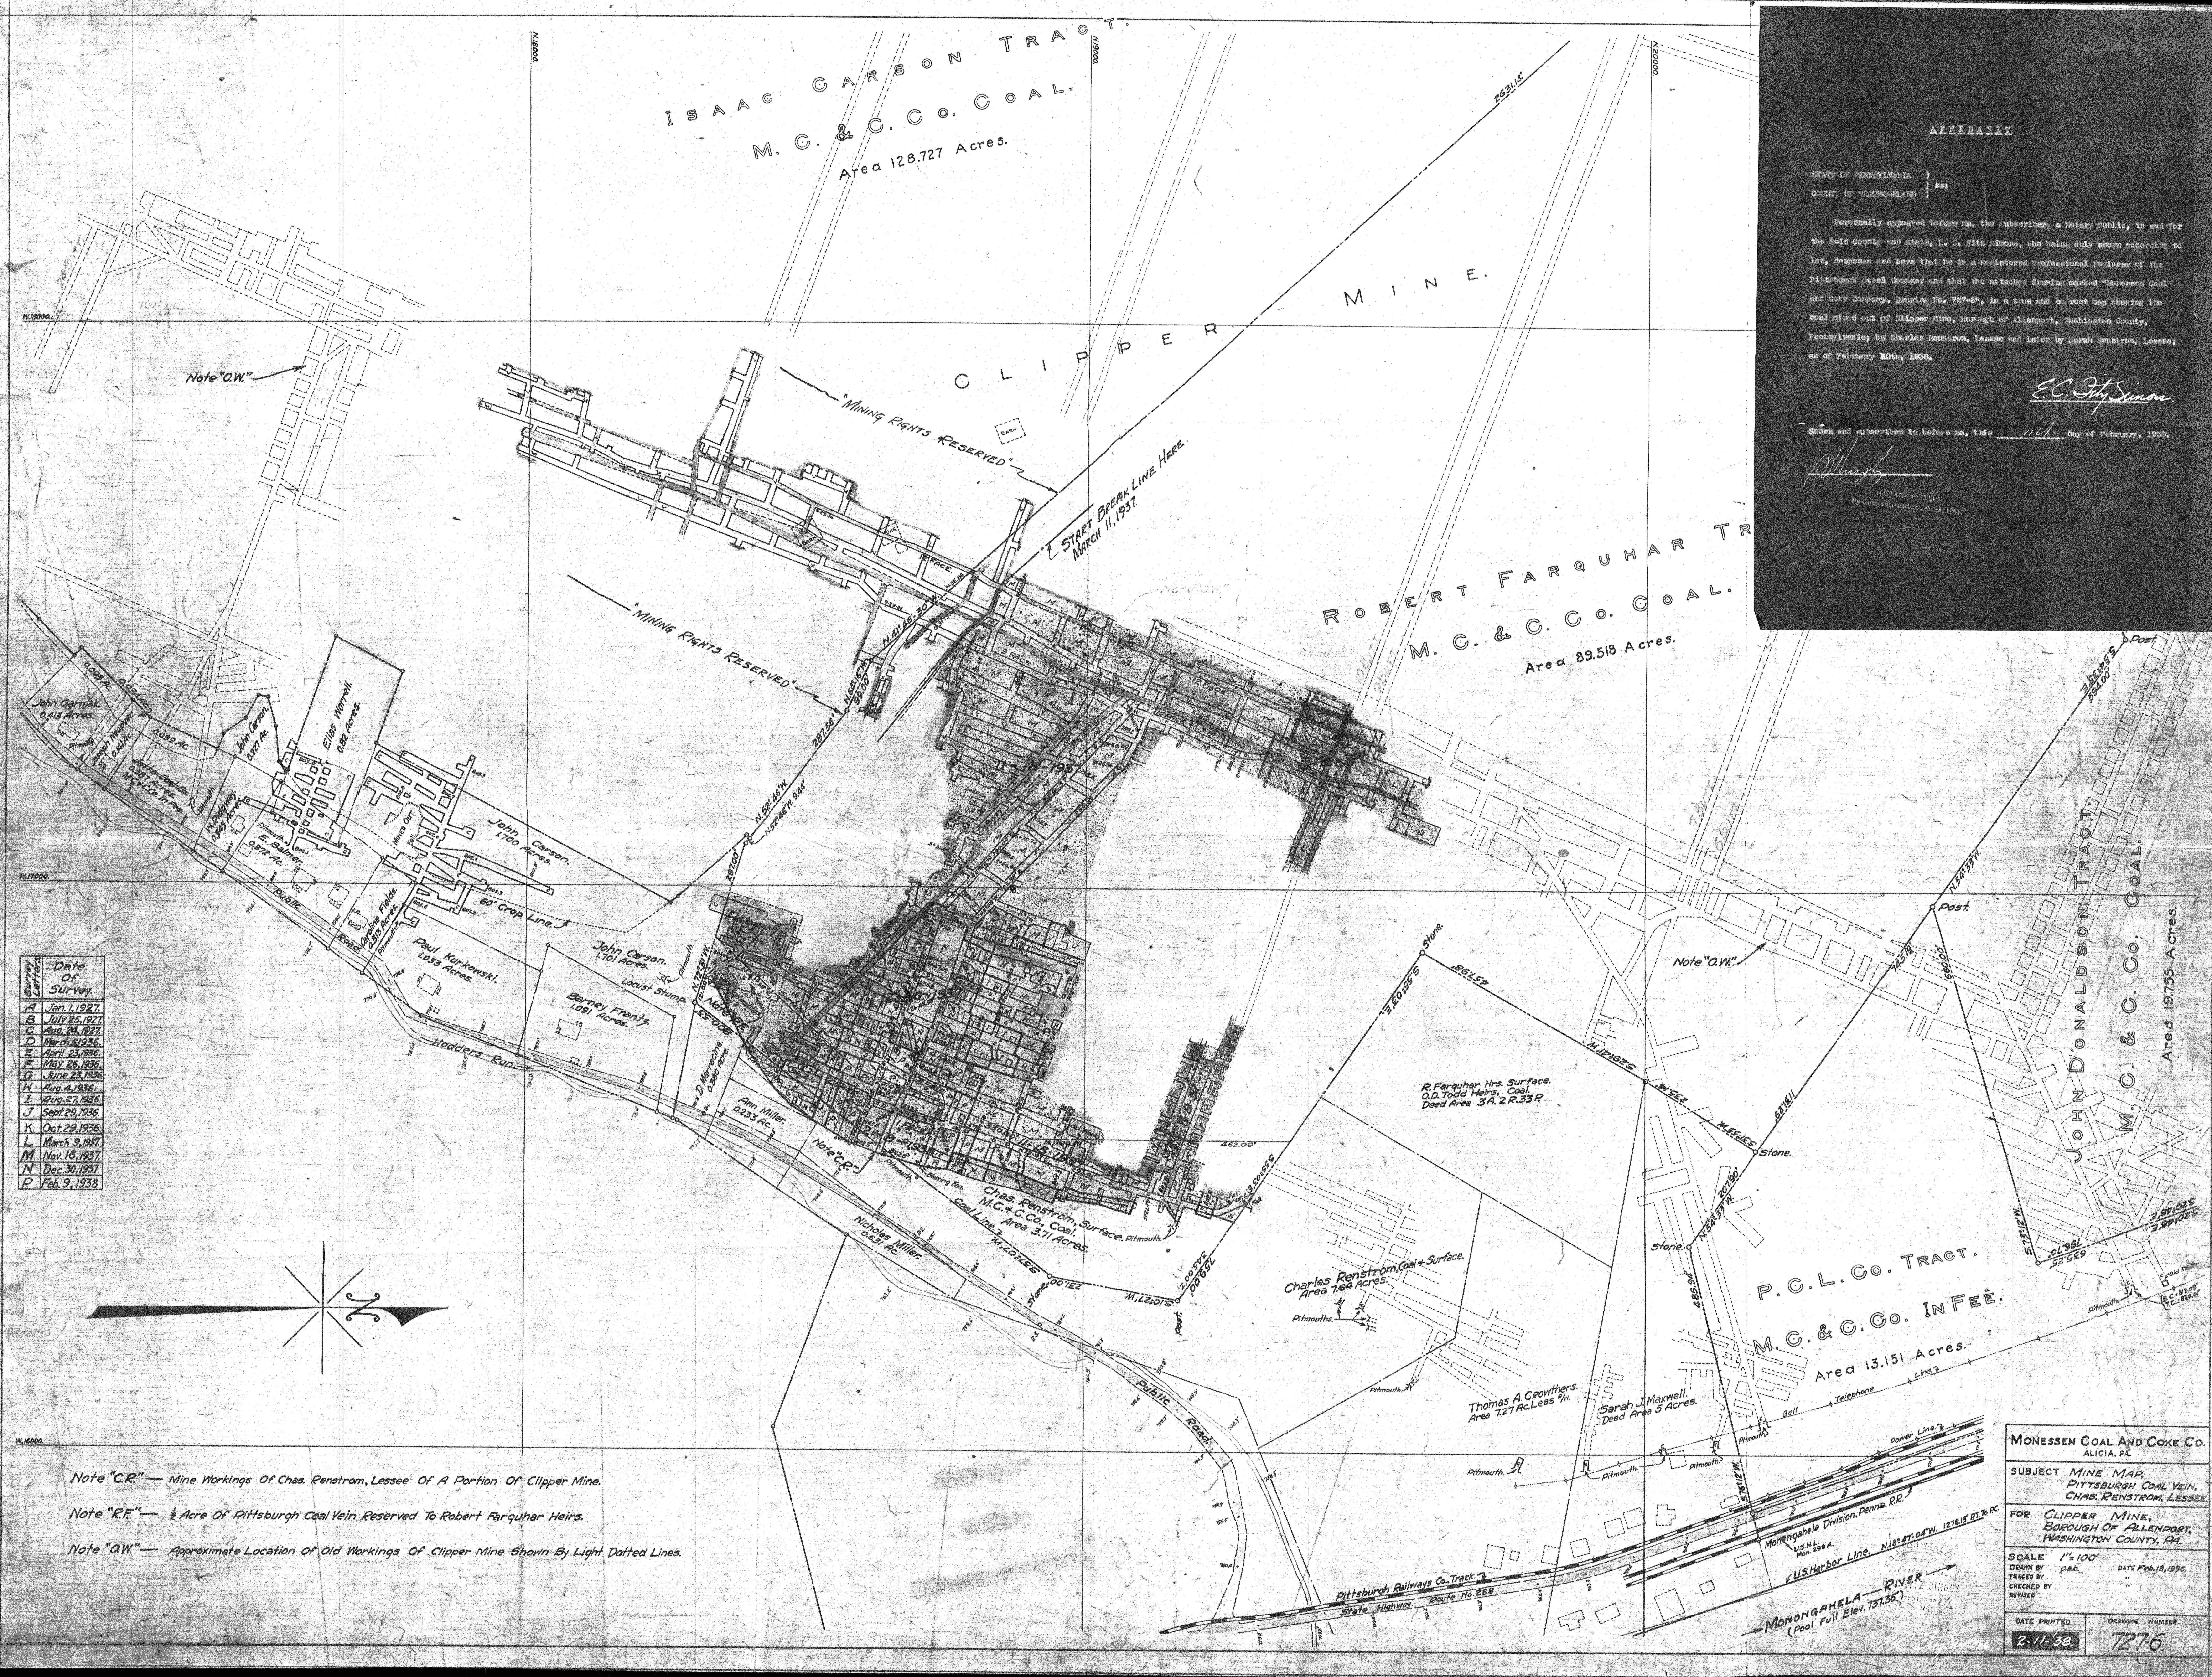

Survey Letters	Date Of Survey.
A	Jan. 1, 1927.
B	July 25, 1927.
C	Aug. 24, 1927.
D	March 5, 1936.
E	April 23, 1936.
F	May 26, 1936.
G	June 23, 1936.
H	Aug. 4, 1936.
I	Aug. 27, 1936.
J	Sept. 29, 1936.
K	Oct. 29, 1936.
L	March 9, 1937.
M	Nov. 18, 1937.
N	Dec. 30, 1937
P	Feb. 9, 1938

Note "C.R." — Mine Workings Of Chas. Renstrom, Lessee Of A Portion Of Clipper Mine.

Note "R.F." — ½ Acre Of Pittsburgh Coal Vein Reserved To Robert Farquhar Heirs.

Note "O.W." — Approximate Location Of Old Workings Of Clipper Mine Shown By Light Dotted Lines.

MONESSEN COAL AND COKE CO.
ALICIA, PA.

SUBJECT MINE MAP,
PITTSBURGH COAL VEIN,
CHAS. RENSTROM, LESSEE.

FOR CLIPPER MINE,
BOROUGH OF ALLENPORT,
WASHINGTON COUNTY, PA.

SCALE 1" = 100'
DRAWN BY p.a.b. DATE Feb. 18, 1936.
TRACED BY "
CHECKED BY "
REVISED

DATE PRINTED 2-11-'38.
DRAWING NUMBER 727-6.