


J.W. FITZSIMONS

J.S. McGINN

11

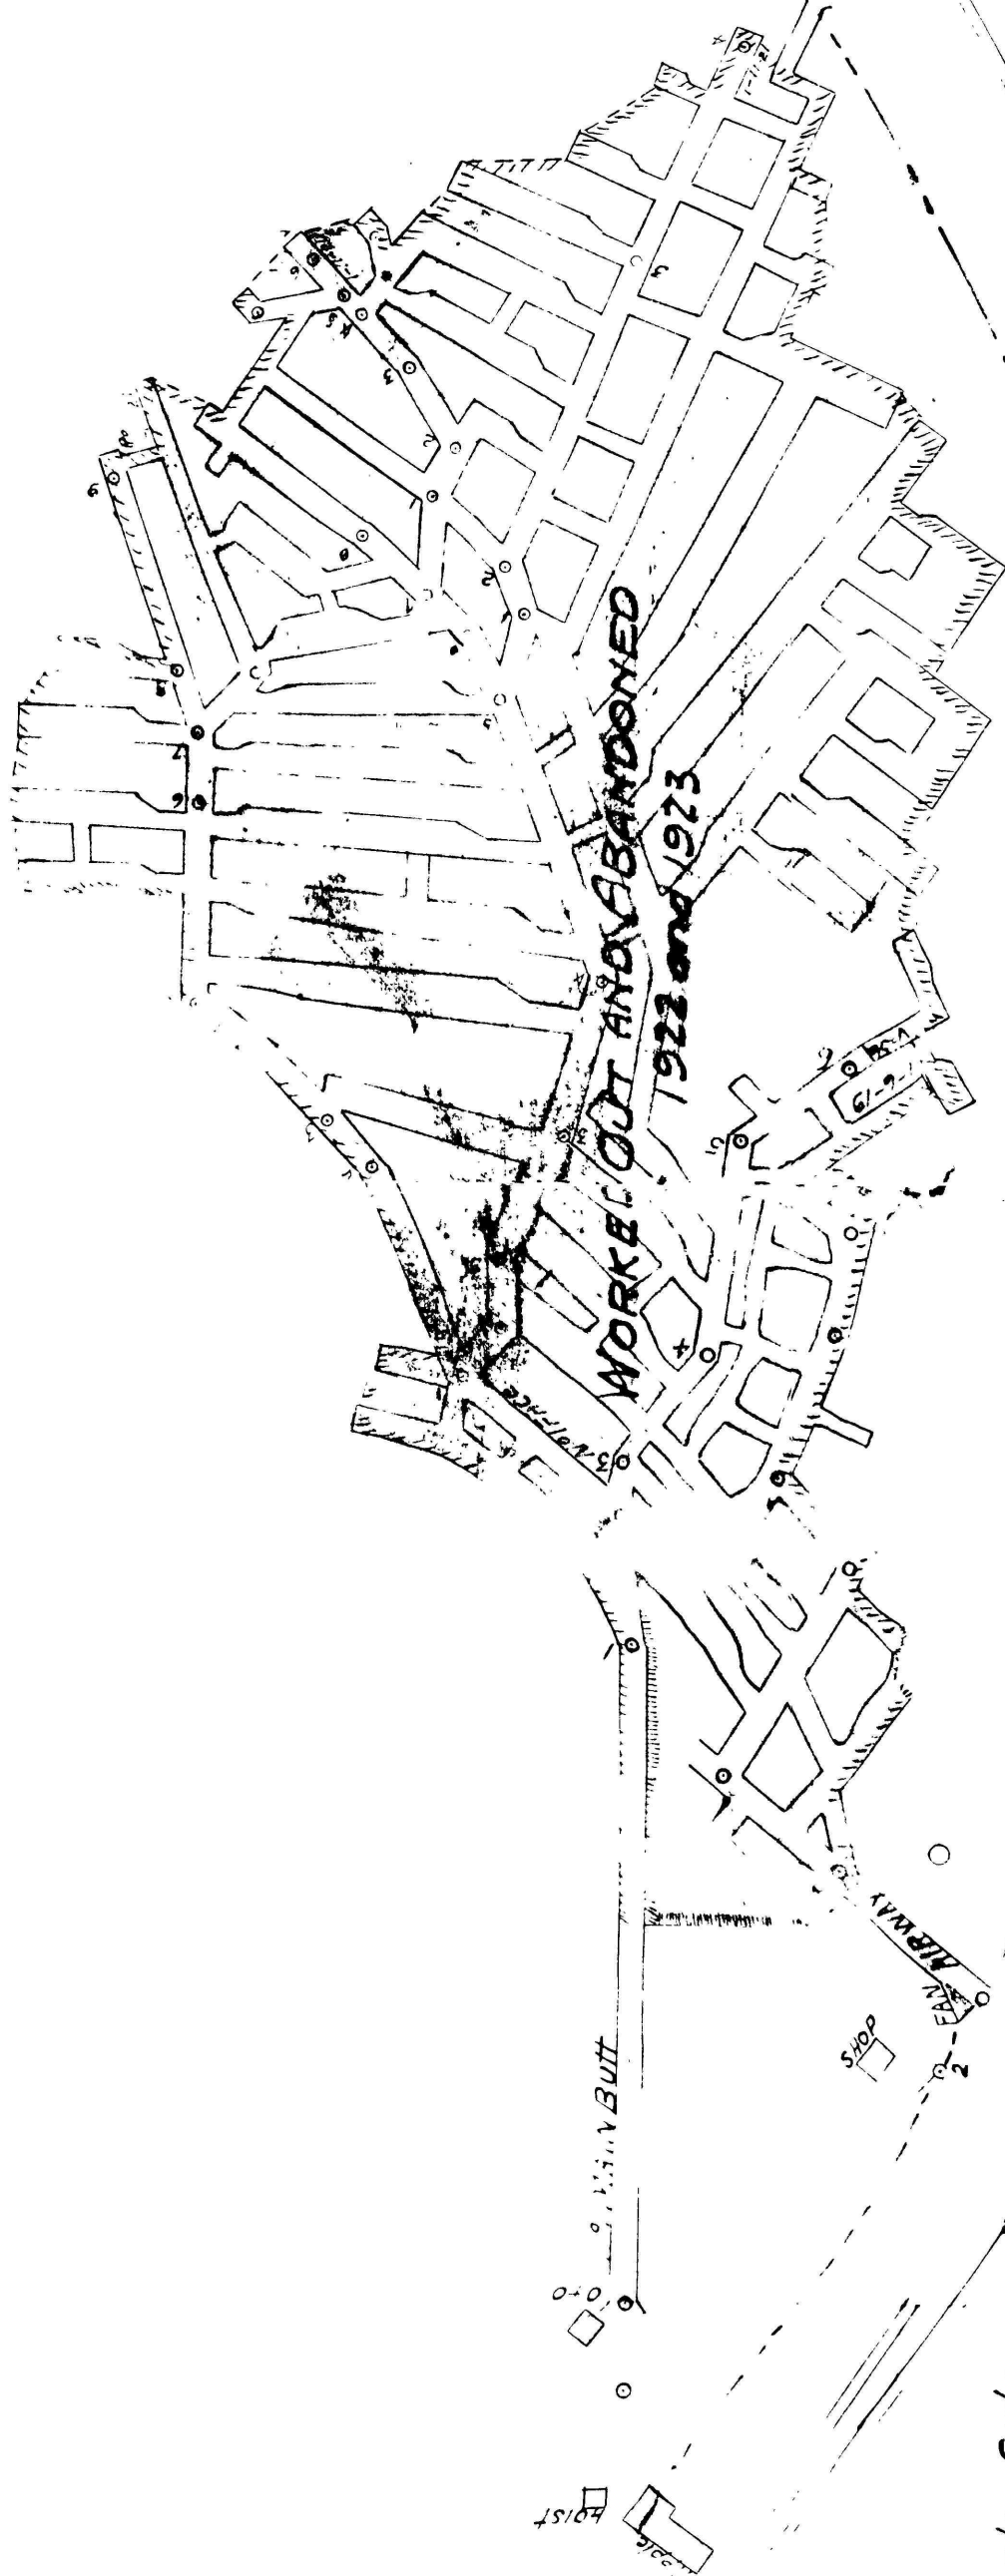

Note - Tipple Side
Tract and Buildings
Removed.

MINE WORKINGS OF THE
KNOXDALE COAL & COKE CO.
CODER NO. 5.

ROSE TOWNSHIP, JEFFERSON COUNTY, PA.

SCALE 1" = 100'

HERBERT & HENDERSON ENGRS. PITTSBURGH, PA.

NOV-20-1913.