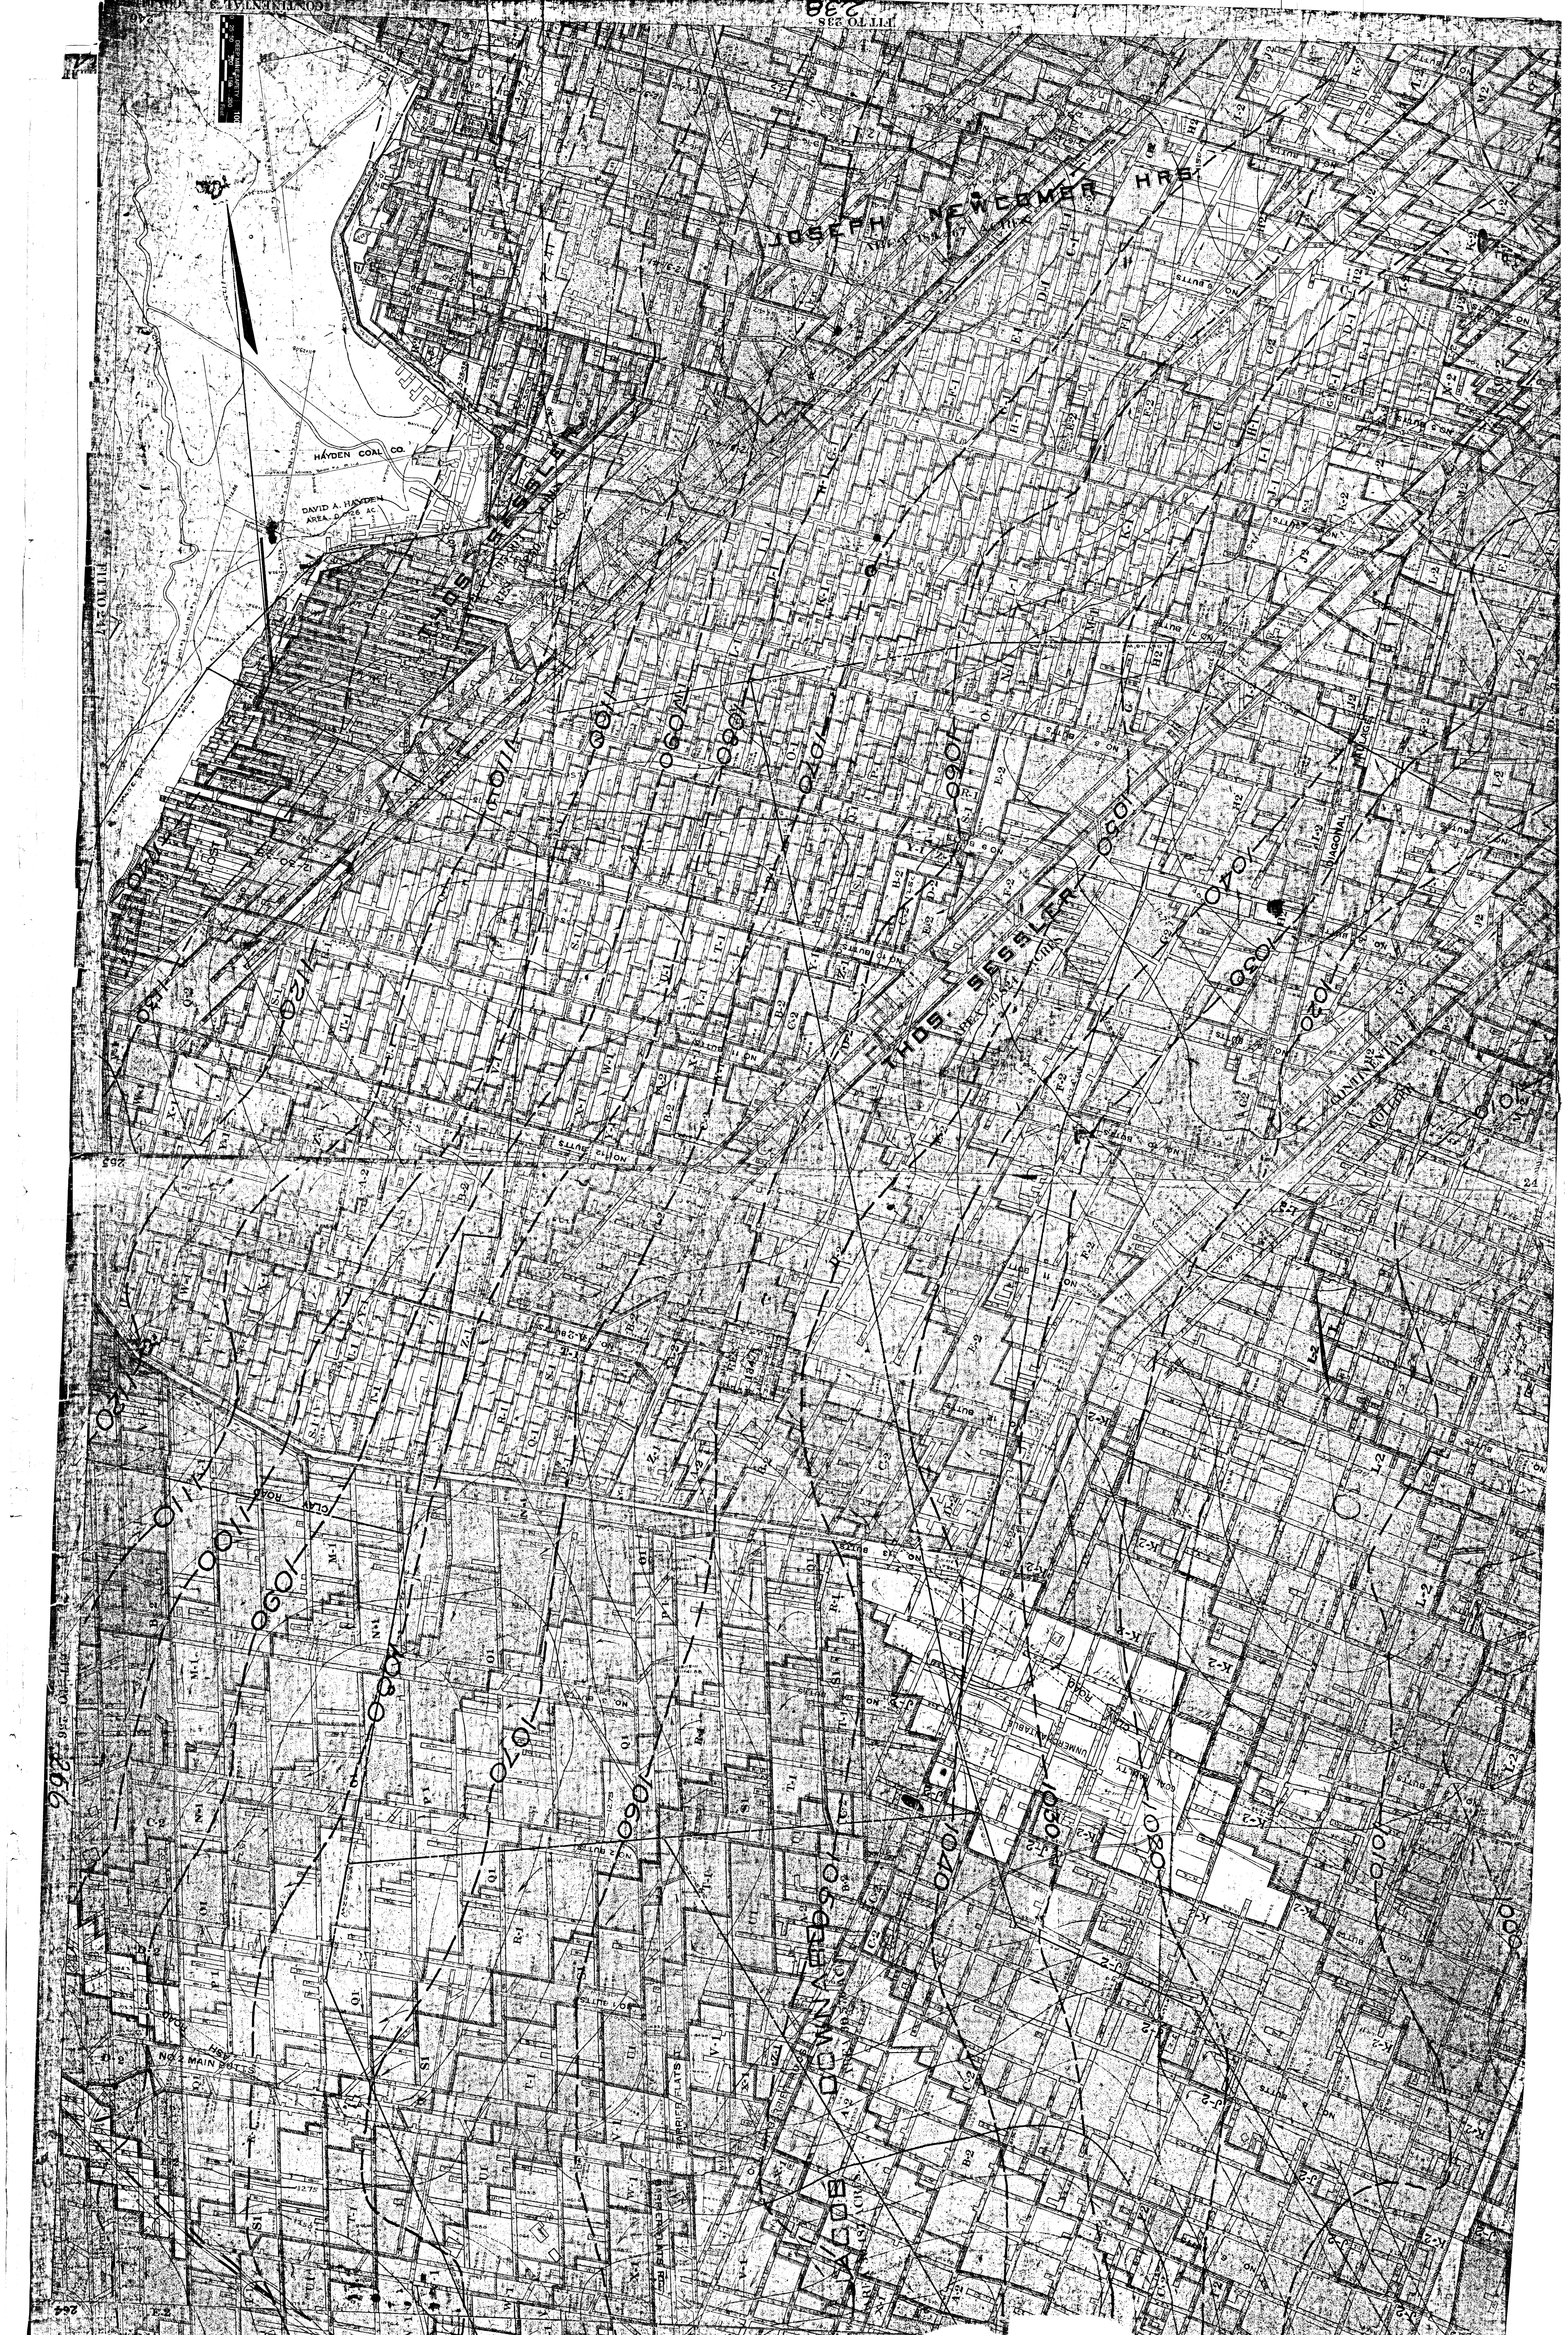
CONTINENTAL 3
246
DEEP MINE SAFETY
0 25 50 100 150 200 Feet
FIT TO 238
238
HAYDEN COAL CO.
OUTSIDE MINES BOOK
DAVID A. HAYDEN
AREA 0.026 AC.
FIT TO 247
JOSEPH NEWCOMER HRS.
AREA 184.767 ACRES
THOS. SESSLER
THOS. SESSLER
AREA
ACRES
DIAGONAL
HAULAGE
CONTINENTAL
24
253
NO 12 BUTTS
1130
1120
1110
1100
1090
1080
1070
1060
1050
1040
1030
1020
1010
1000
CLAY ROAD
UNMERCHANTABLE COAL
DOWNARD
JACOB
266
NO 2 MAIN BUTTS
BARRIER FLATS
264
25
ABRAHAM HUSTEAD
ACRES
MAIN DIP HDGS
265
Carnegie Natural Gas Co. 8" Line
ASH ROAD
CLAY ROAD
FIT TO 275
275