


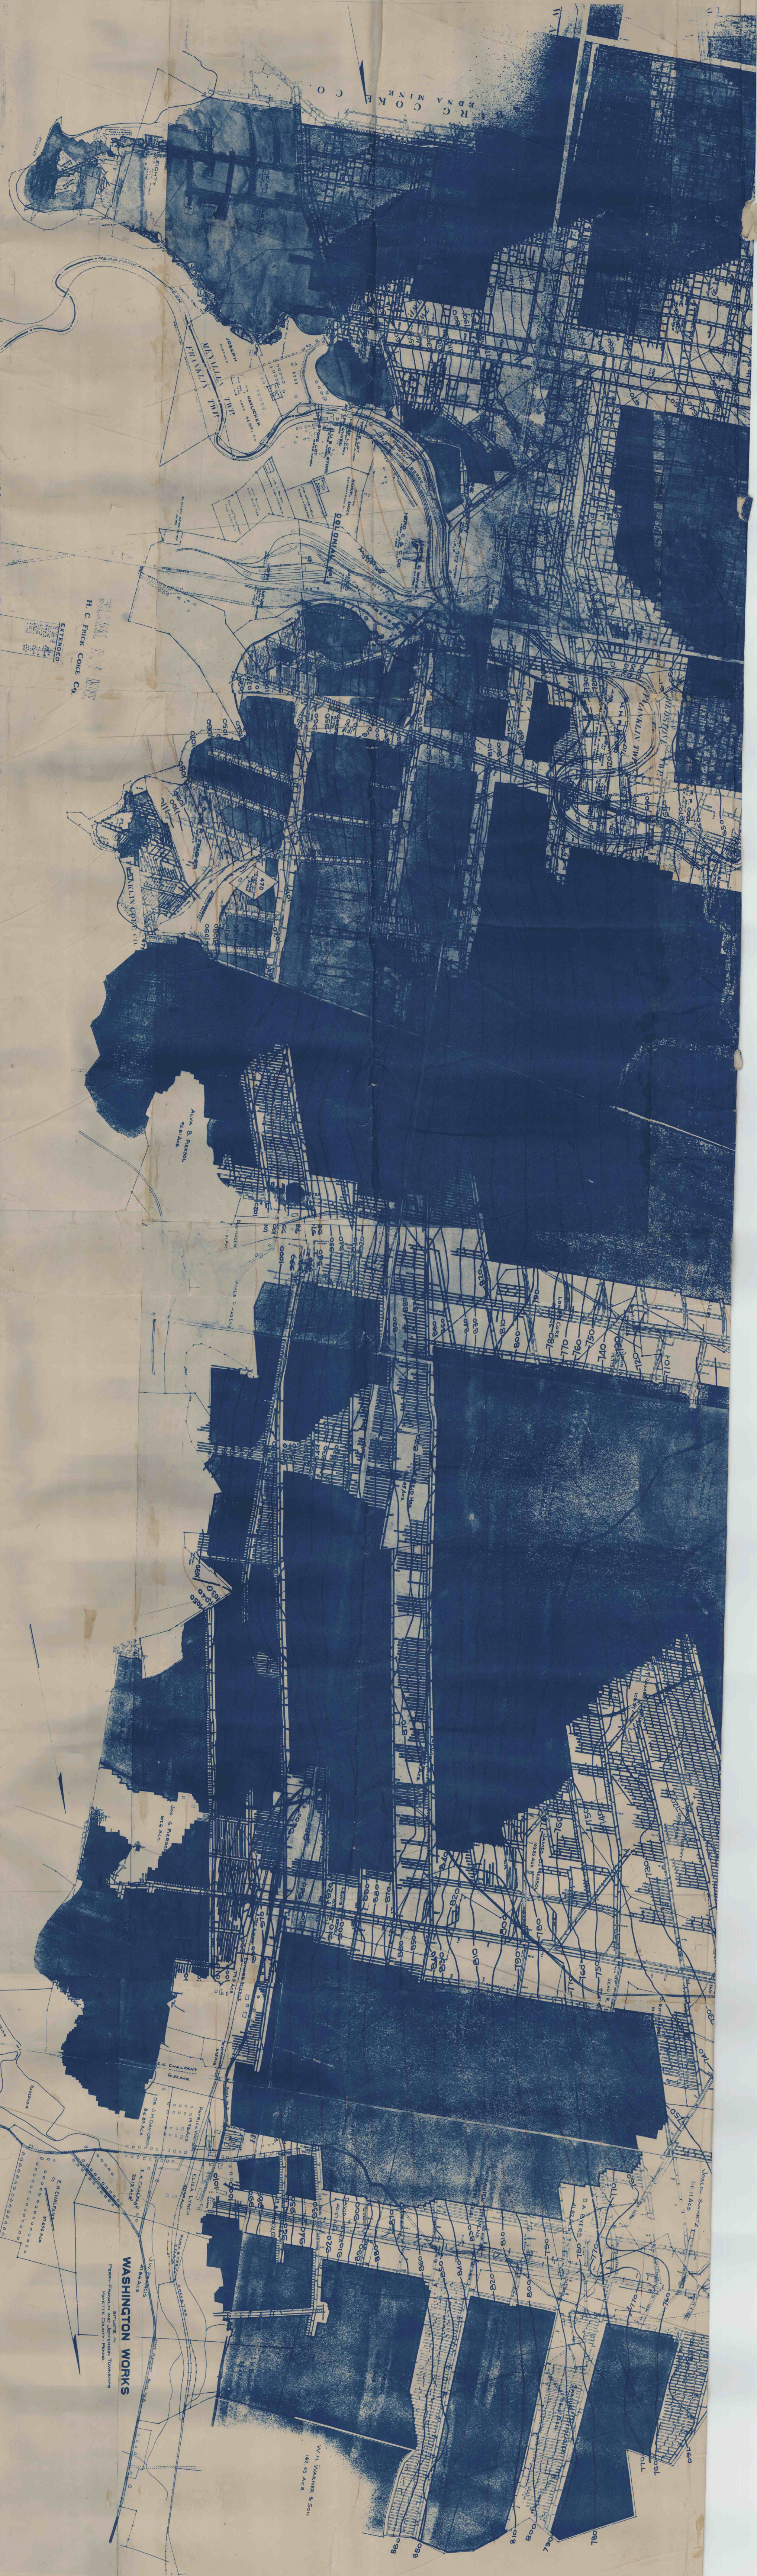

H.C. FRICK COKE CO.


