


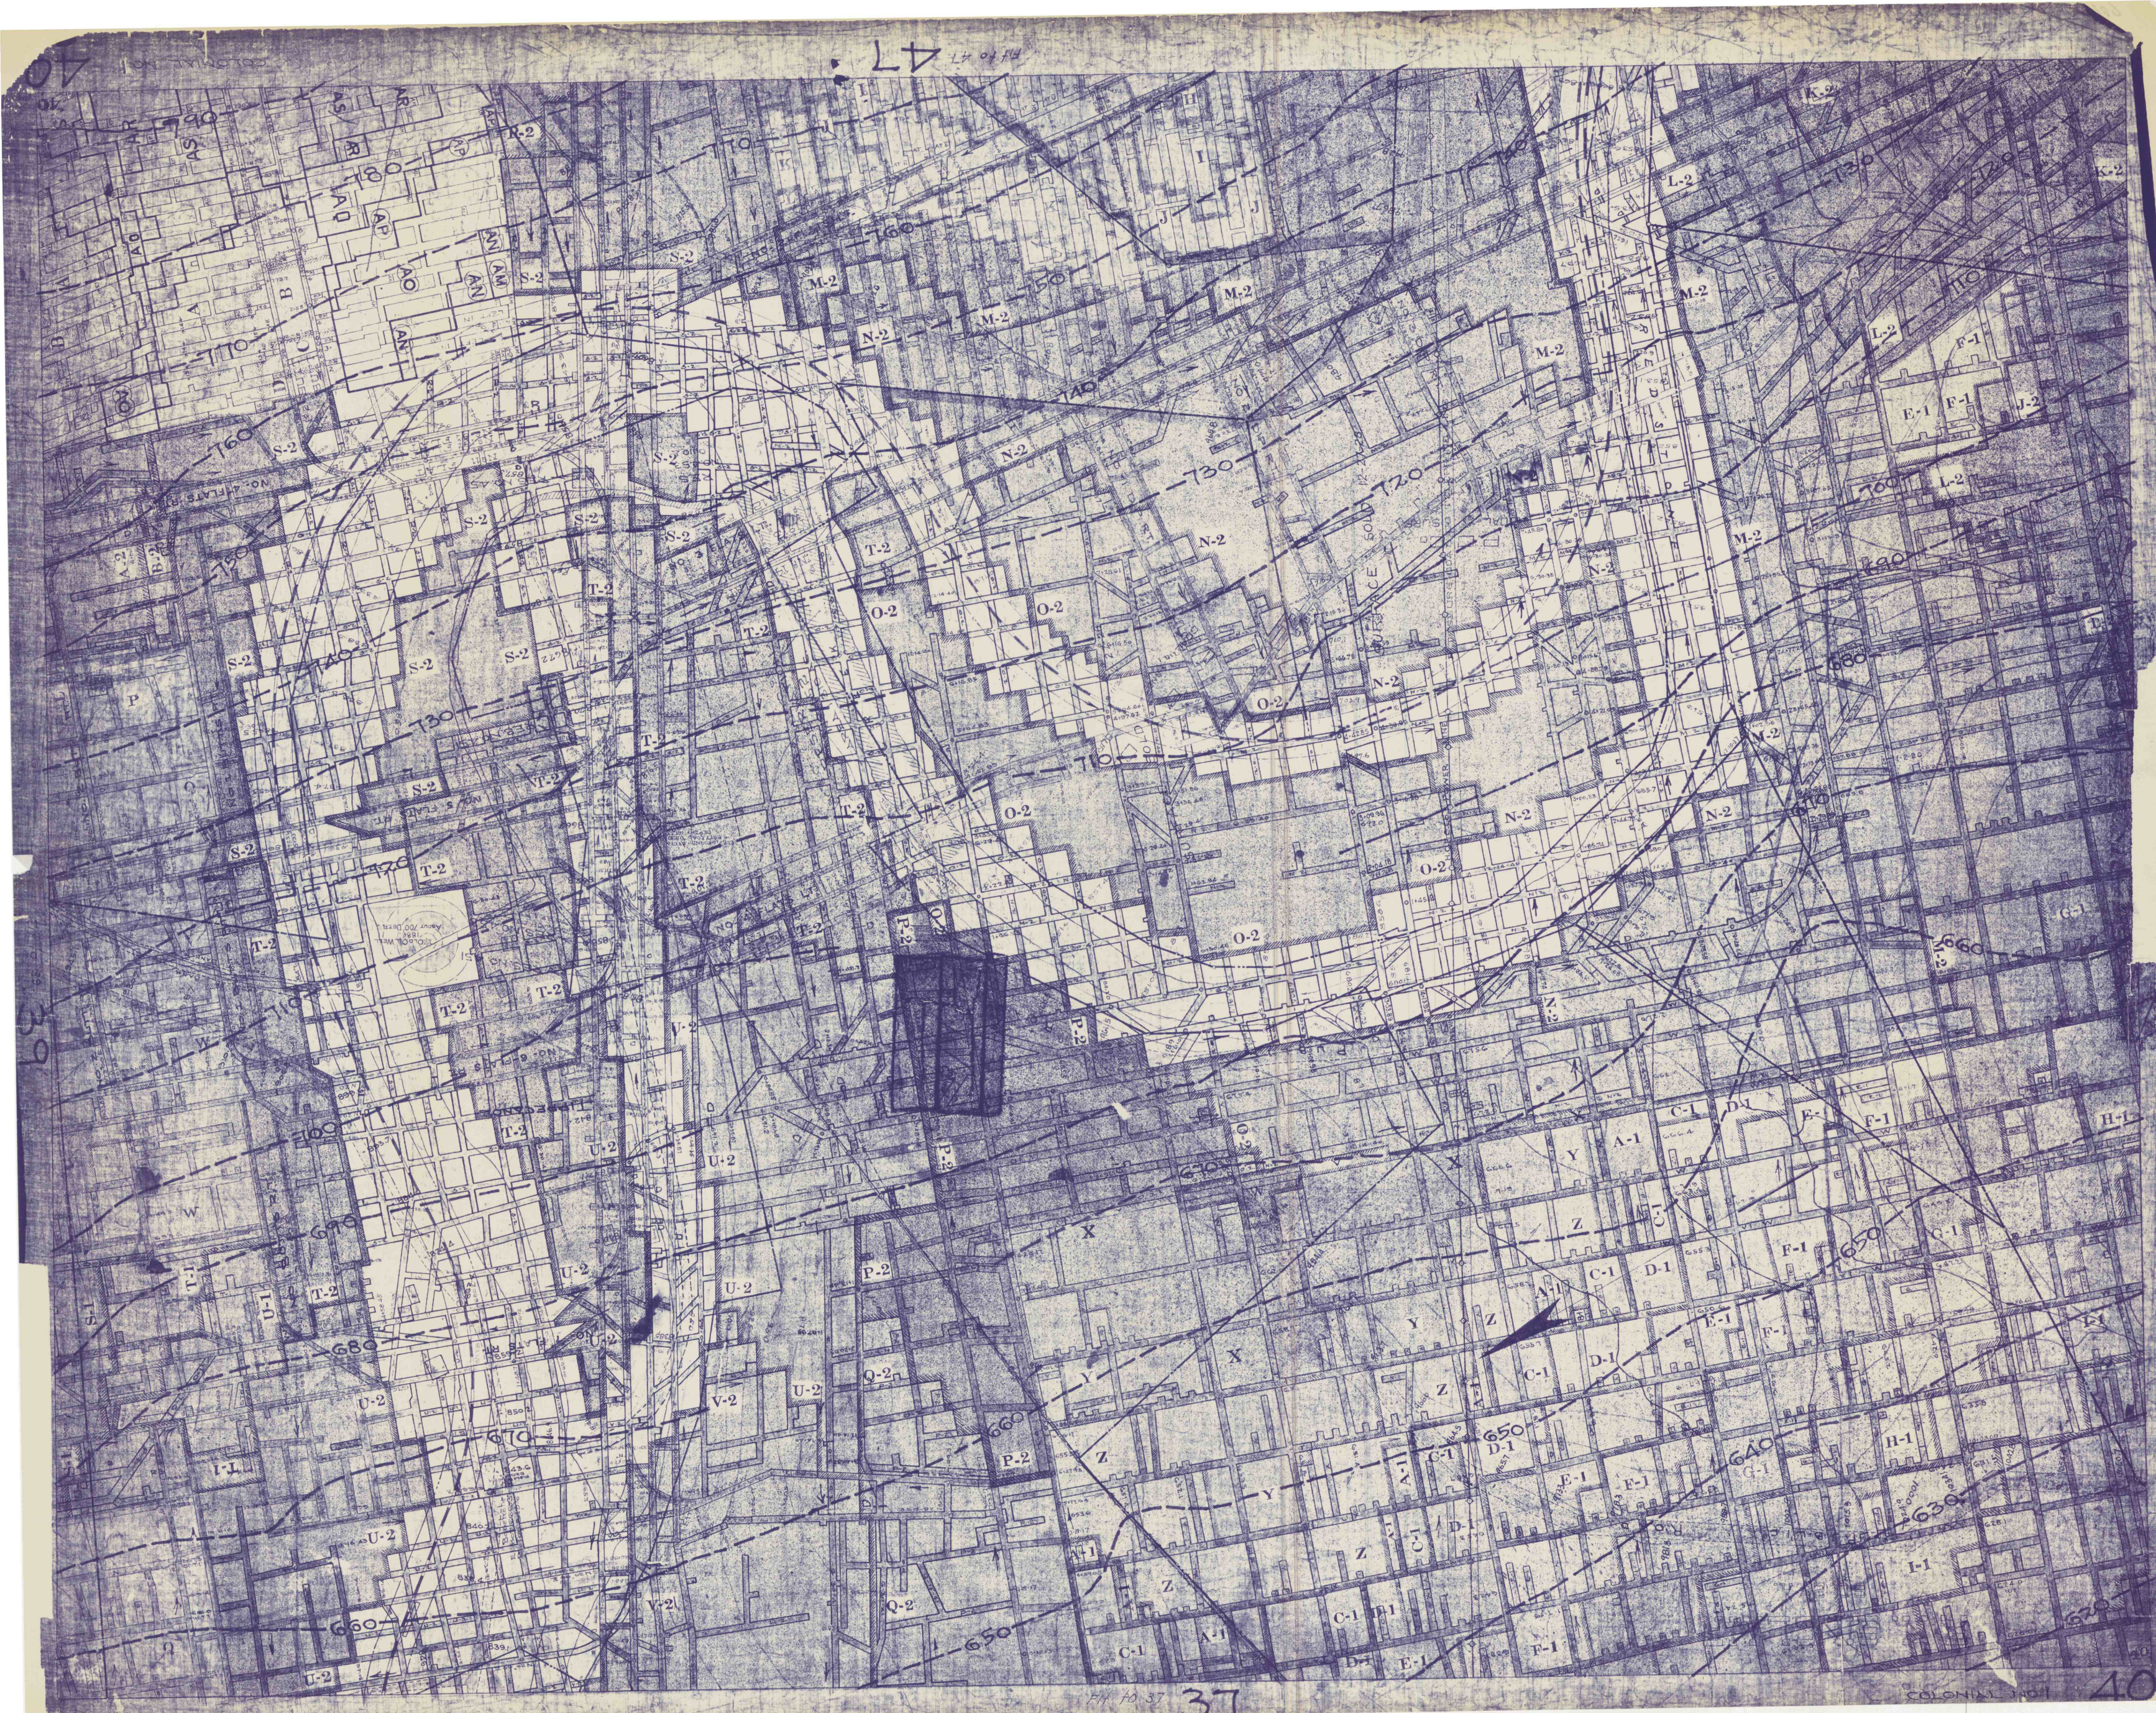

47

37

40