


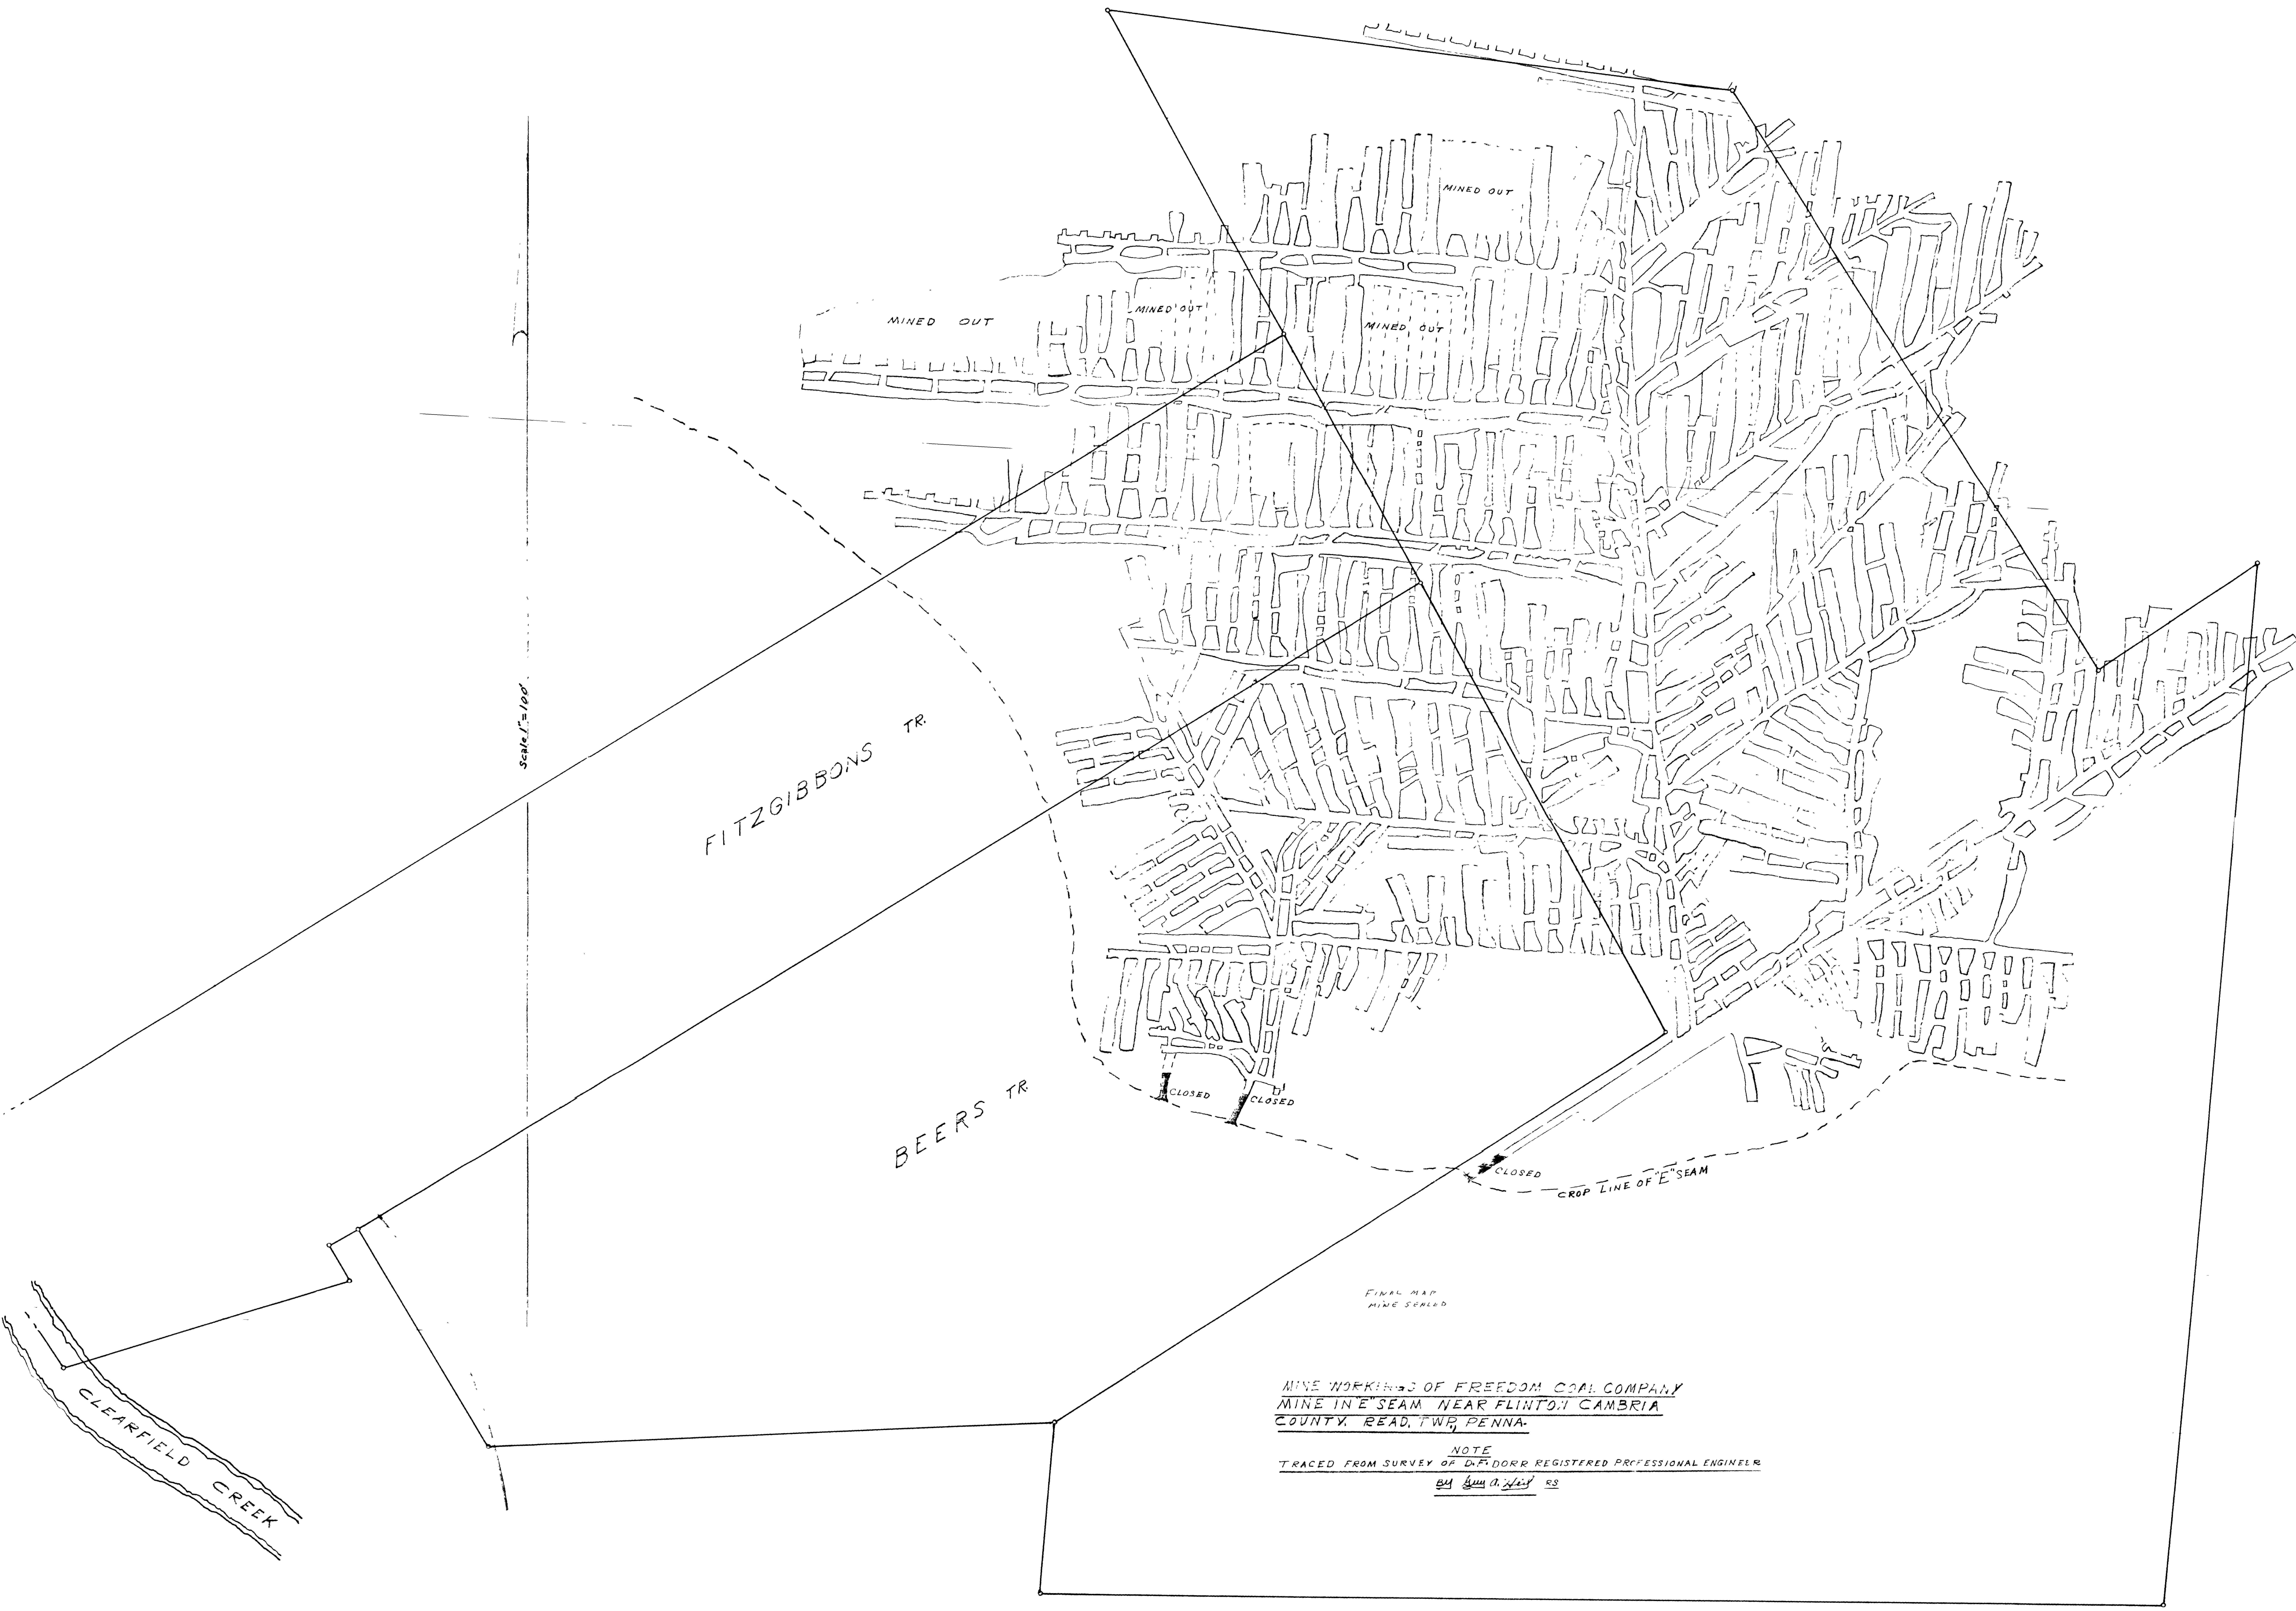

Scale 1" = 100'

FITZGIBBONS TR.

BEERS TR.

MINED OUT

MINED OUT

MINED OUT

FINAL MAP
MINE SEALD

MINE WORKINGS OF FREEDOM COAL COMPANY
MINE IN E SEAM NEAR FLINTON, CAMBRIA
COUNTY, READ, TWP, PENNA.

NOTE
TRACED FROM SURVEY OF D.F. DORR REGISTERED PROFESSIONAL ENGINEER

CLEARFIELD CREEK

CROP LINE OF E SEAM

CLOSED

CLOSED

CLOSED