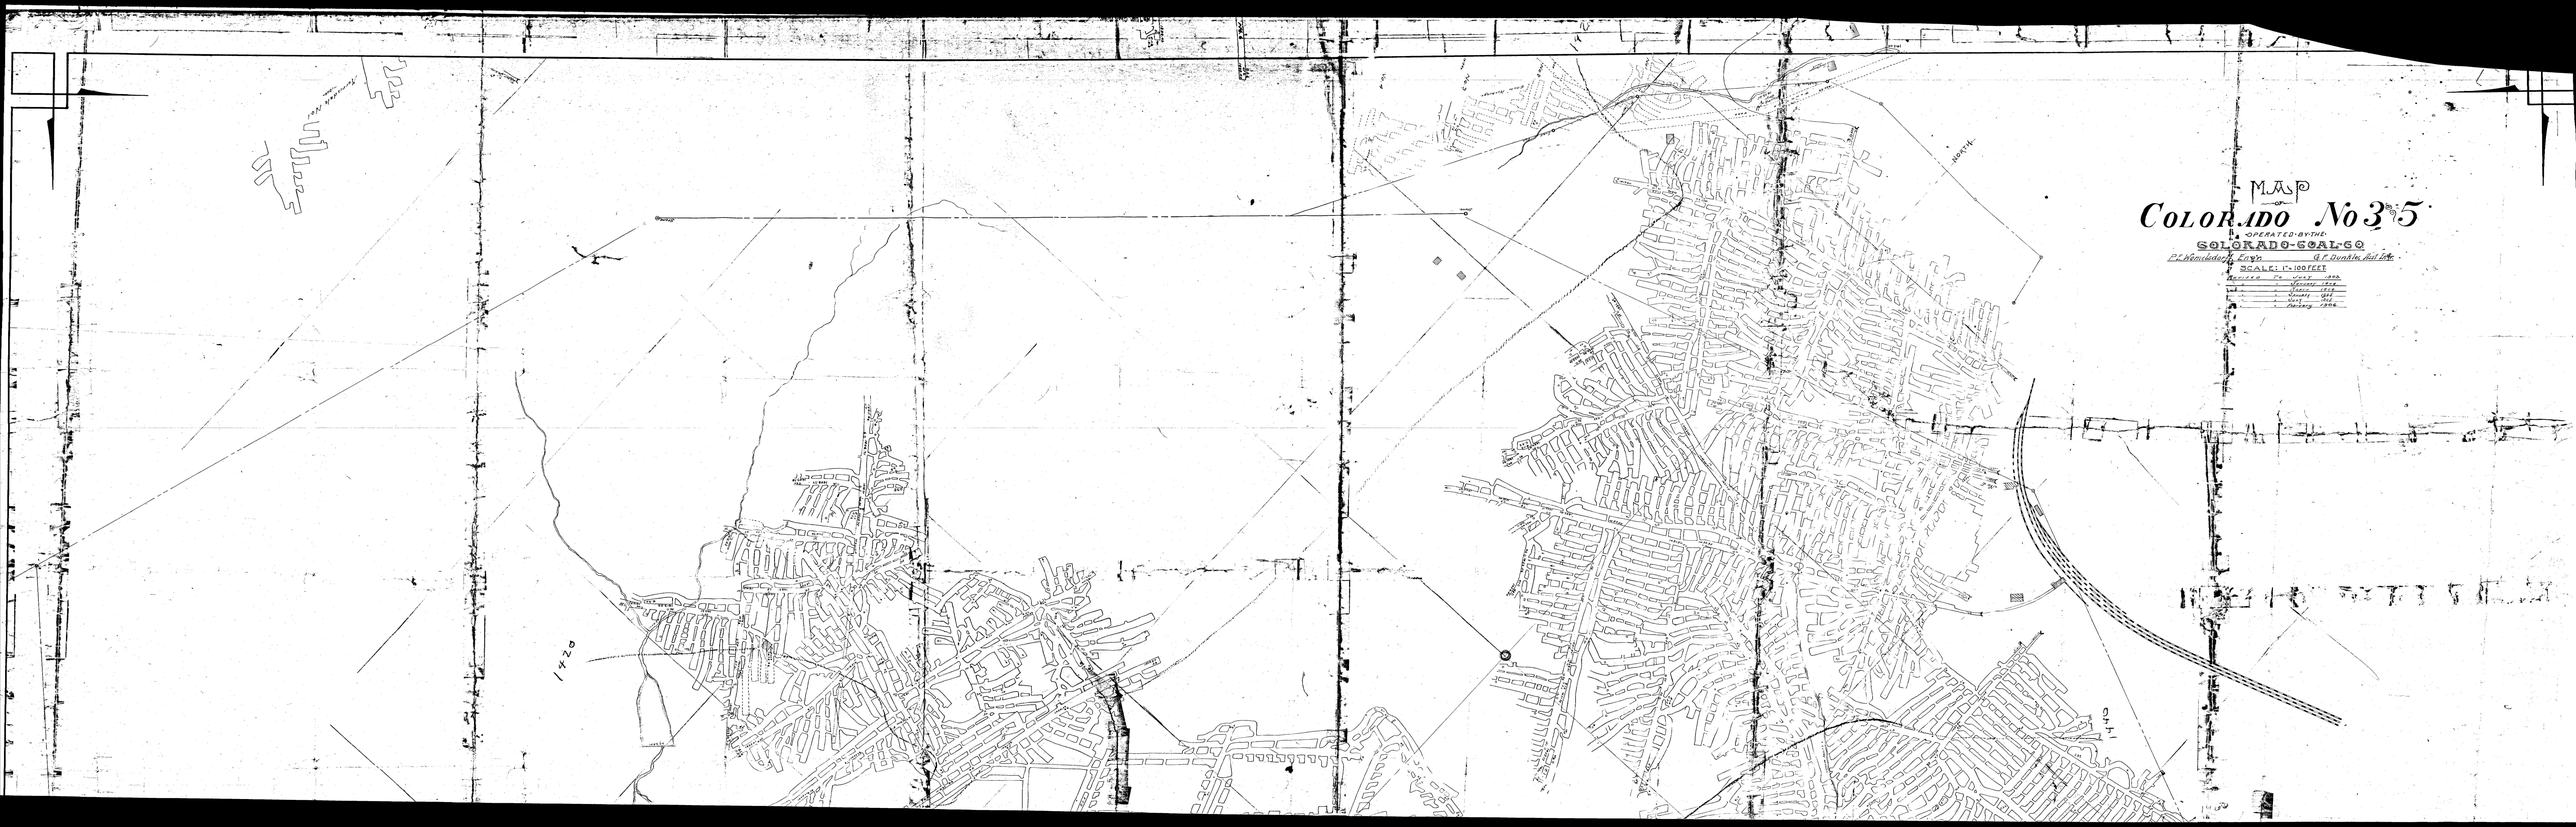
MAP
COLORADO No 3 & 5
OPERATED BY THE
COLORADO COAL CO
P.F. Nonckiedorf, Engr.
G.F. Dunklin, Asst. Engr.
SCALE: 1" = 100 FEET
REVISED TO JULY 1906
1 FEBRUARY 1912
2 APRIL 1912
3 MAY 1912
4 FEBRUARY 1906
NORTH
1720