



 

TO THE BEST OF MY KNOWLEDGE AND BELIEF, I CERTIFY THIS PRINT TO BE
A TRUE AND ACCURATE FINAL MAP OF THE COLVER NO. 2 SEAM MINE.

John G. Emerick
JOHN G. EMERICK
REGISTERED PROFESSIONAL ENGINEER
EASTERN ASSOCIATED COAL CORP.

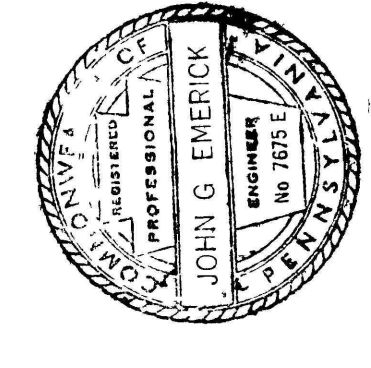

DATE	NAME	SCALE	SHEET NO.
		1" = 100'	3 OF 3

EASTERN GAS & FUEL ASSOCIATES
PITTSBURGH, PA.

COLVER NO. 2 MINE
LOWER FREEPORT SEAM

100' MINE TRACING
SHEET 3 OF 3

EASTERN GAS & FUEL ASSOCIATES
PITTSBURGH, PA.

COLVER NO. 2 MINE
LOWER FREEPORT SEAM

100' MINE TRACING
SHEET 1 OF 3