


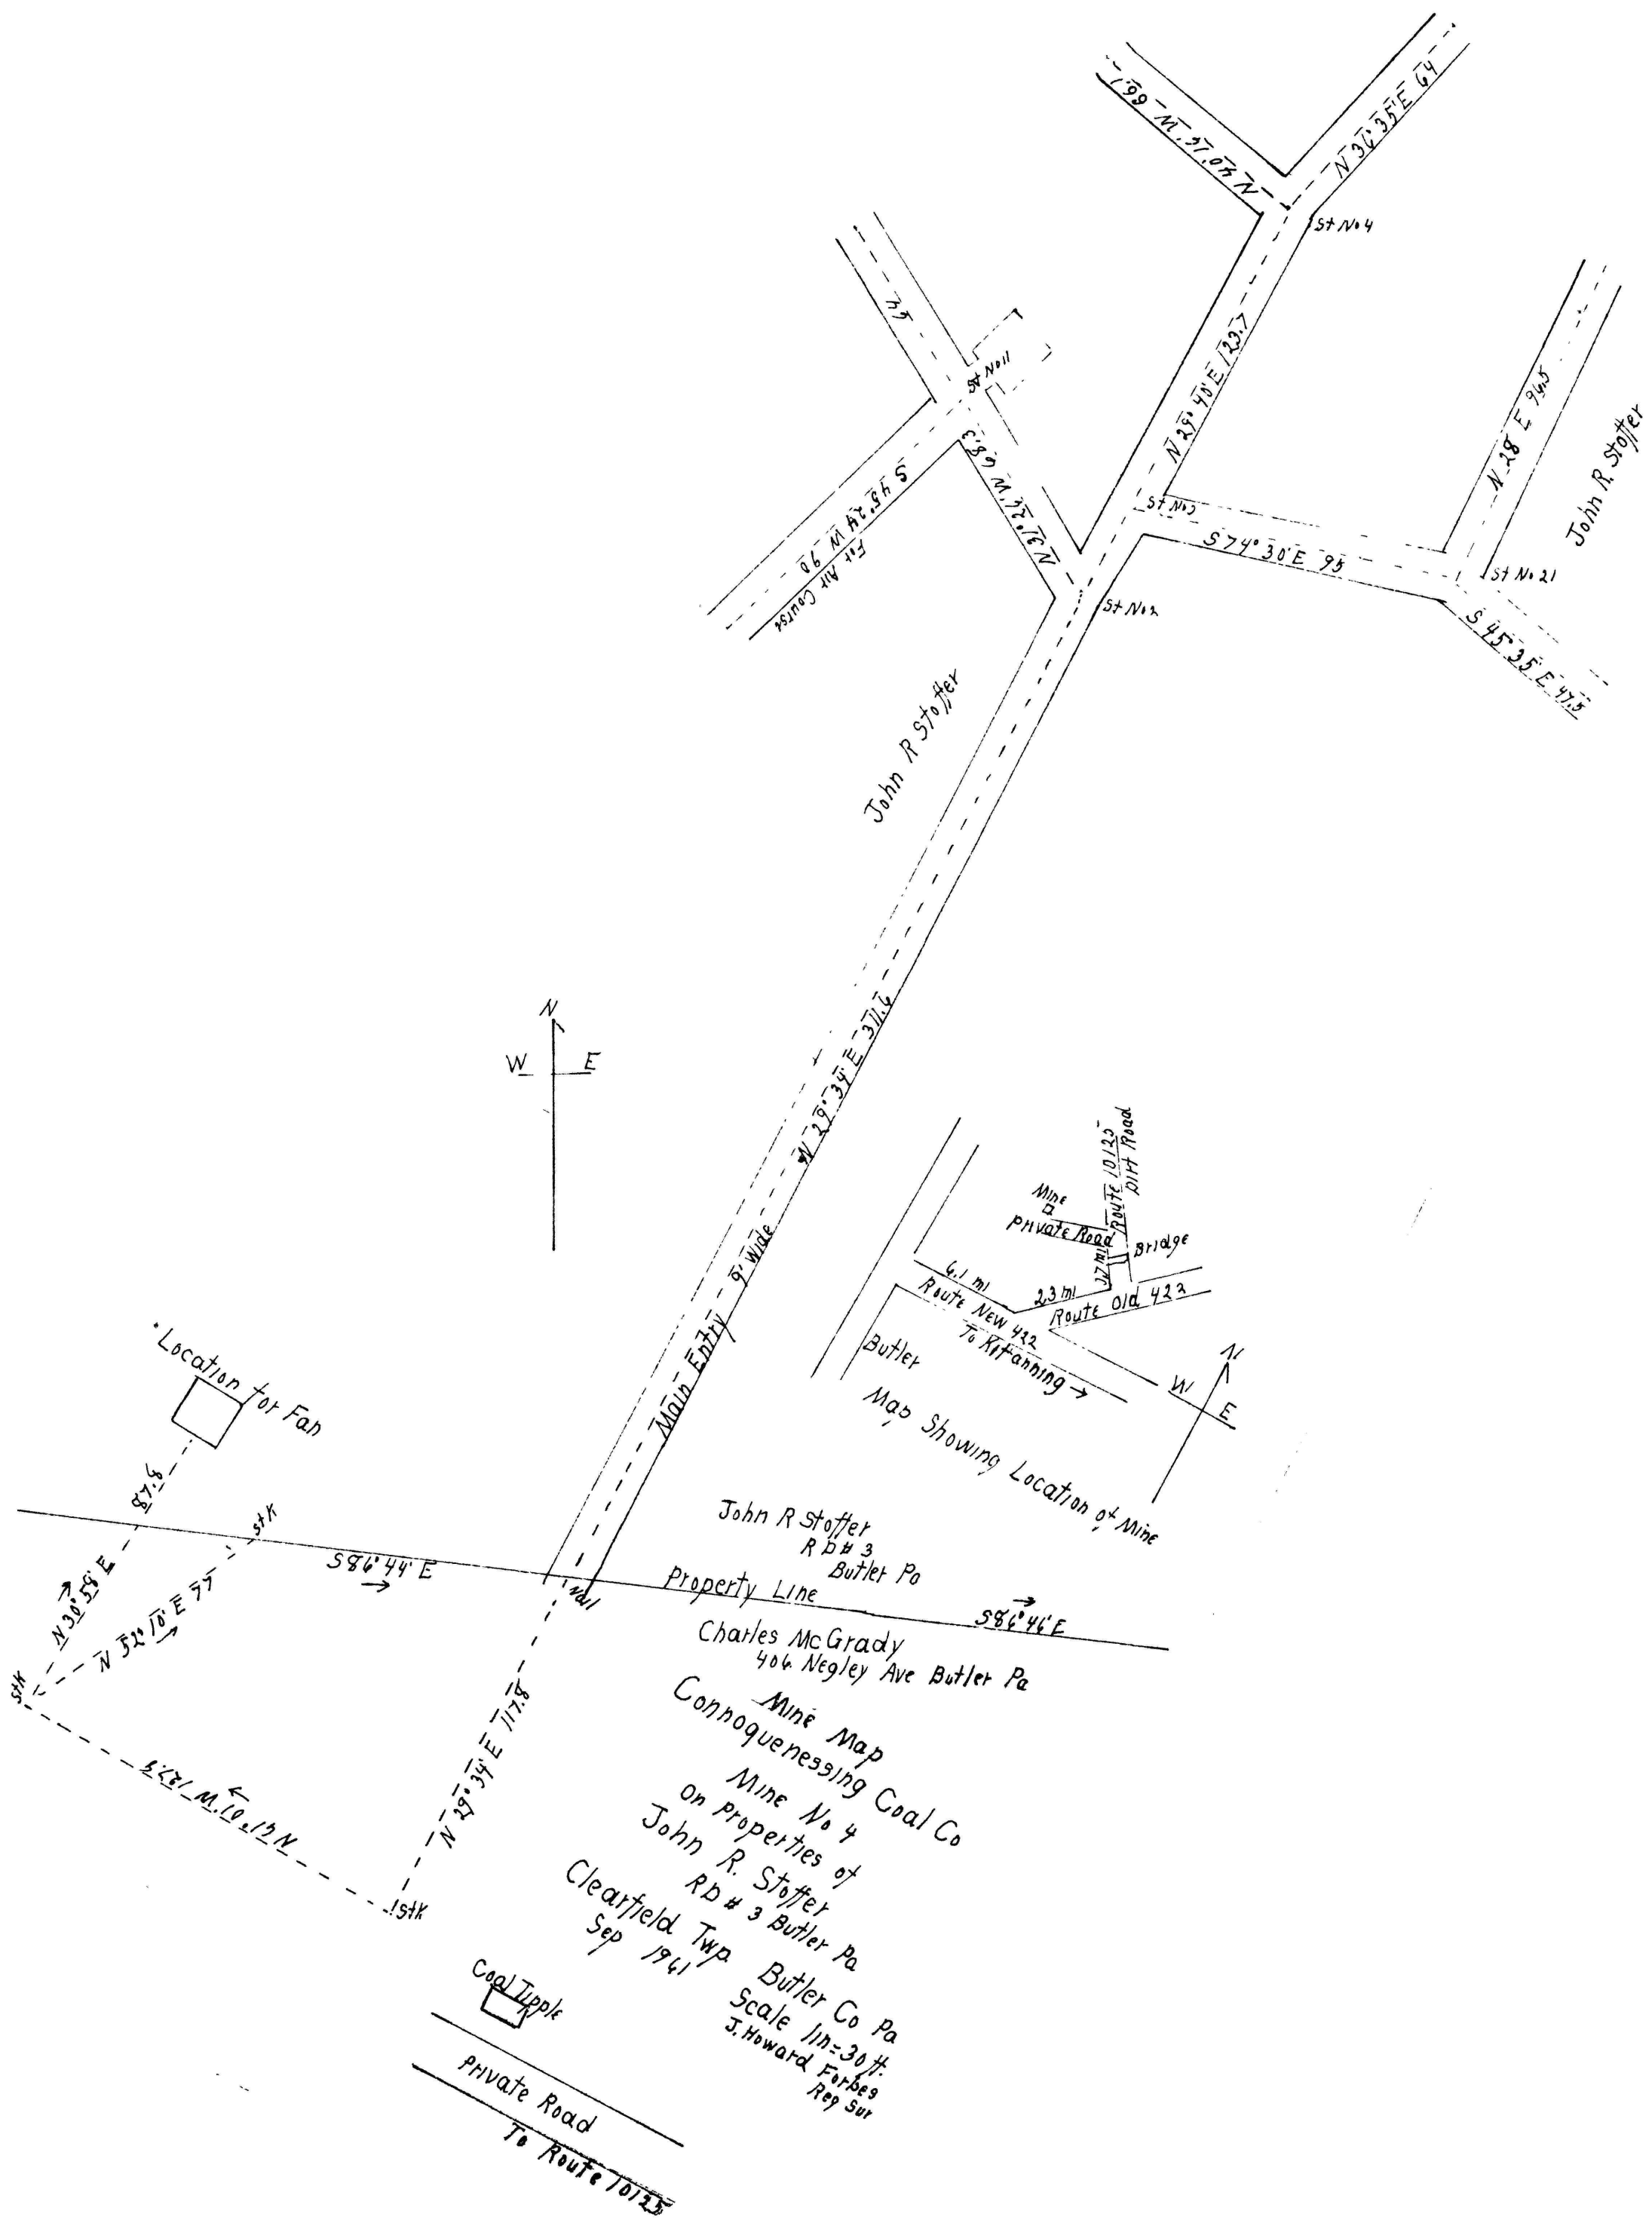

Mine Map
on properties of
John R. Stoffer
Clearfield Twp
Sep 1941
Butler Co Pa
Scale 1 in = 30 ft.
J. Howard Farber
Rep Sur

Coal Tipple
Private Road
To Route 10125