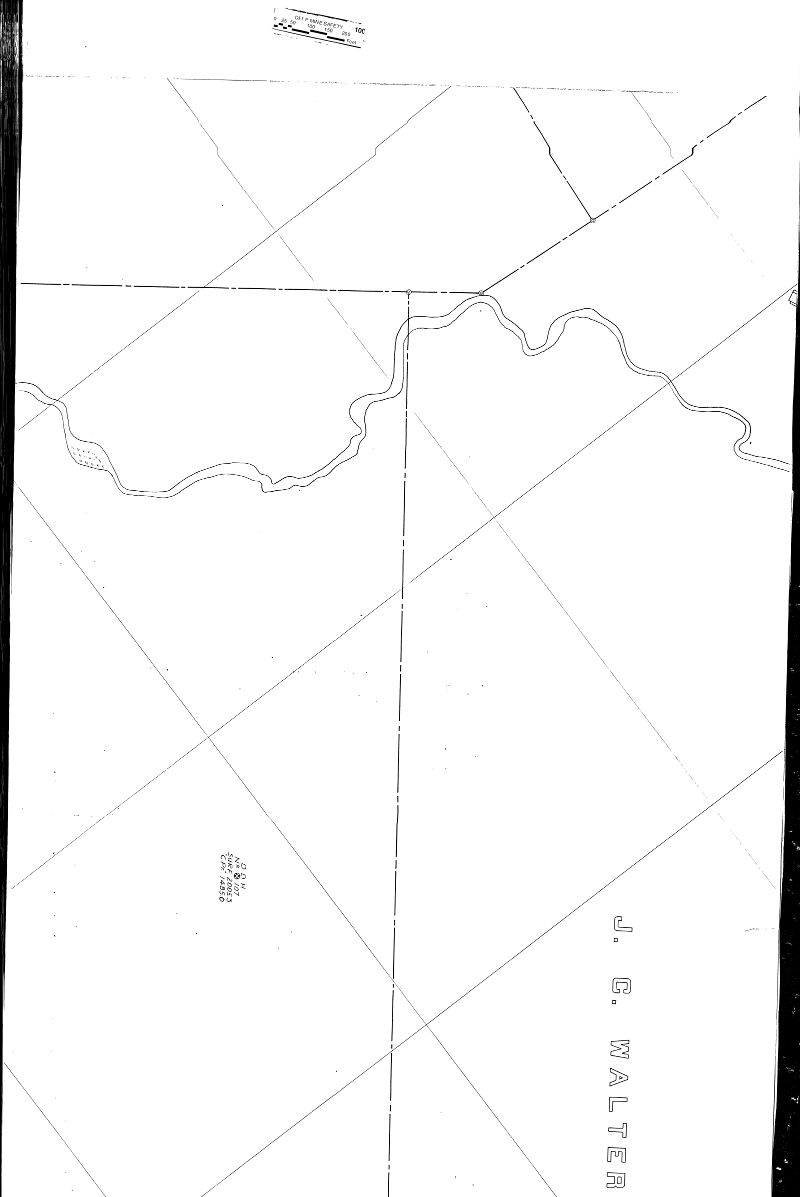
DEP MINE SAFETY
0
25
50
100
150
200
100
Feet
D.D.H.
№ 107
SURF 2005.3
"C.Pr." 1485.0
J. C. WALTER

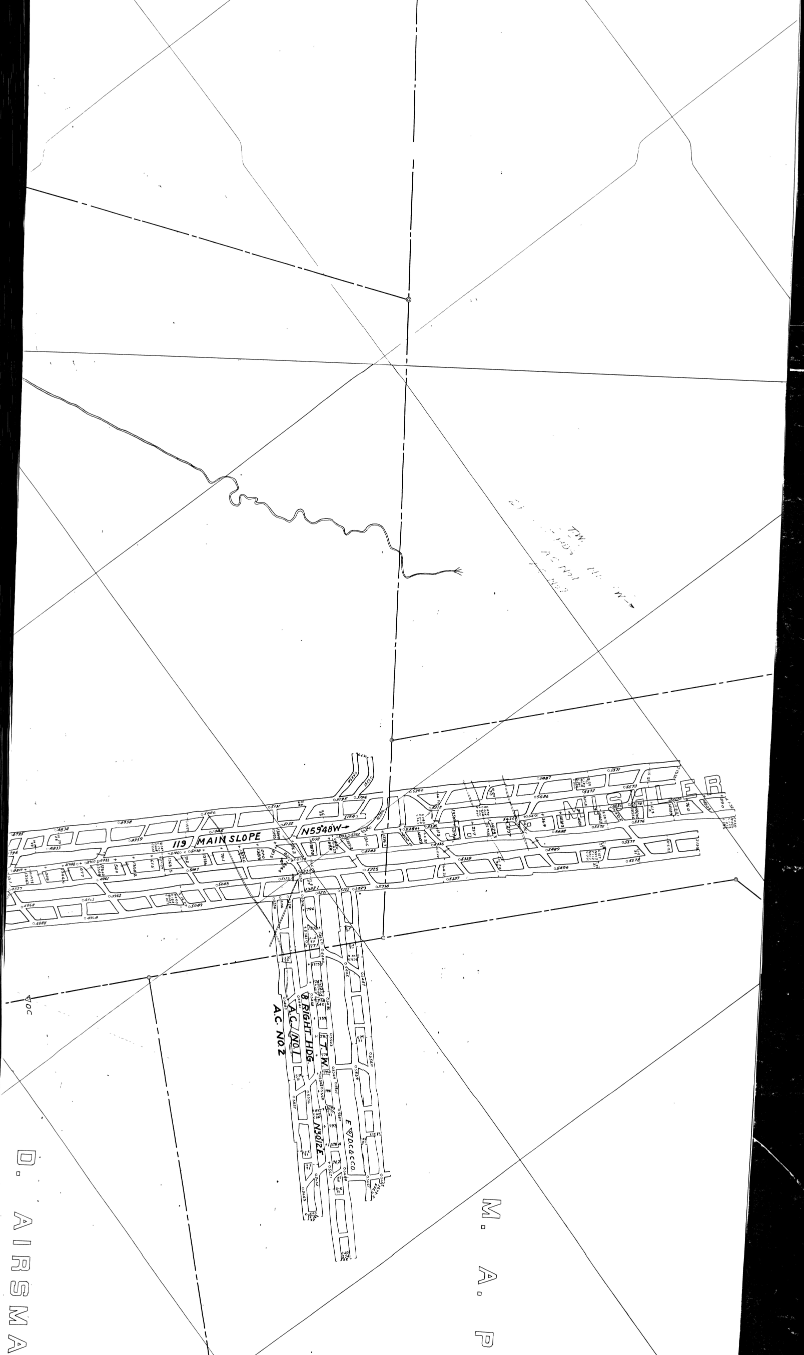
119 MAIN SLOPE
N59°48'W
J. D. MISSLER
B RIGHT HDG.
A.C. NO 1
A.C. NO 2
T.T.W.
N30°12'E
DC&CO
T.W.
A.C. No1
D. AIRSMA
M. A. P

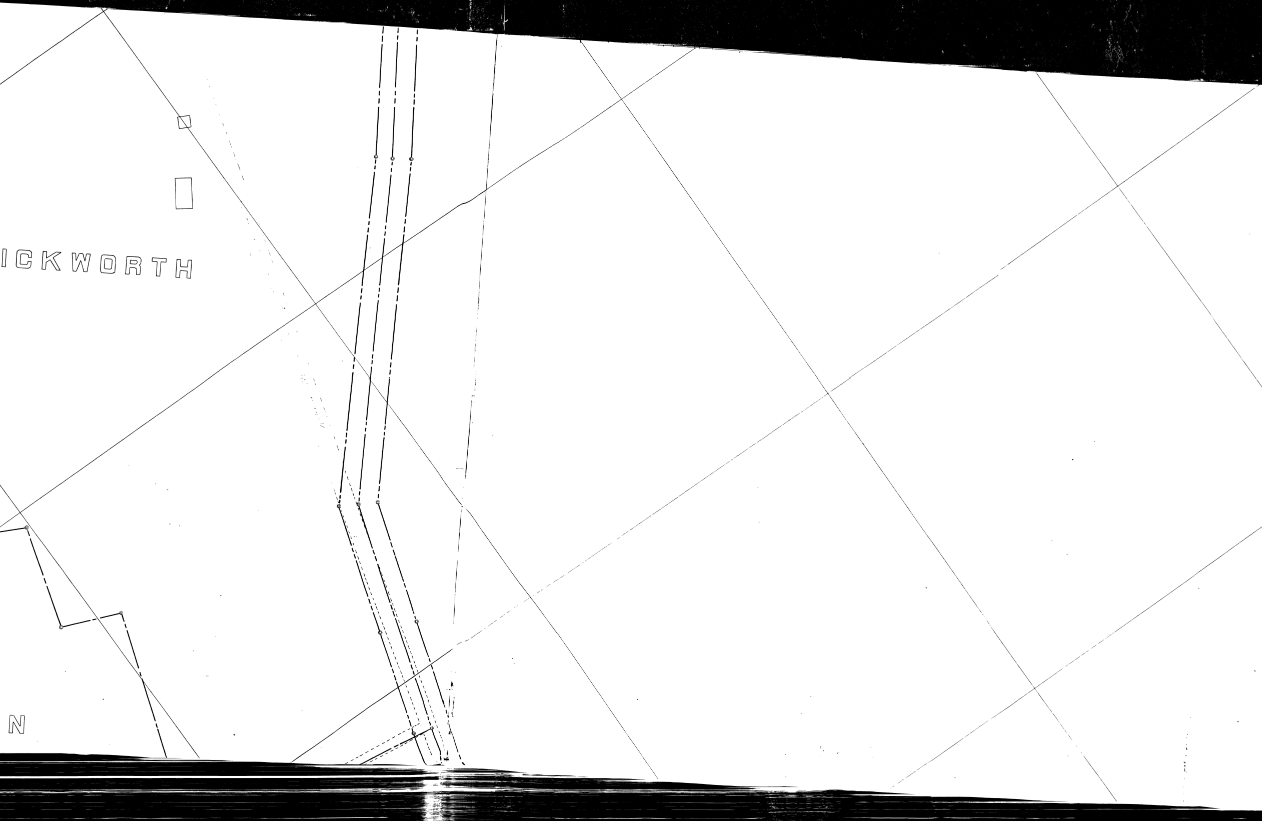
ICKWORTH
N