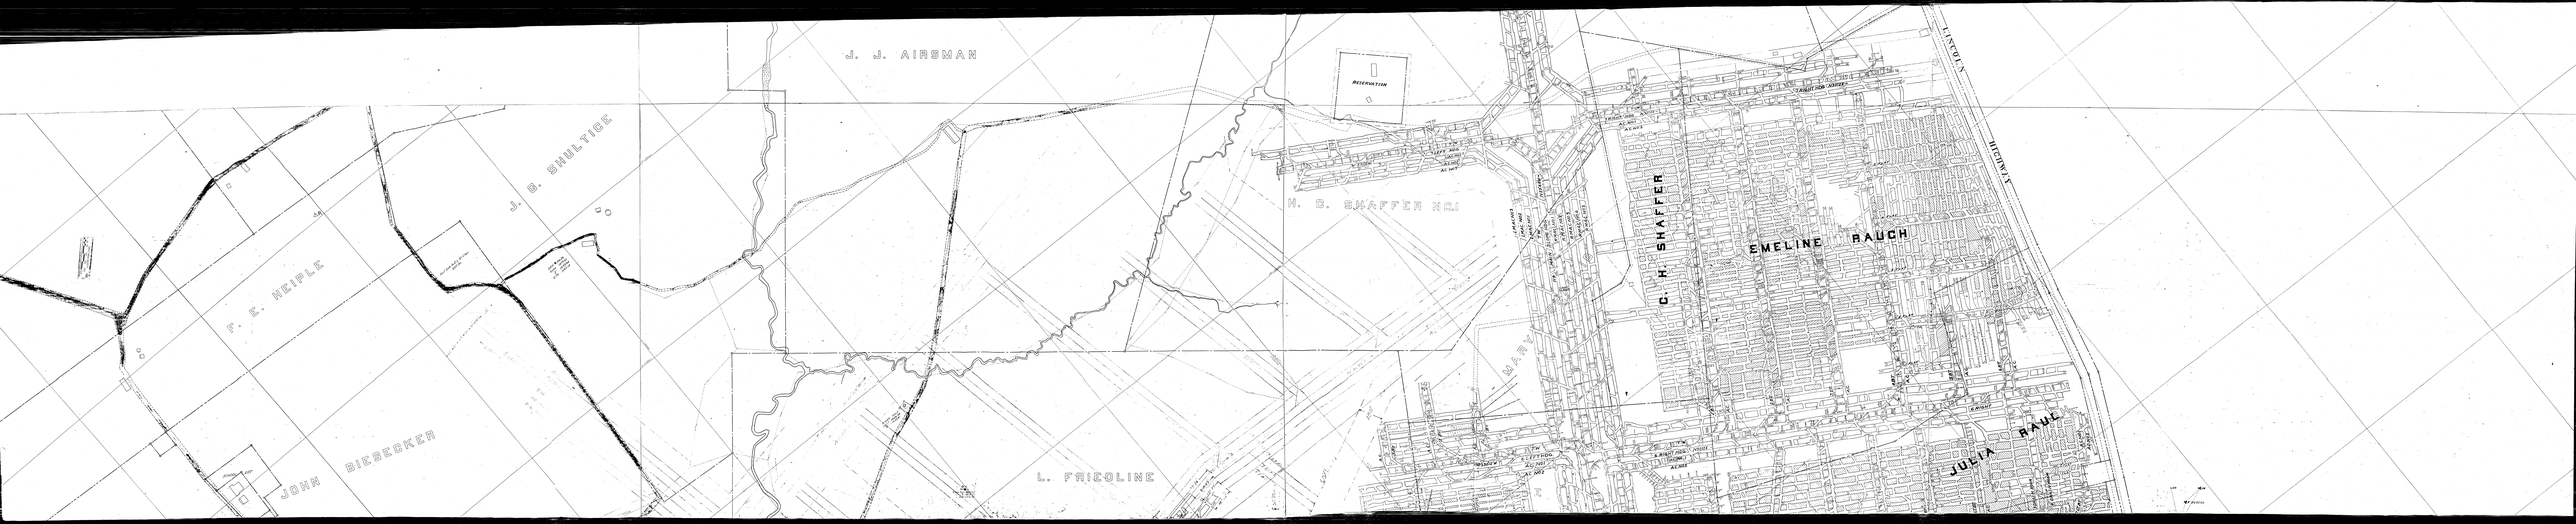
J. J. AIRSMAN
RESERVATION
J. B. SHULTICE
F. E. HEIPLE
C. H. SHAFFER
EMELINE RAUCH
JULIA RAUC
JOHN BIEBECKER
L. FRICOLINE
HIGHWAY