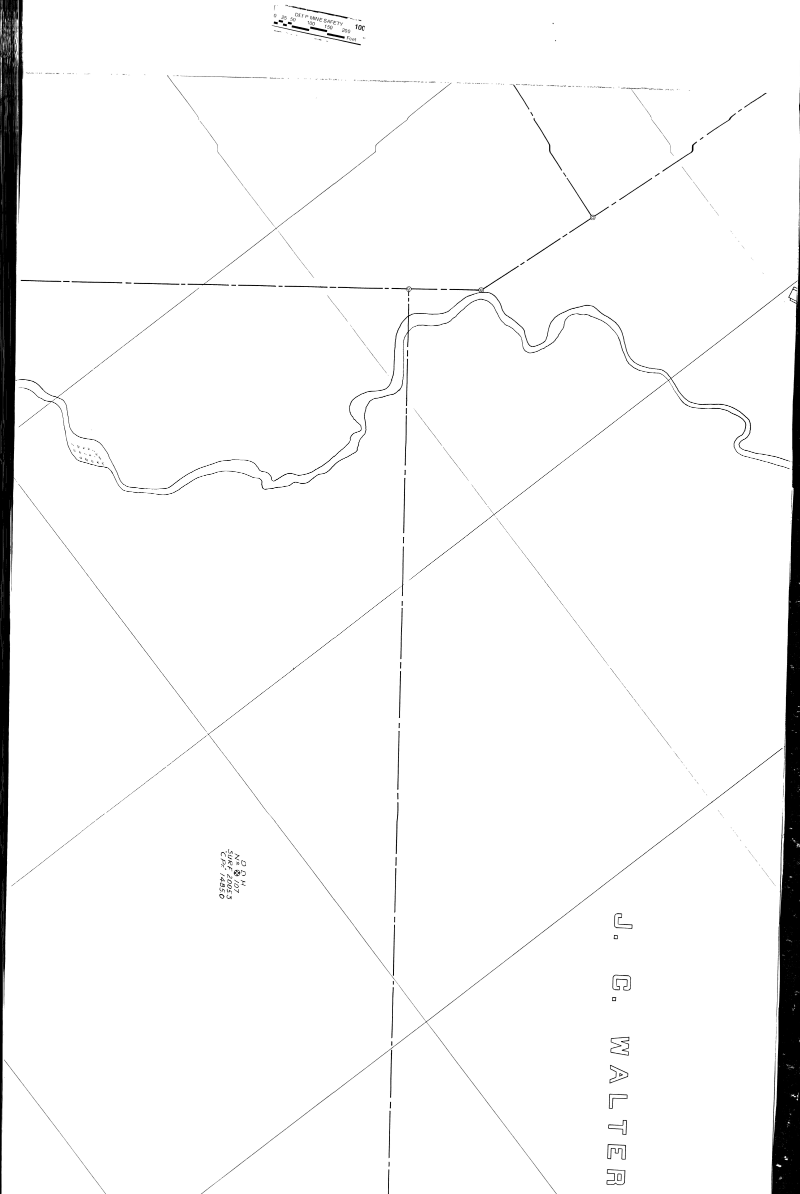
DEEP MINE SAFETY
0
25
50
100
150
200
Feet
100
D.D.H.
№ 107
SURF 2005.3
"C.Pr." 1485.0
J. C. WALTER

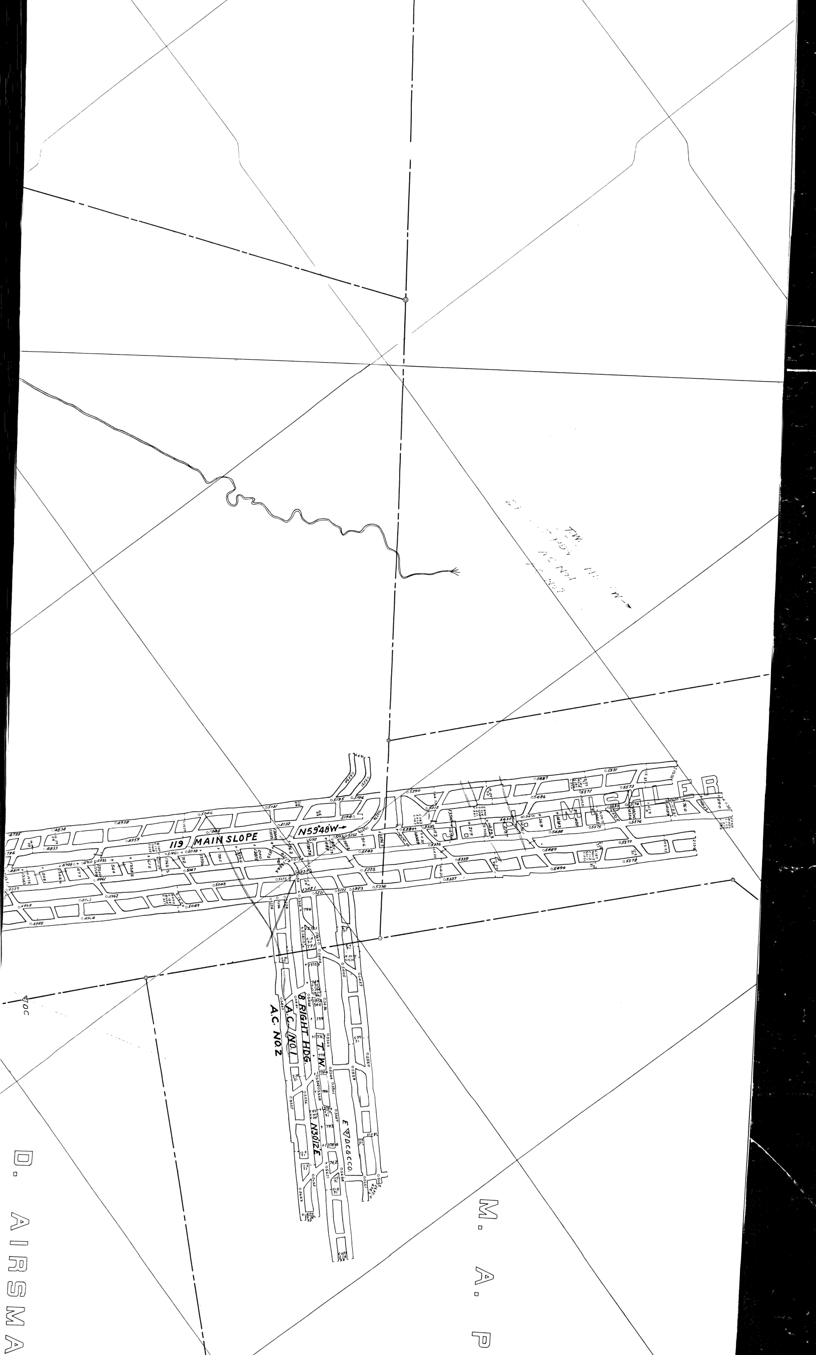
119 MAIN SLOPE
N59°48'W→
J. D. MISHLER
8 RIGHT HDG.
A.C. NO. 1
A.C. NO. 2
T.W.
N30°12'E
E ▽ D.C.&C.CO.
▽ OC
D. AIRSMA
M. A. P

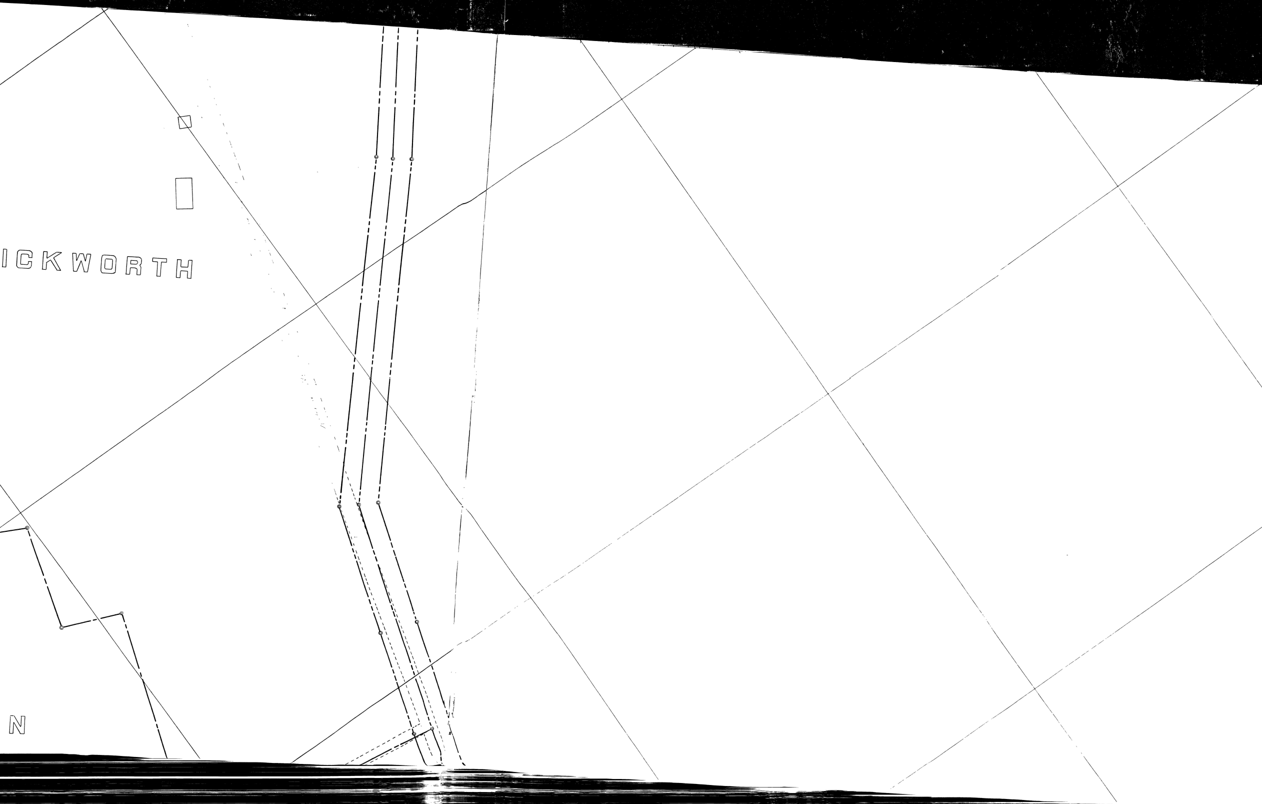
ICKWORTH
N