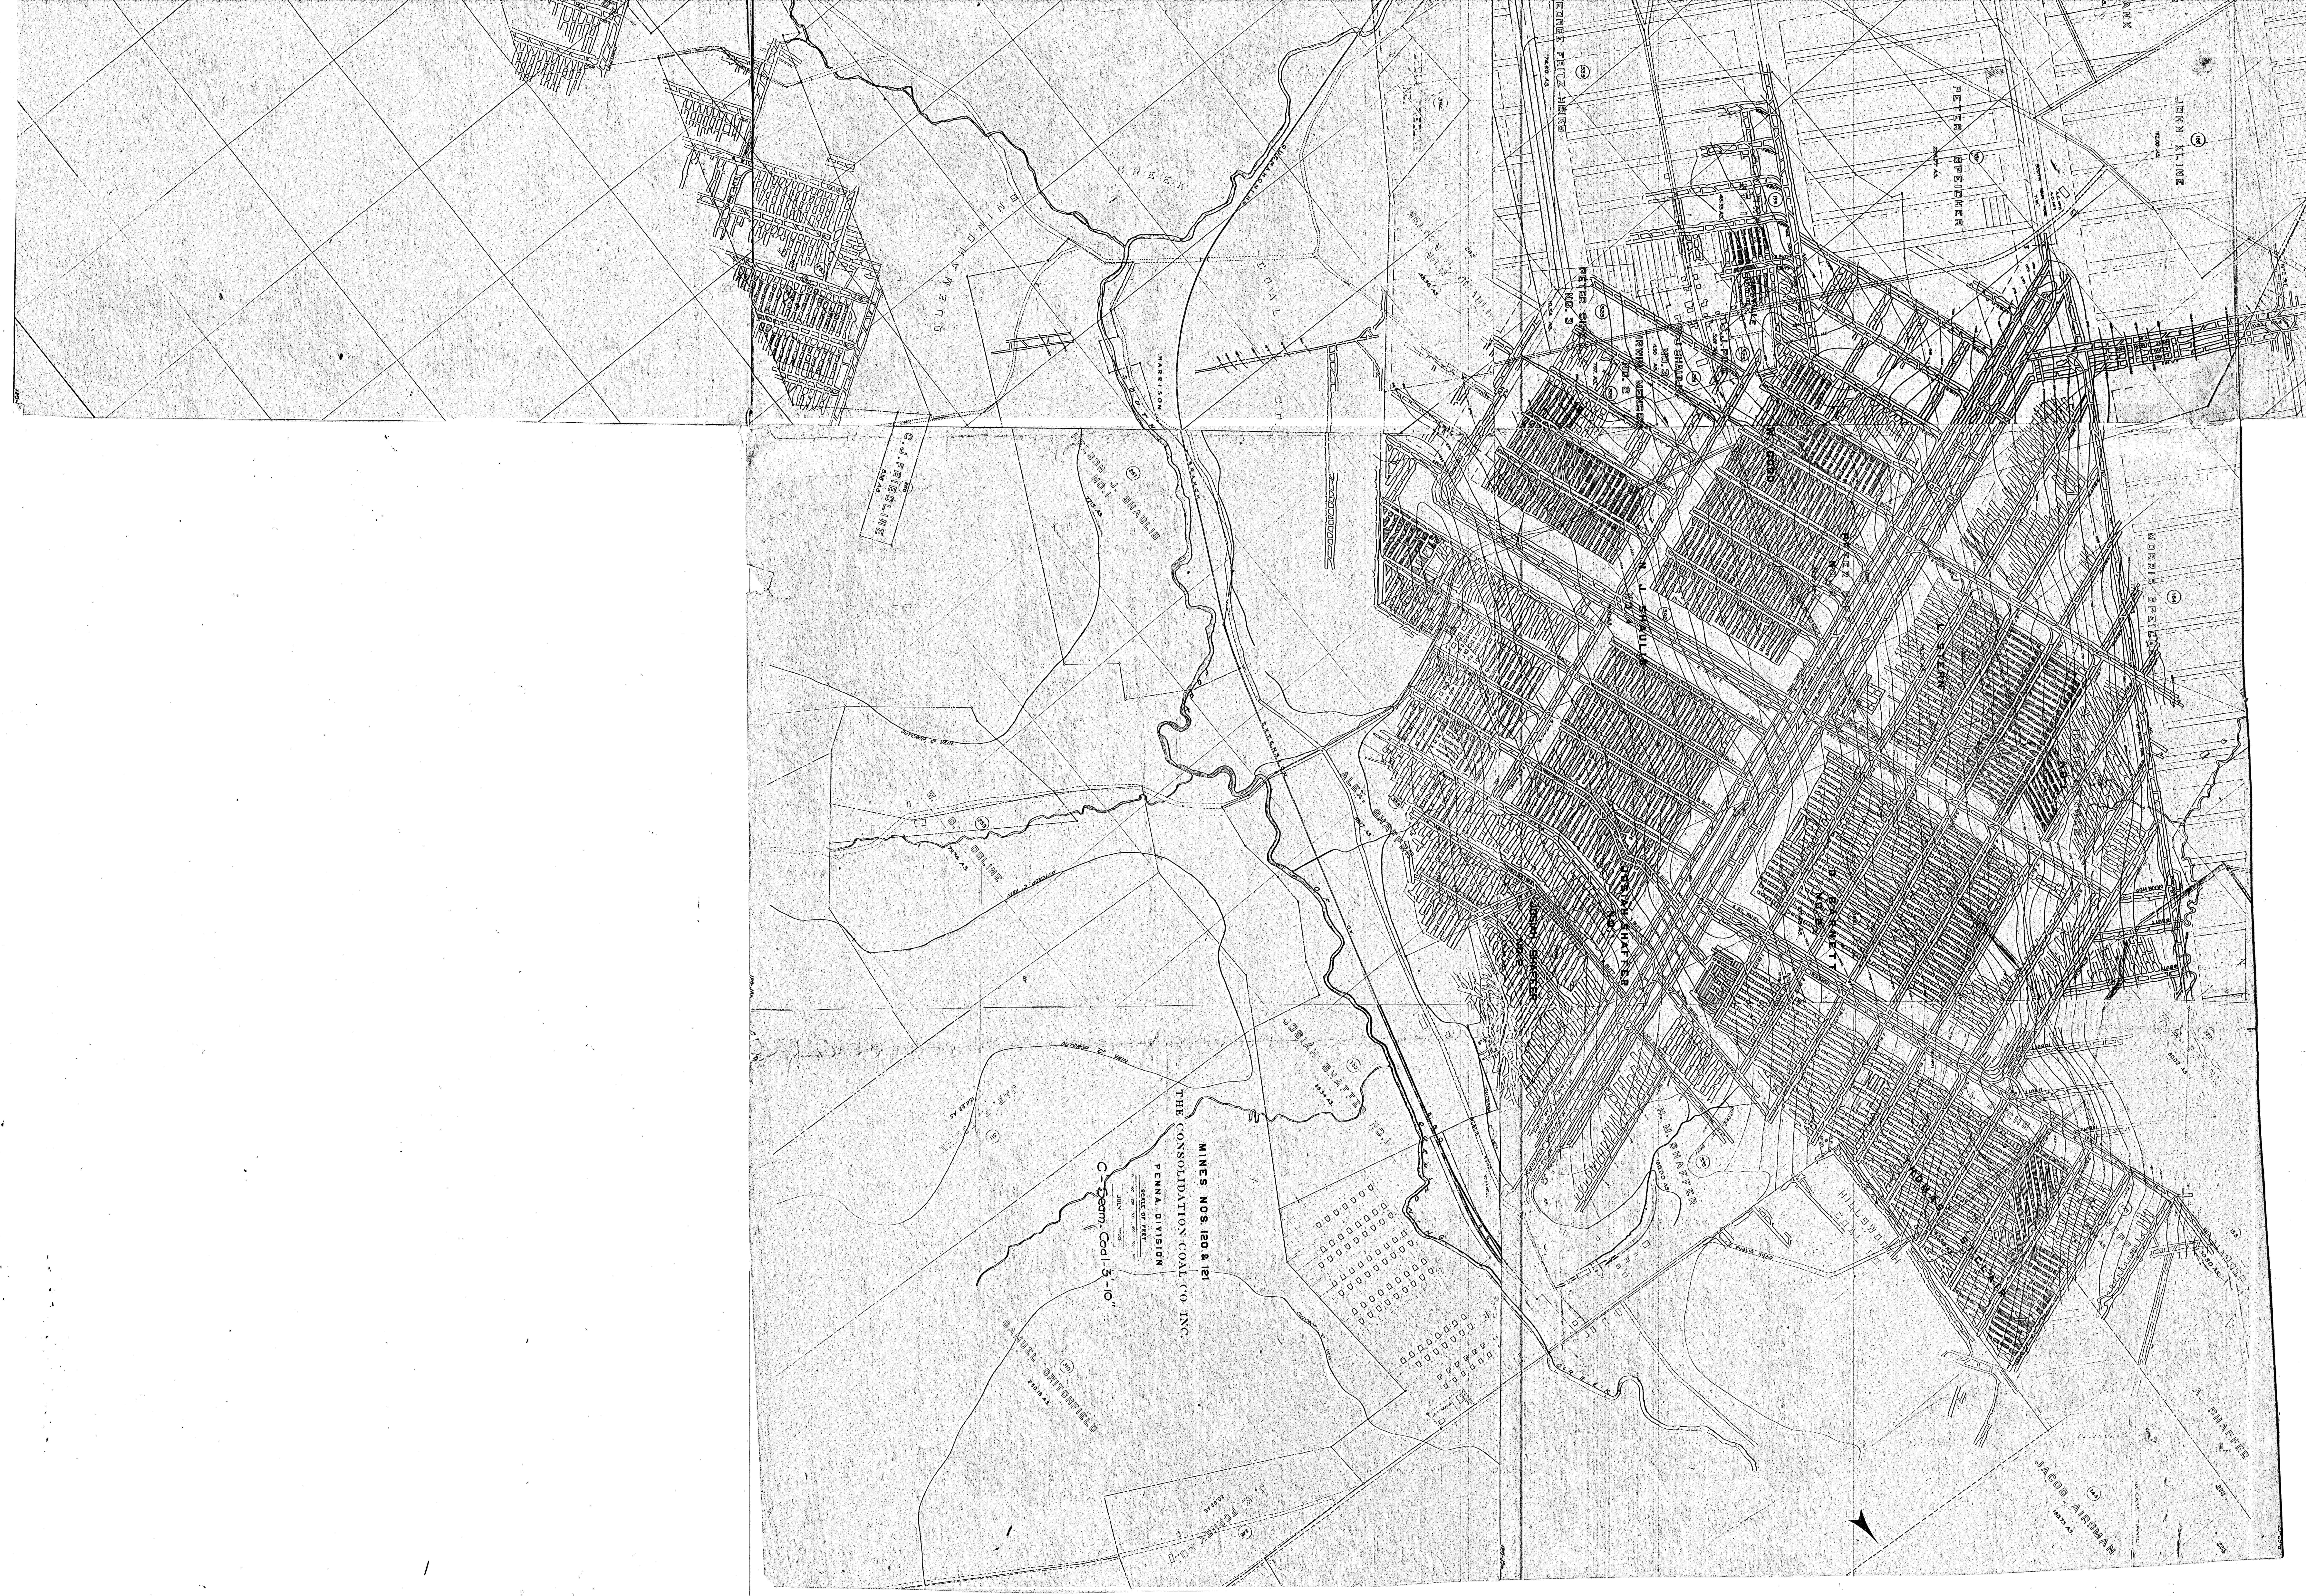

MINES NOS. 120 & 121
THE CONSOLIDATION COAL CO. INC.
PENNA. DIVISION
SCALE OF FEET
JULY 1920

C-Seam-Coal-3'-10"

0 100 200 300 400 500 600
QUEMAHONING CREEK
COAL
SOUTH BRANCH
HARRISON
EXTENSION
GEORGE FRITZ HEIRS
7460 A.S.
PETER SPEICHER
22637 A.S.
JOHN KLINE
16200 A.S.
PETER SHAULIS NO. 3
IRWIN MENSER NO. 2
NO. 3
C.J. FRIEDLINE
J. SHAULIS NO. 1
N. J. SHAULIS NO. 4
PETER
L. STERN
MORRIS SPEICHER
ALEX. SHAFFER
JOSIAH SHAFFER NO. 1
D. BARNETT NO. 5
W. G. OGLINE
OUTCROP "C" VEIN
JOSIAH SHAFFER NO. 1
M. M. SHAFFER
18000 A.S.
HILLSWORTH COAL CO.
PUBLIC ROAD
THOMAS ST. CLAIR
A. SHAFFER
2060 A.S.
JACOB AIRSMAN
18273 A.S.
SAMUEL CRITCHFIELD
250.18 A.S.
J. K. FORNEY NO. 1
310
8002 A.S.