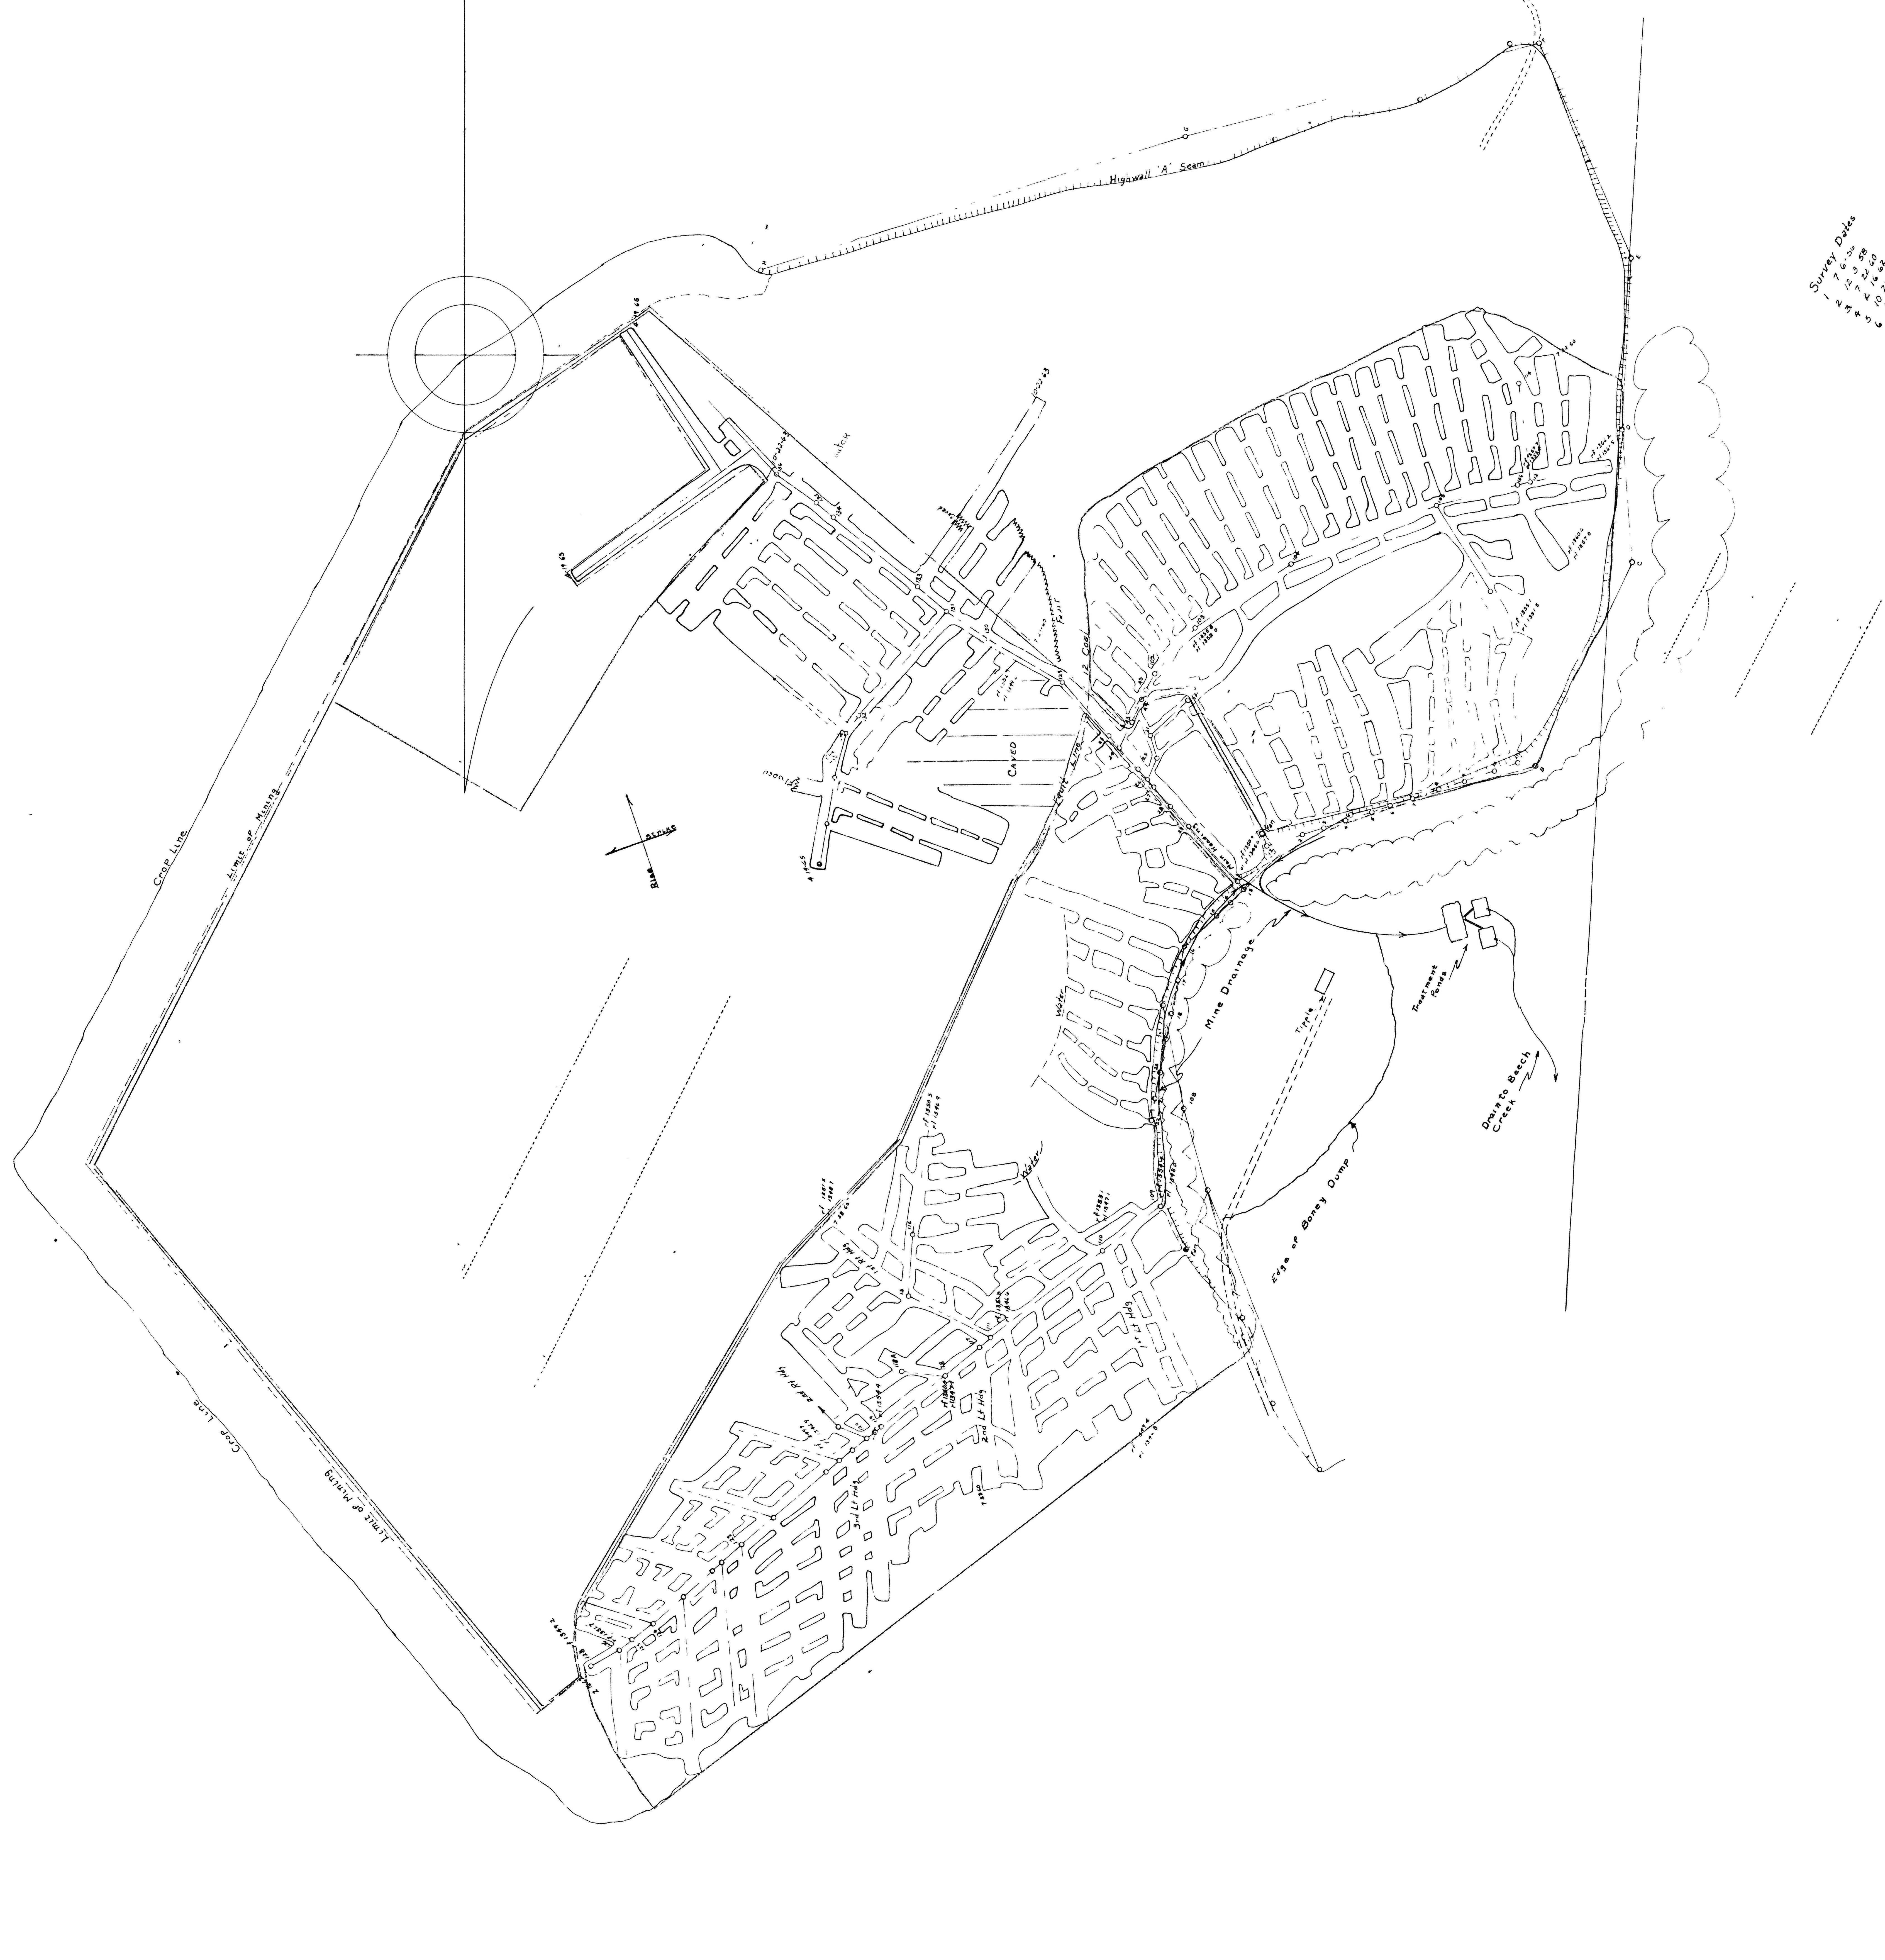

Survey Dates
1 7 6-56
2 12 3 58
3 7 22 60
4 2 16 62
5 10 22-63
6 4-19-65

MINE DRAINAGE DATA
1 10-24-66

Legend
The boundaries of the area of surface land overlying the mine
The extent of which mineing operations have been completed
The extent to which mineing operations will be conducted under this permit
Area to be mined in the next 6 months April 15, 1967 to October 15, 1967

Legend
Existing Highwall
Spoil Area
100' Crop Barrier

C & C COAL CO.

Operation DEEP MINE
Local Area KATO
Township SNOW SHOE
County CENTRE
Scale 1" = 100'
Prepared by W.S.M. & E.R.L. & F.J.S. Date 12-18-58

ALLEN G. BUTLER
REG PROFESSIONAL CIVIL ENGINEER

300378

PENNA DEPT OF MINES - BUREAU OF MINE SUBSIDENCE
REC'D
MAY 15 1967