


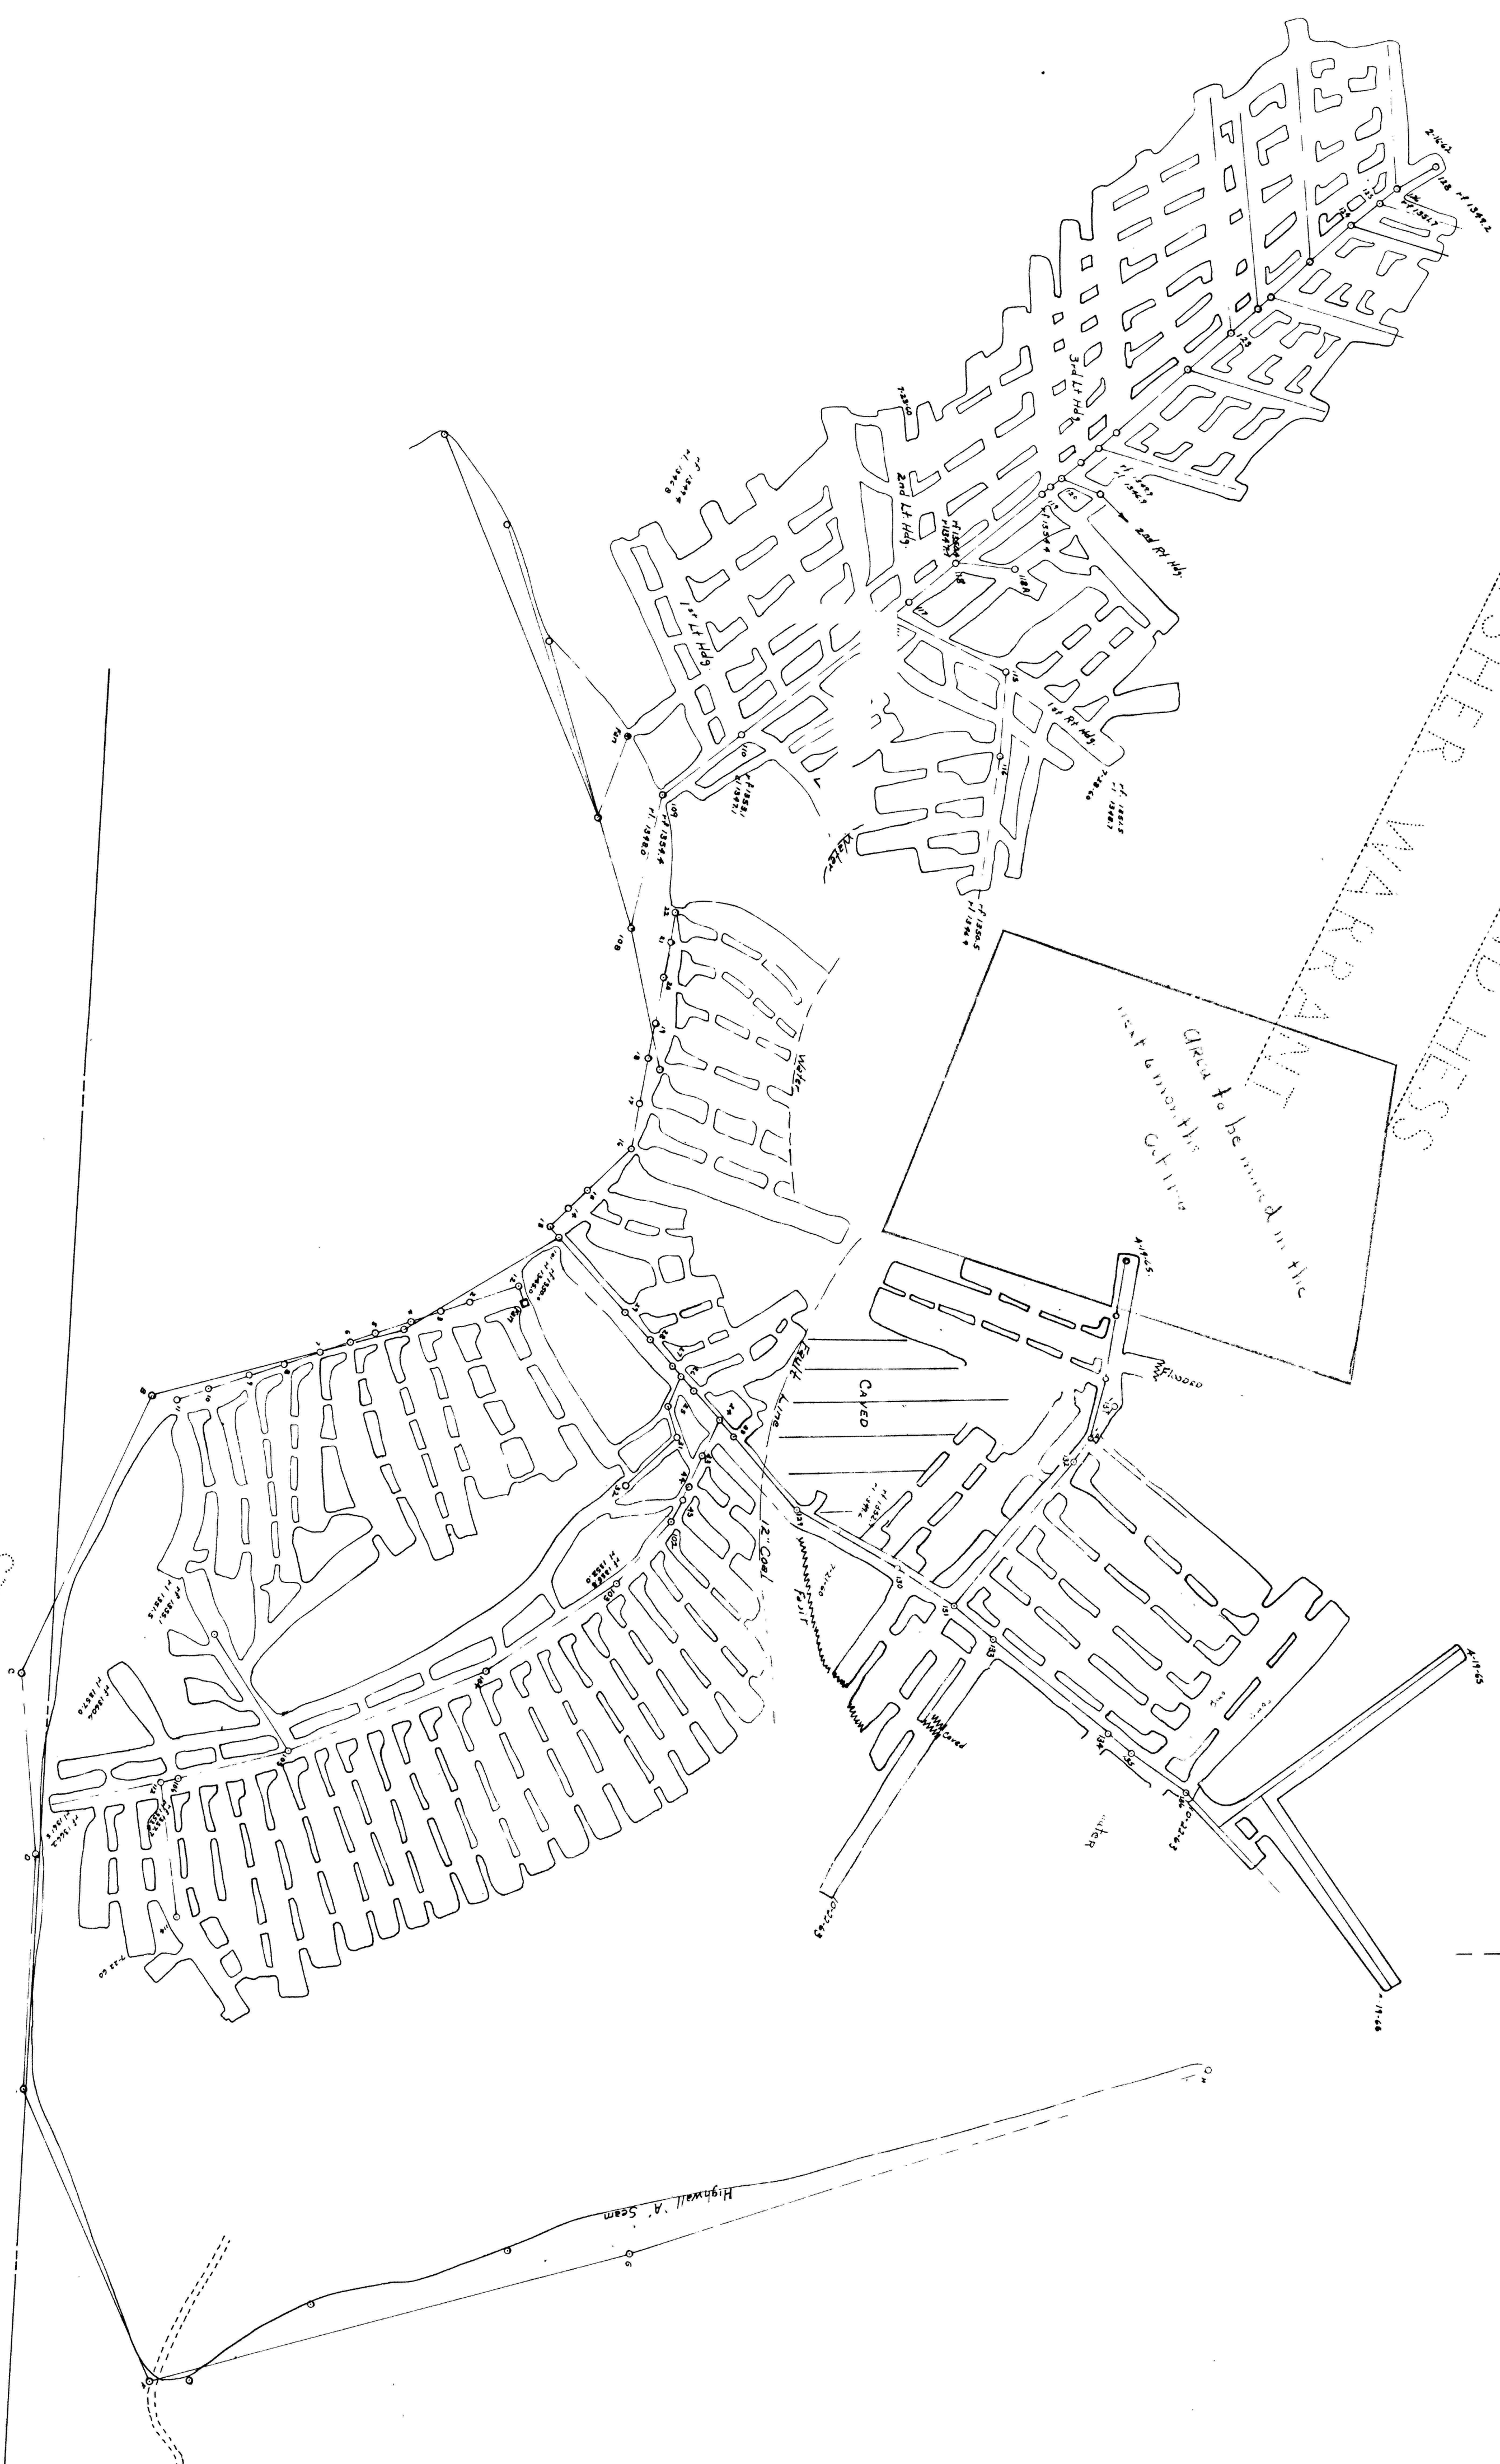

LITKE AND HESS
FISHER WARRANT

STATE
GAME
LANDS



