


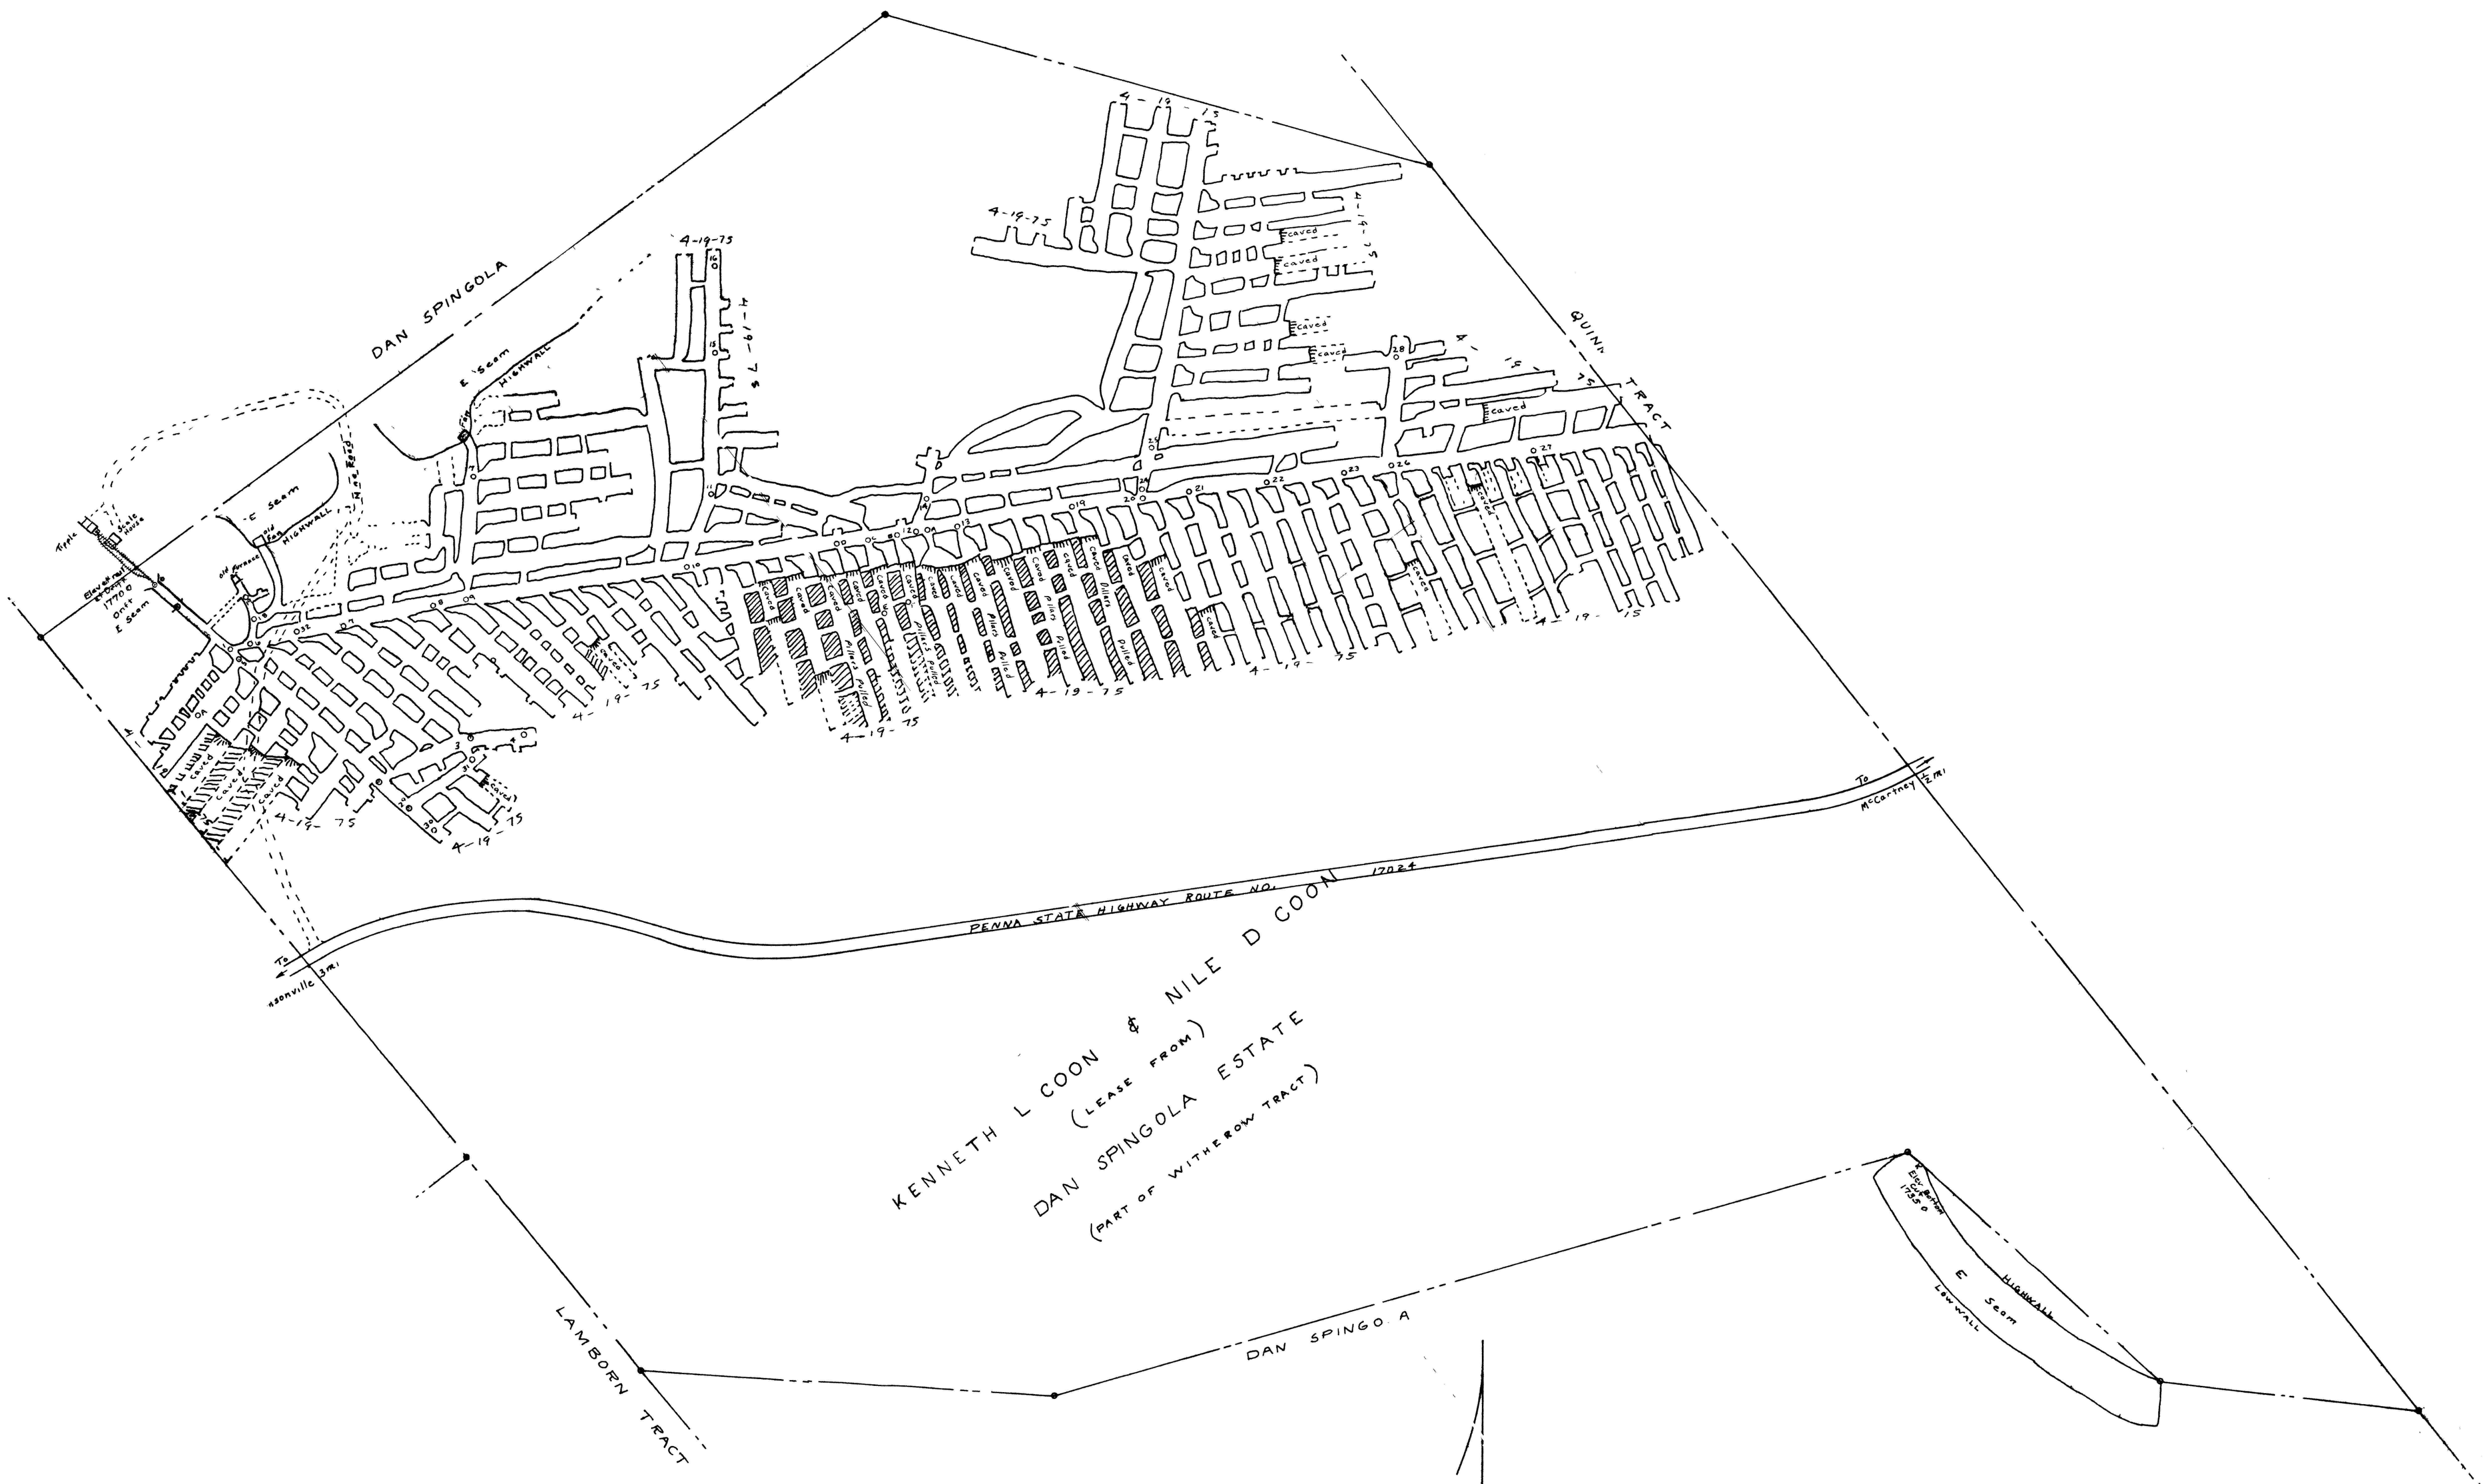

KENNETH L. COON AND NILE D. COON
CLEARFIELD, PA RD 2
MINE & COAL LAND
JORDAN TWP CLFD CO, PA
CLEARFIELD, PA
DEC 17, 1986
APRIL 19, 1975
SCALE 1"=100'
REG SURVEYOR

Kenneth L. Coon & Nile D. Coon
Nile D. Coon

E SEAM
MINE CLOSURE
FINAL MAP