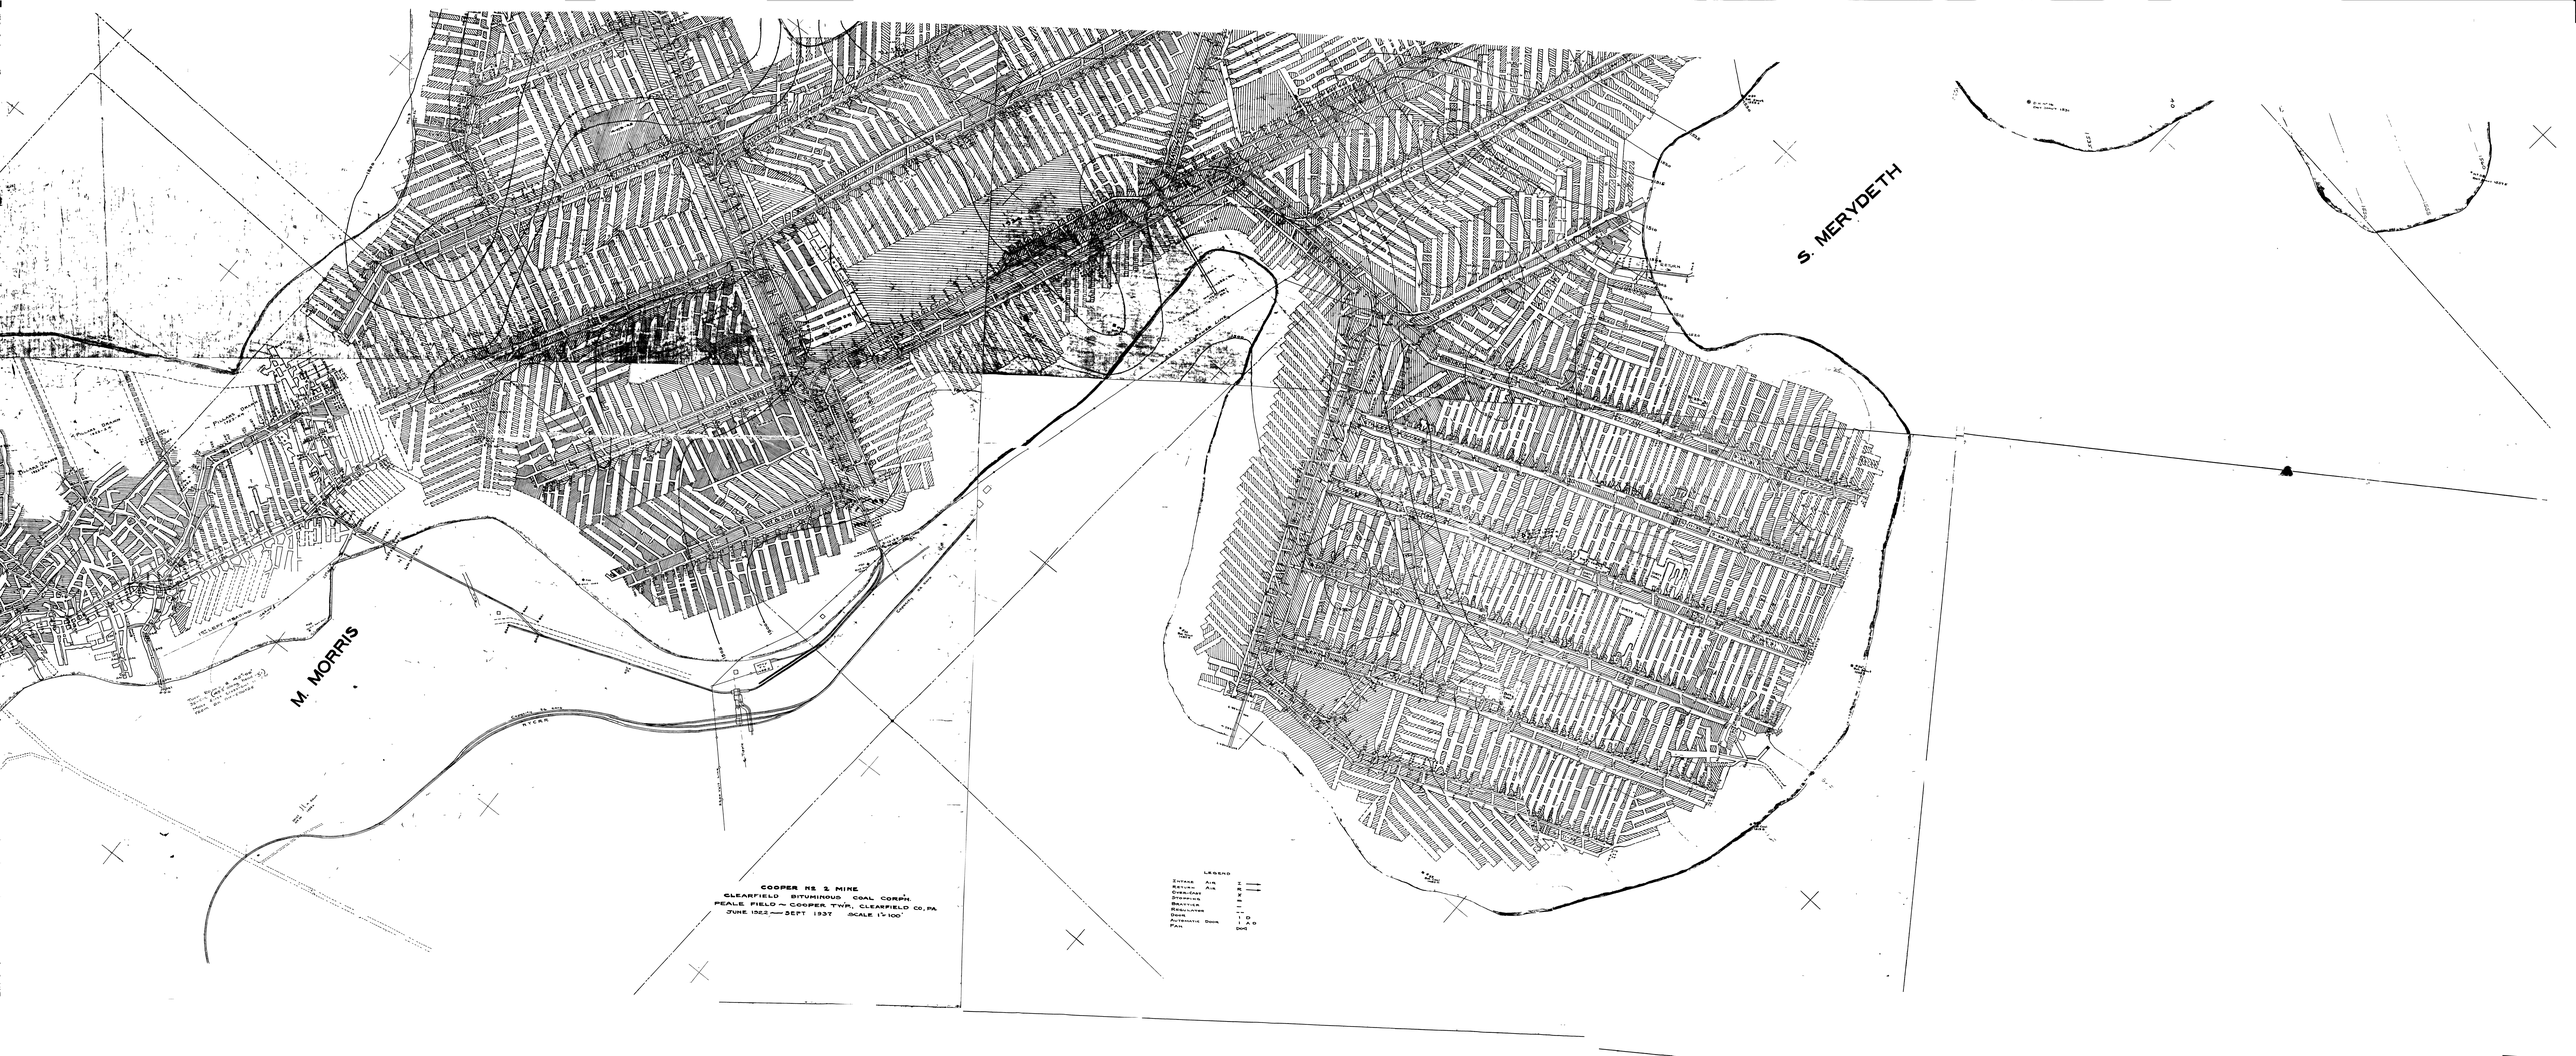


COOPER RE 2 MINE
CLEARFIELD BITUMINOUS COAL CORP.
PEALE FIELD — COOPER TWP., CLEARFIELD CO., PA
JUNE 1962 — SEPT 1937 SCALE 1"= 100'