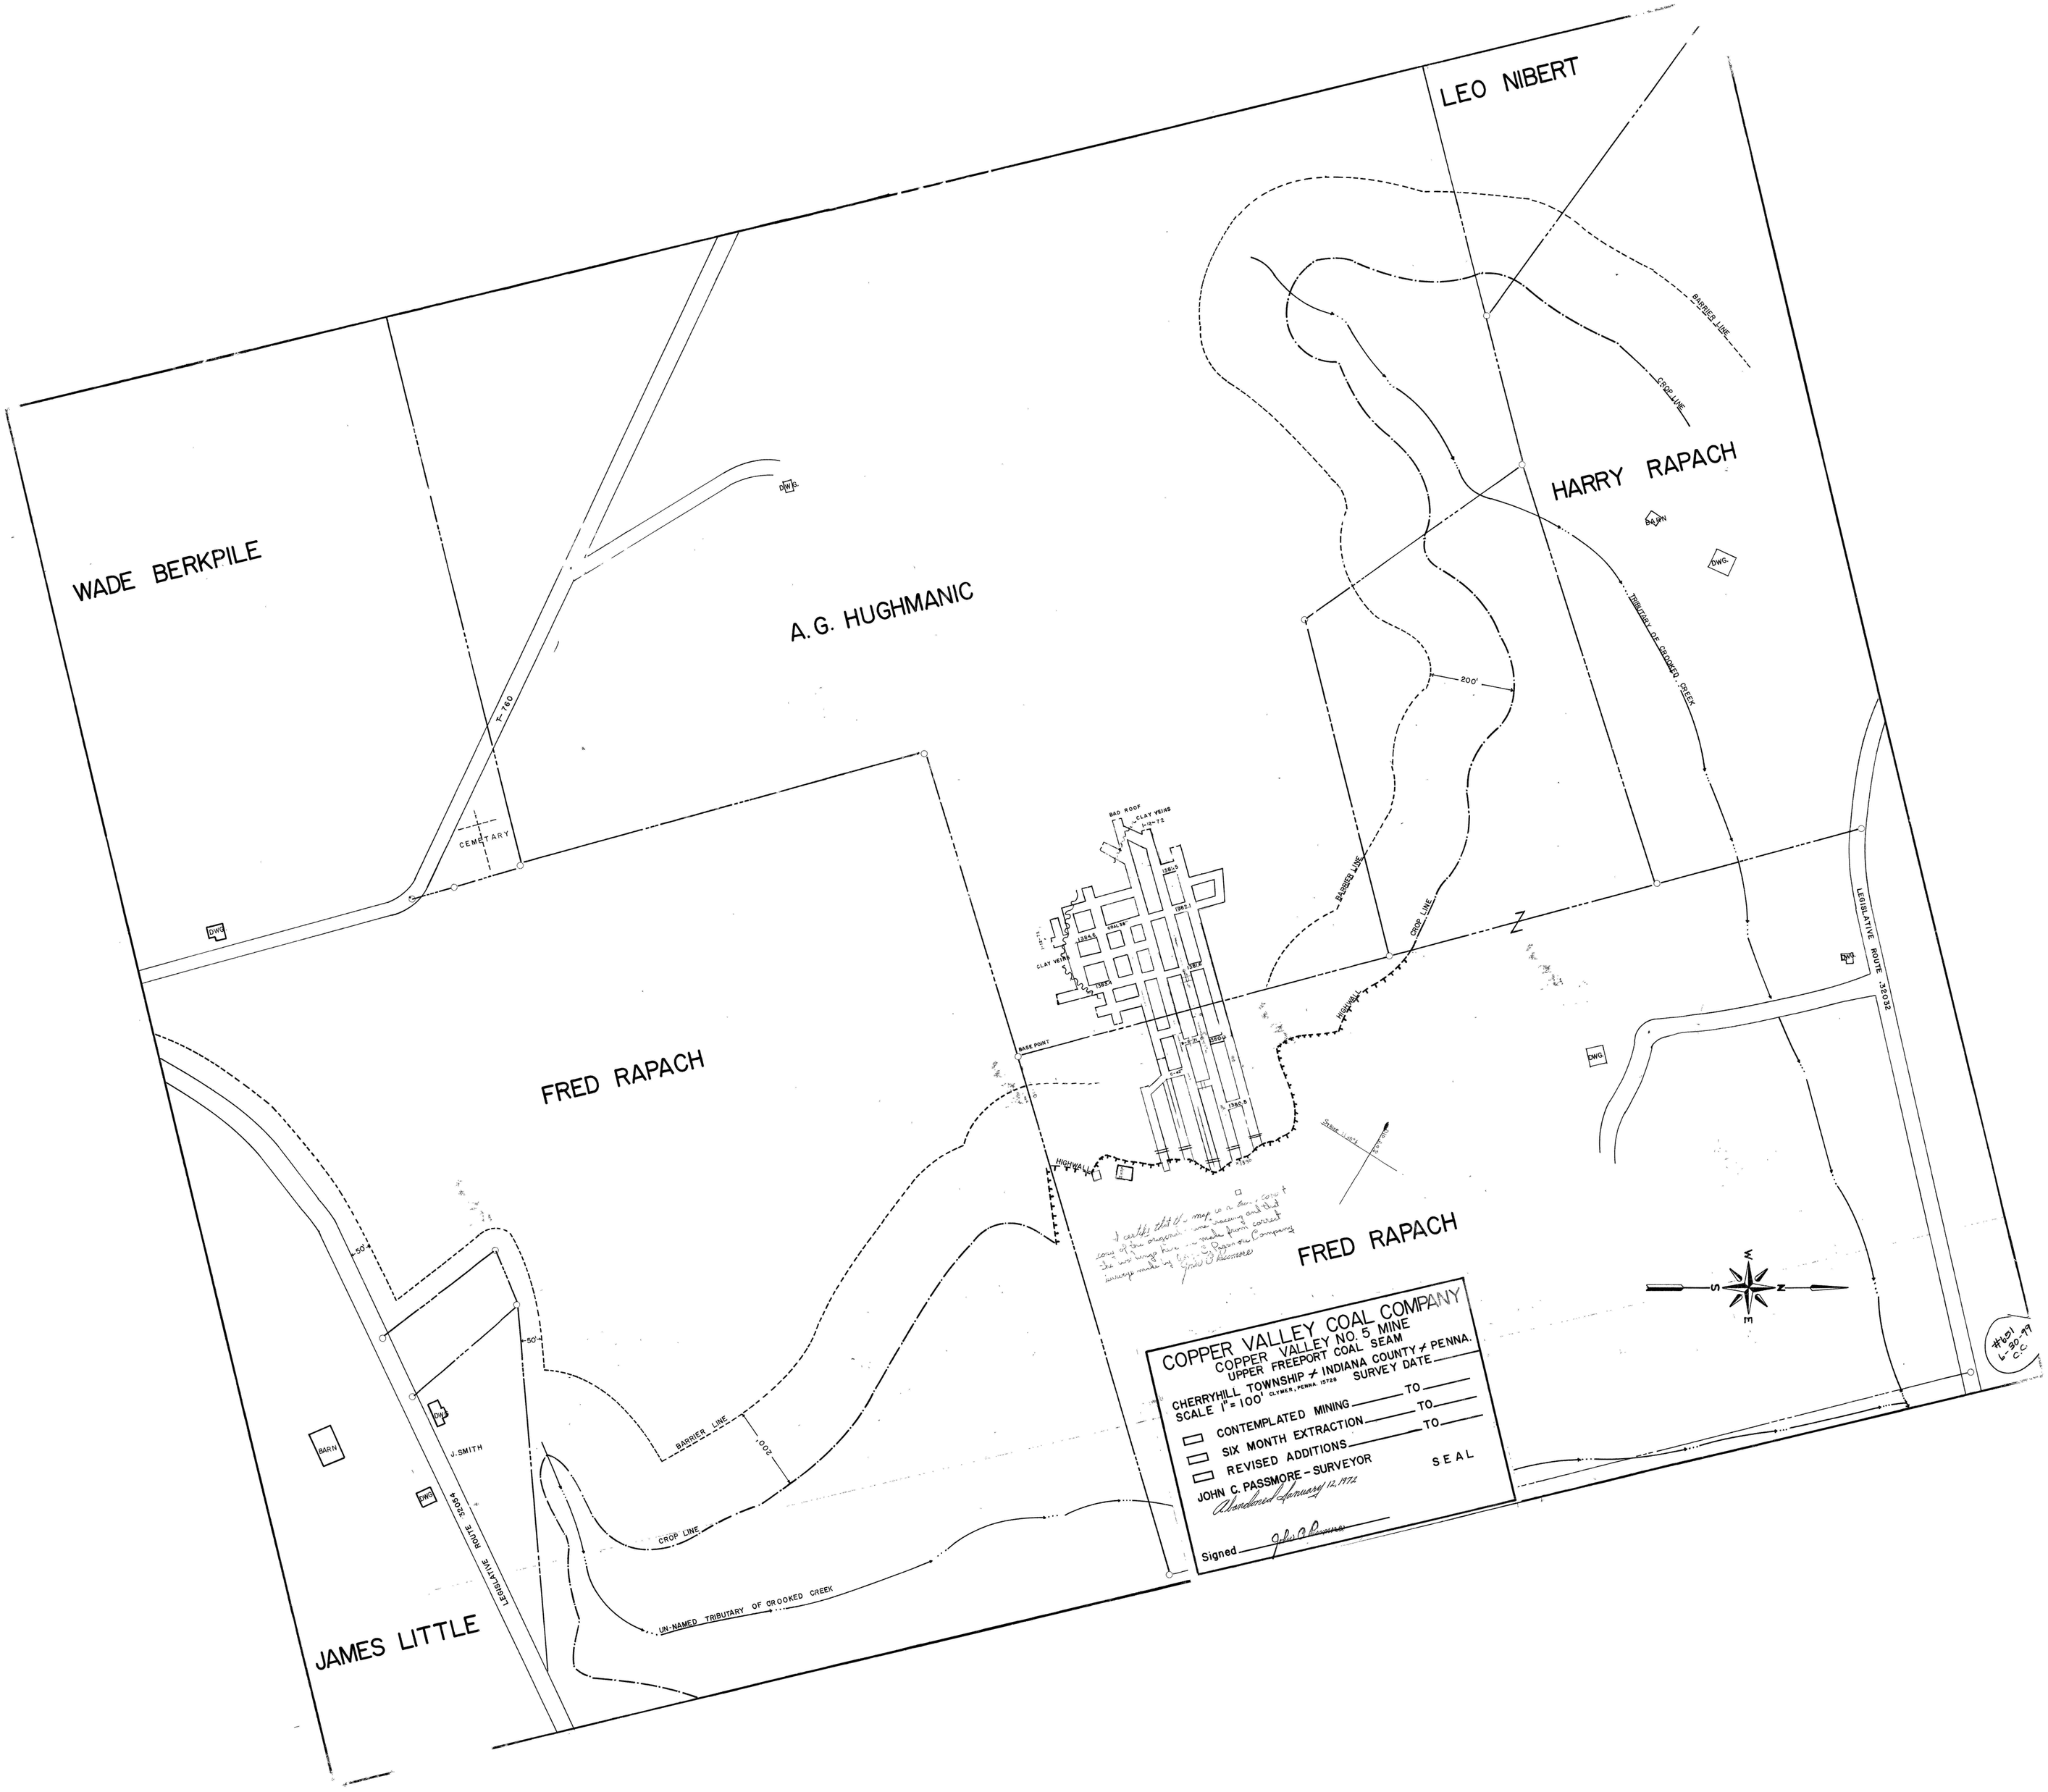
WADE BERKPILE
A. G. HUGHMANIC
LEO NIBERT
HARRY RAPACH
FRED RAPACH
FRED RAPACH
JAMES LITTLE
J. SMITH
BARN
DWG.
CEMETARY
BARRIER LINE
CROP LINE
200'
50'
UN-NAMED TRIBUTARY OF CROOKED CREEK
LEGISLATIVE ROUTE 32084
LEGISLATIVE ROUTE 32032
HIGHWALL
BASE POINT
BAD ROOF
CLAY VEINS
COAL 38"
1-18-72
1381.5
1382.5
