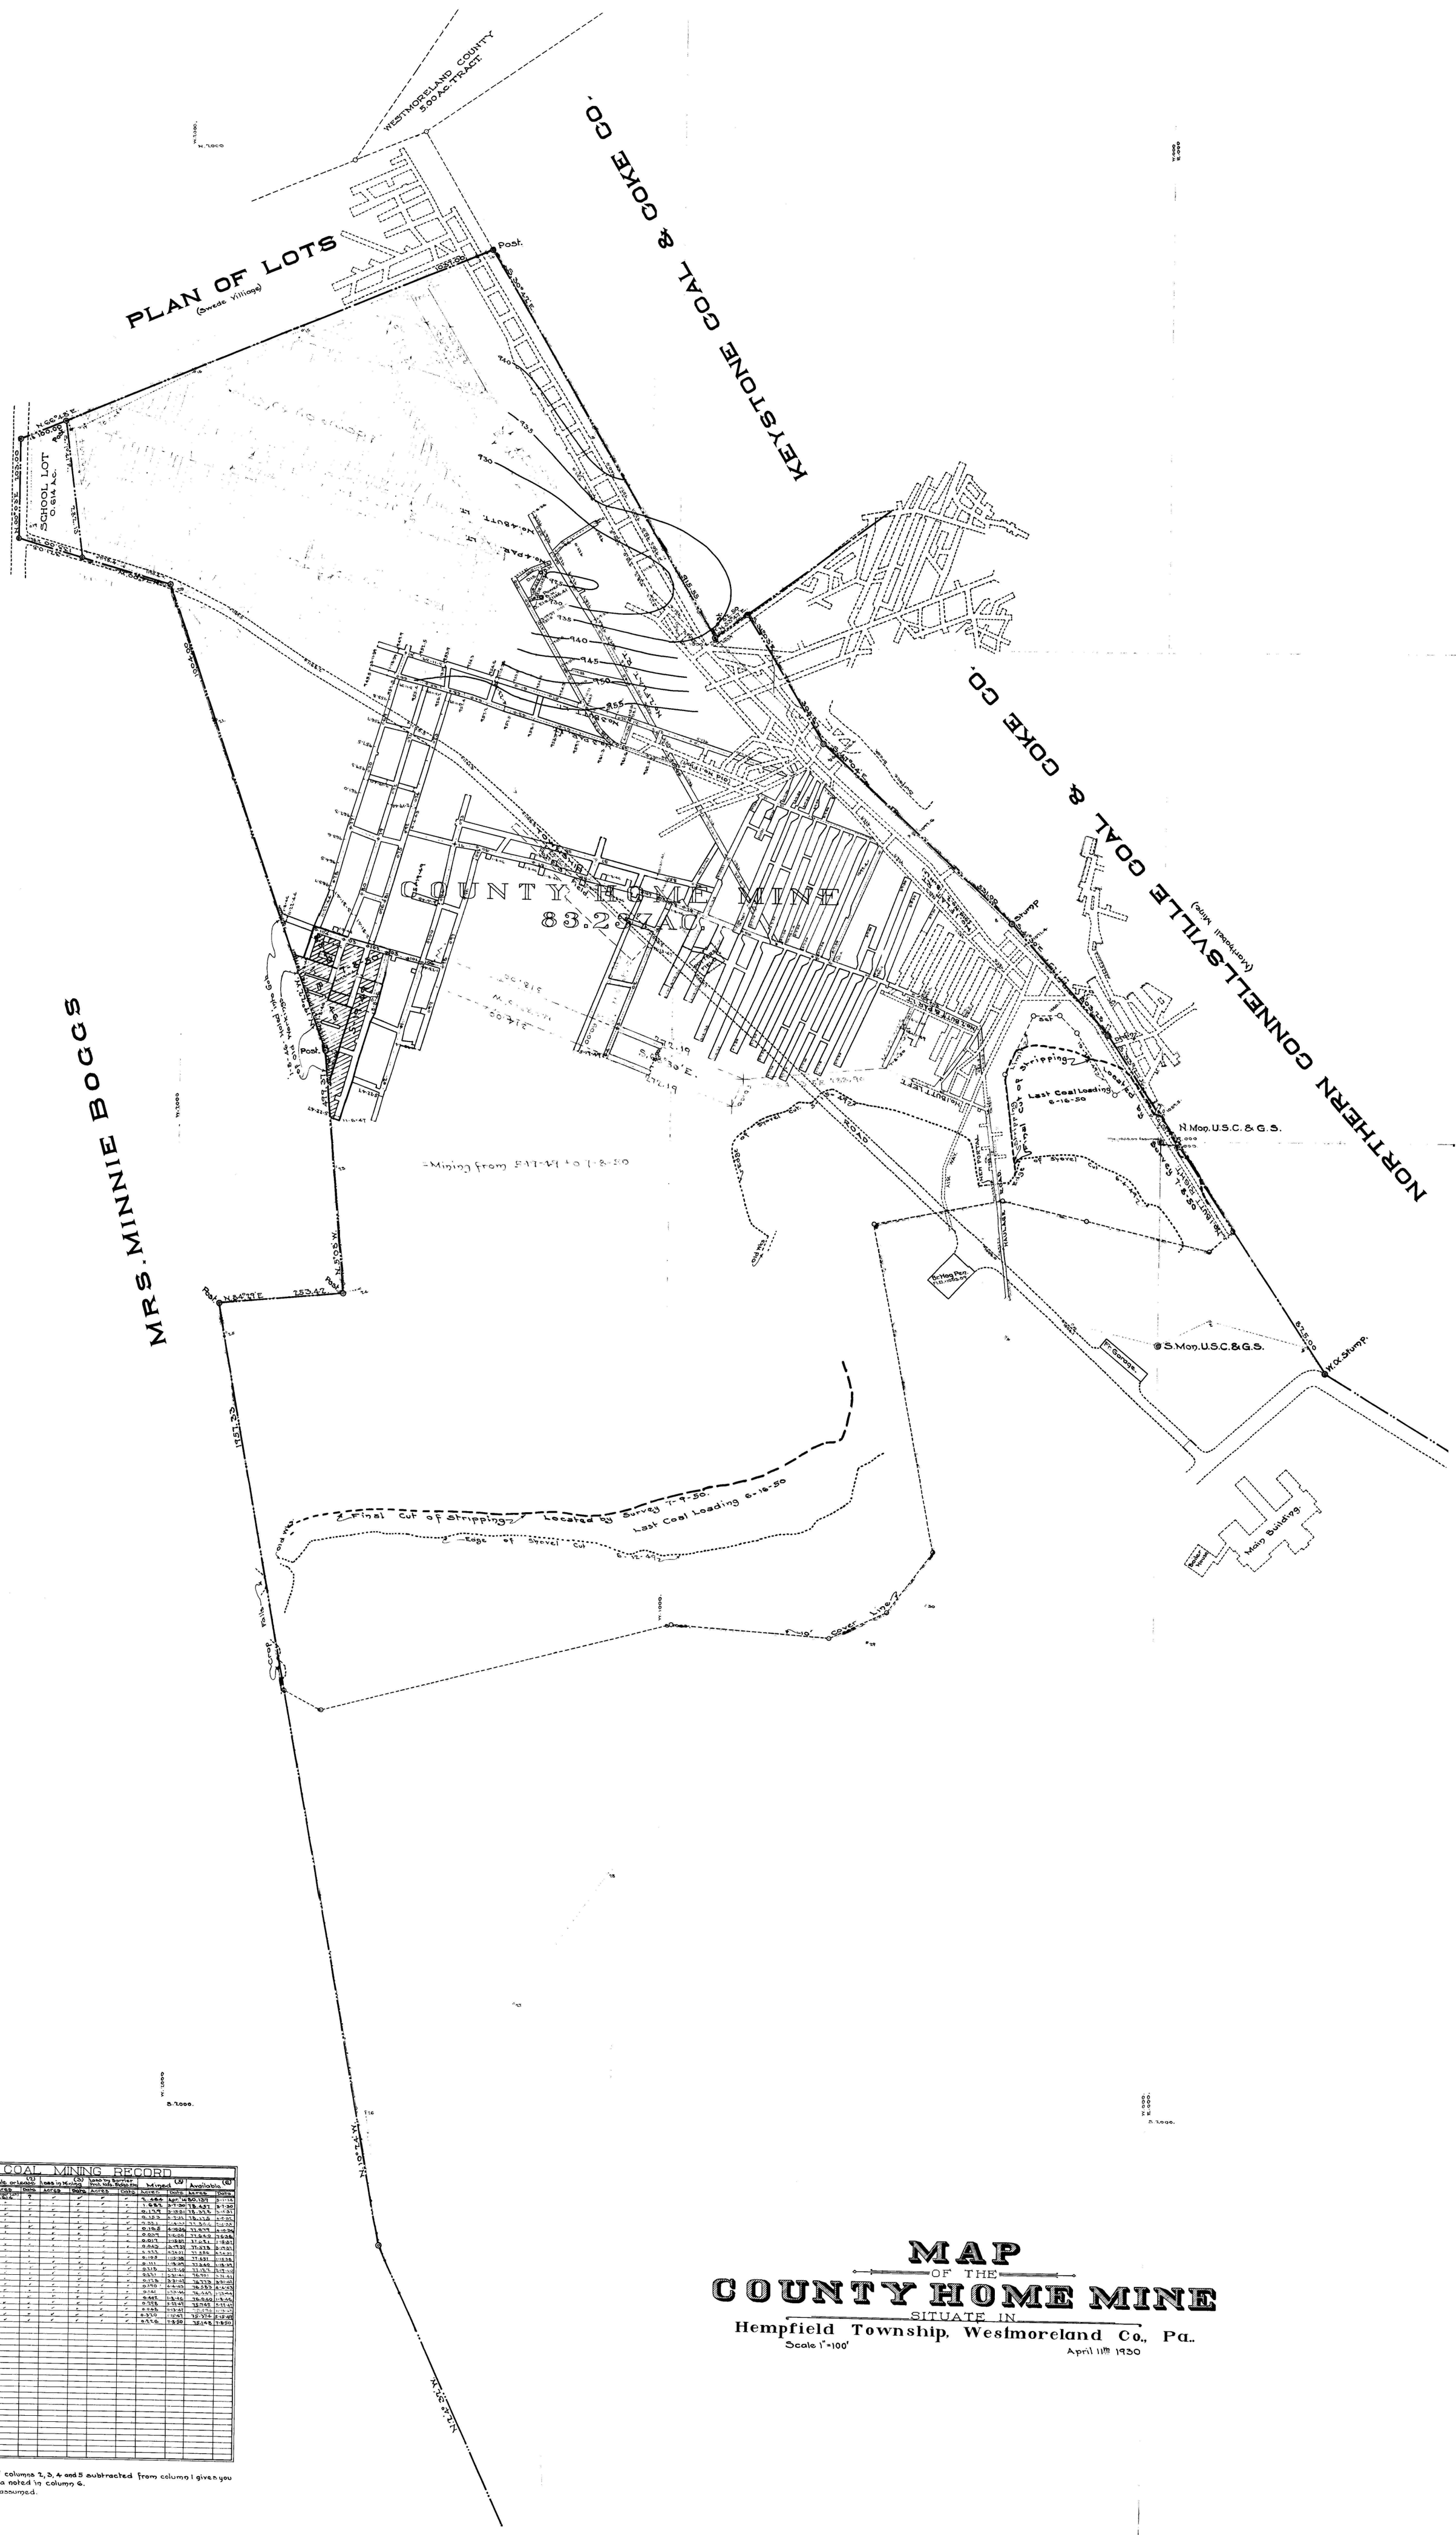

COAL MINING RECORD											
Original or (1) Available		(2) Sale or Lease		(3) Loss in Mining		(4) Loss by Barrier Pros. Rds. Bldgs. Etc		(5) Mined		(6) Available	
Acres	Date.	Acres	Date	Acres	Date	Acres	Date	Acres	Date	Acres	Date
83.237	?	Reserved 0.614	?	✓	✓	✓	✓	2.484	Apr. 14	80.139	3-11-14
80.139	3-11-14	✓	✓	✓	✓	✓	✓	1.682	3-7-30	78.457	3-7-30
78.457	3-7-30	✓	✓	✓	✓	✓	✓	0.179	3-18-31	78.278	3-18-31
78.278	3-18-31	✓	✓	✓	✓	✓	✓	0.123	4-7-33	78.115	4-7-33
78.115	4-7-33	✓	✓	✓	✓	✓	✓	0.221	11-4-33	77.894	11-4-33
77.894	11-4-33	✓	✓	✓	✓	✓	✓	0.195	4-10-36	77.699	4-10-36
77.699	4-10-36	✓	✓	✓	✓	✓	✓	0.059	1-15-38	77.640	1-15-38
77.640	1-15-38	✓	✓	✓	✓	✓	✓	0.017	1-18-37	77.621	1-18-37
77.621	1-18-37	✓	✓	✓	✓	✓	✓	0.043	3-19-37	77.578	3-19-37
77.578	3-19-37	✓	✓	✓	✓	✓	✓	0.333	4-14-37	77.244	4-14-37
77.244	4-14-37	✓	✓	✓	✓	✓	✓	0.103	1-15-38	77.141	1-15-38
								0.226	7-8-50	75.148	7-8-50

Note:-
The sum of columns 2, 3, 4 and 5 subtracted from column 1 gives you the available area noted in column 6.
Elevations assumed.

MAP
OF THE
COUNTY HOME MINE
SITUATE IN
Hempfield Township, Westmoreland Co., Pa.

Scale 1" = 100'

April 11th 1930