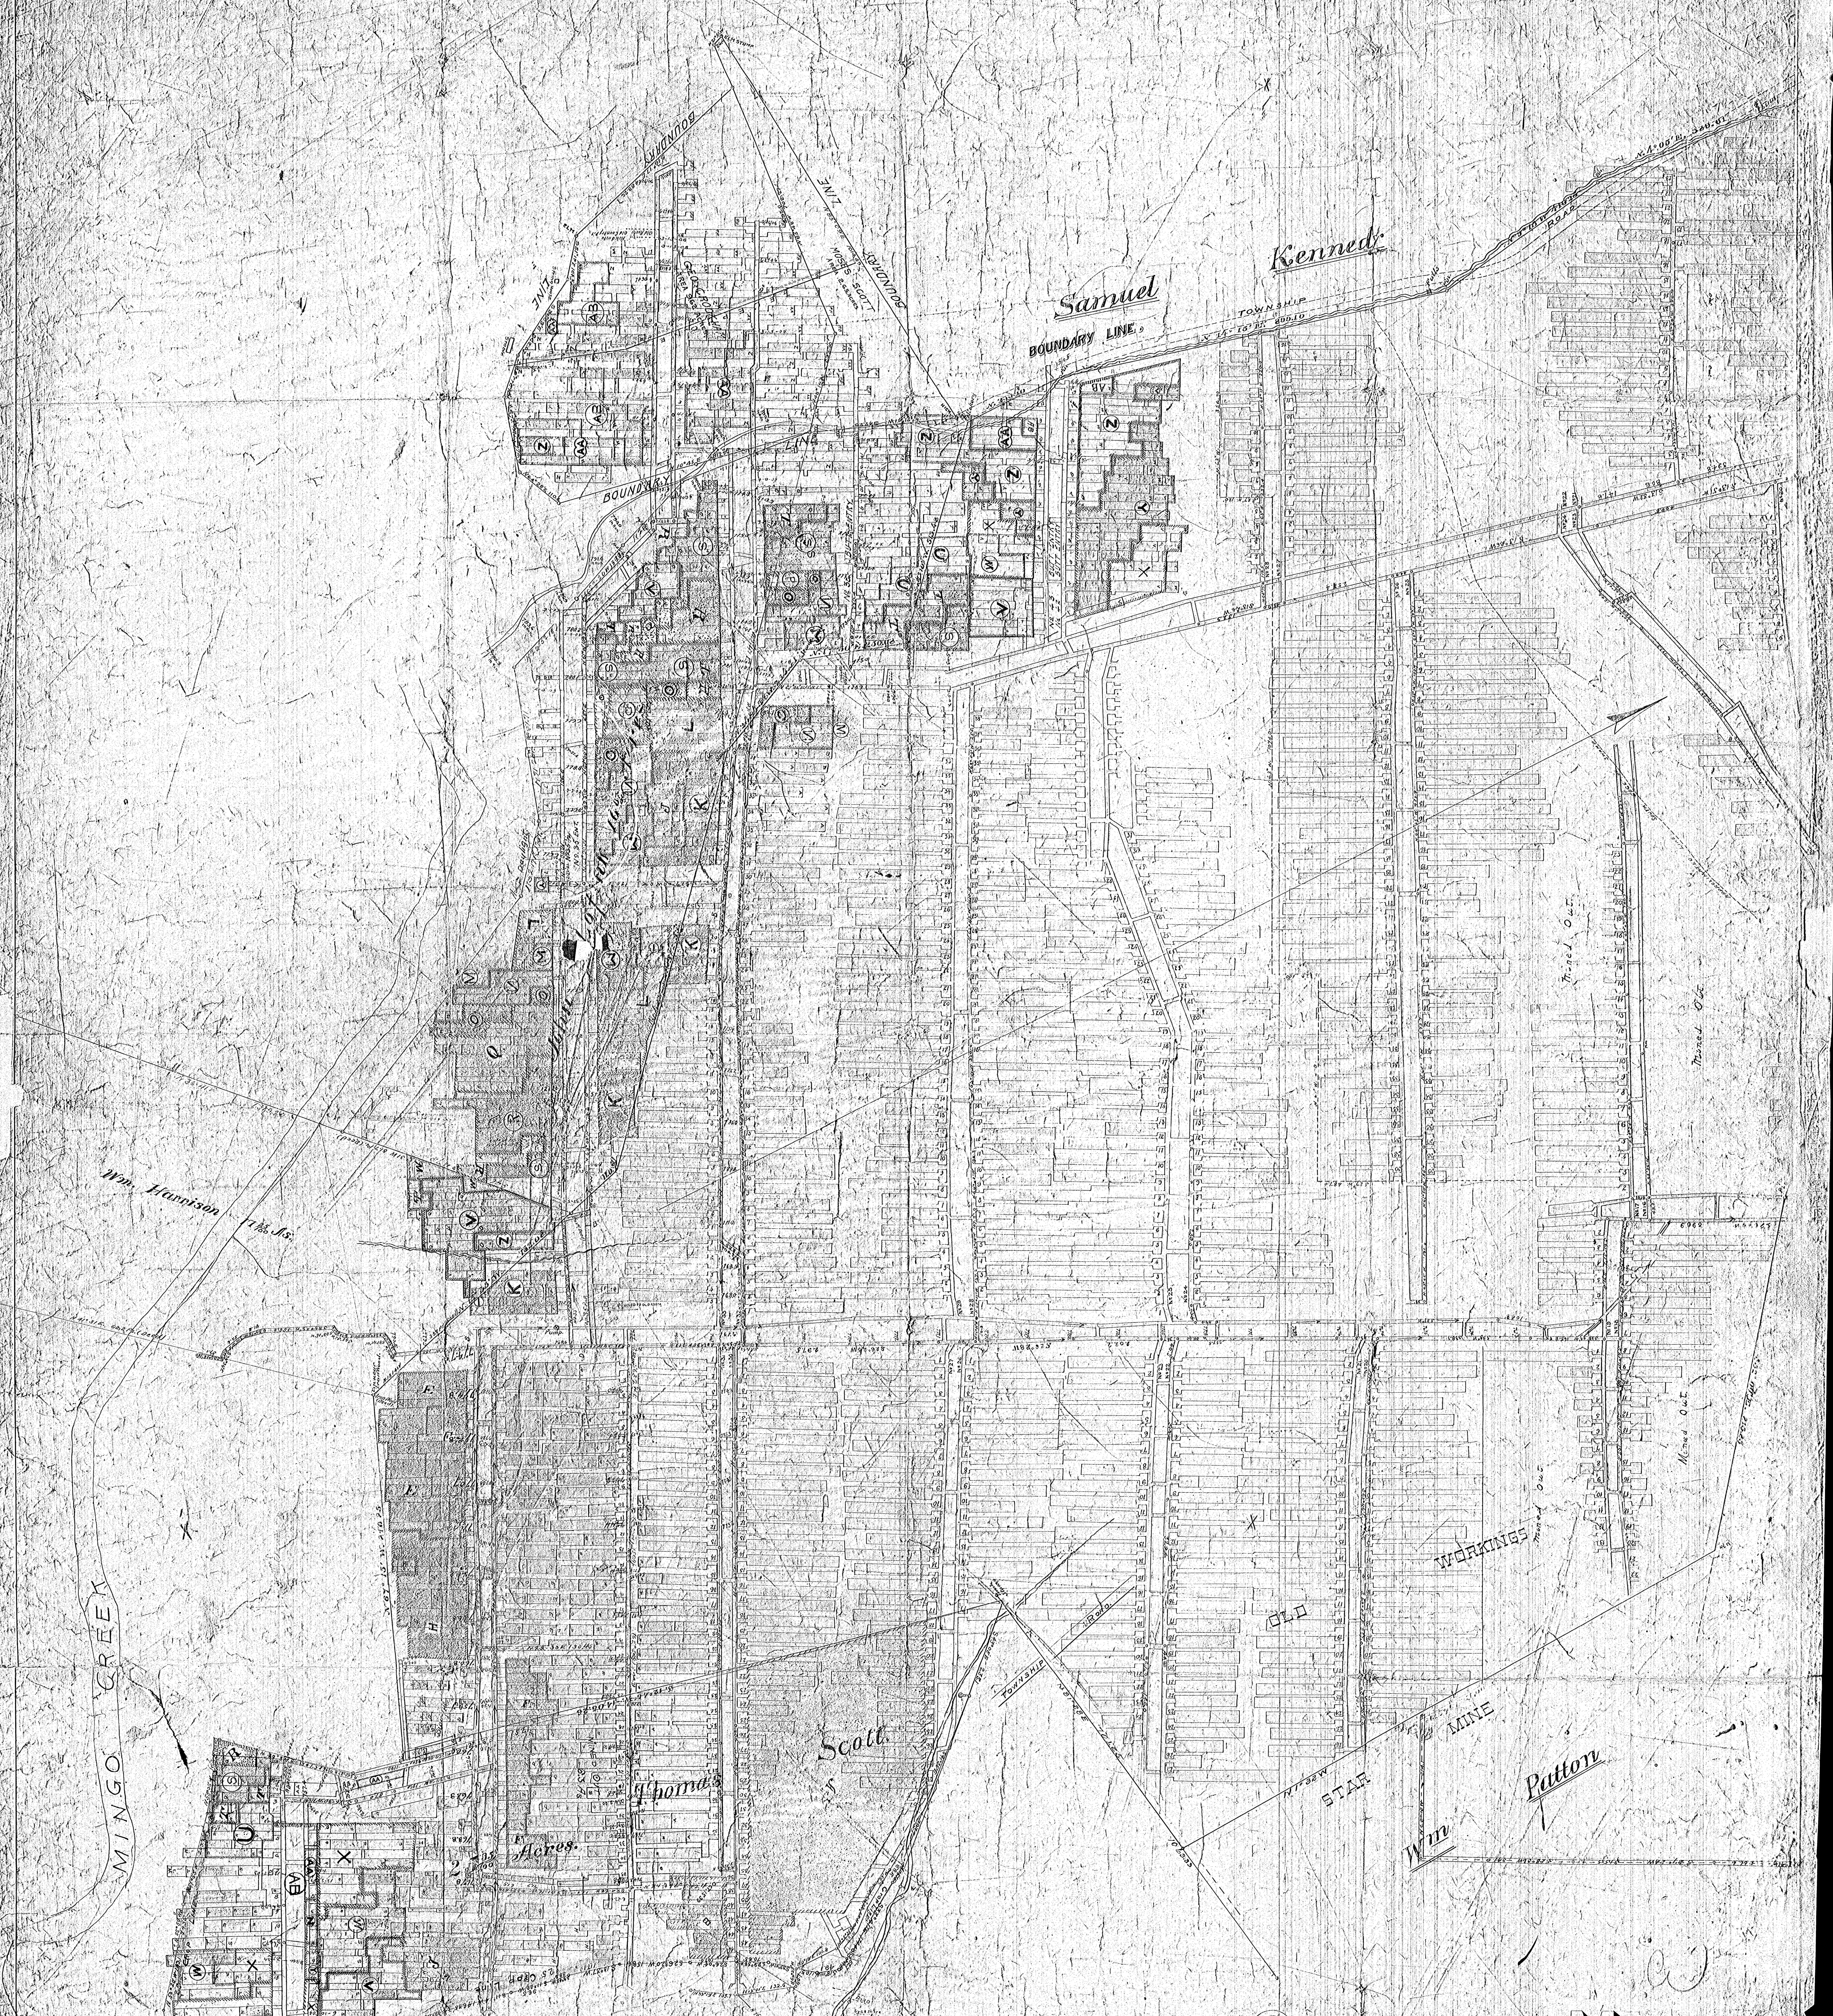
Samuel Kennedy
Township Boundary Line
Boundary Line
Wm. Harrison
Mingo Creek
Thomas Scott Acres
Old Star Mine Workings
Township Line
Mined Out
Wm Patton

COURTNEY MINE

PITTSBURGH COAL CO

SCALE 100 feet = 1 inch

DATE OF SURVEY
Oct. 15th 1899
Apr. 2nd 1900 = A
Jun. 27th " = B
Aug 23rd " = C
Nov 26 " = D
Mar. 11 1901 = E J.C.
June 10 1901 = F S.L.
Sept. 16 1901 = G
Dec. 20 1901 = H H.B.
Mar 7 1902 = I
Sept 9 1902 = K J.F.
Apr. 9 1903 = M E.G.R.
July 1 " = N
Sept. 7 " = O G.W.S.
Dec 23 " = P
June 10 1904 = R
Sept 14 1904 = S
Dec. 5 1904 = T F.S.
Mch. 3 1905 = U B.C.S.
June 10 1905 = V B.C.S.
Sept 15 1905 = W
June 27 1906 = "Z"
Oct 24th 1906 AA D.C.N.

#665
7-1-99
C.C.