


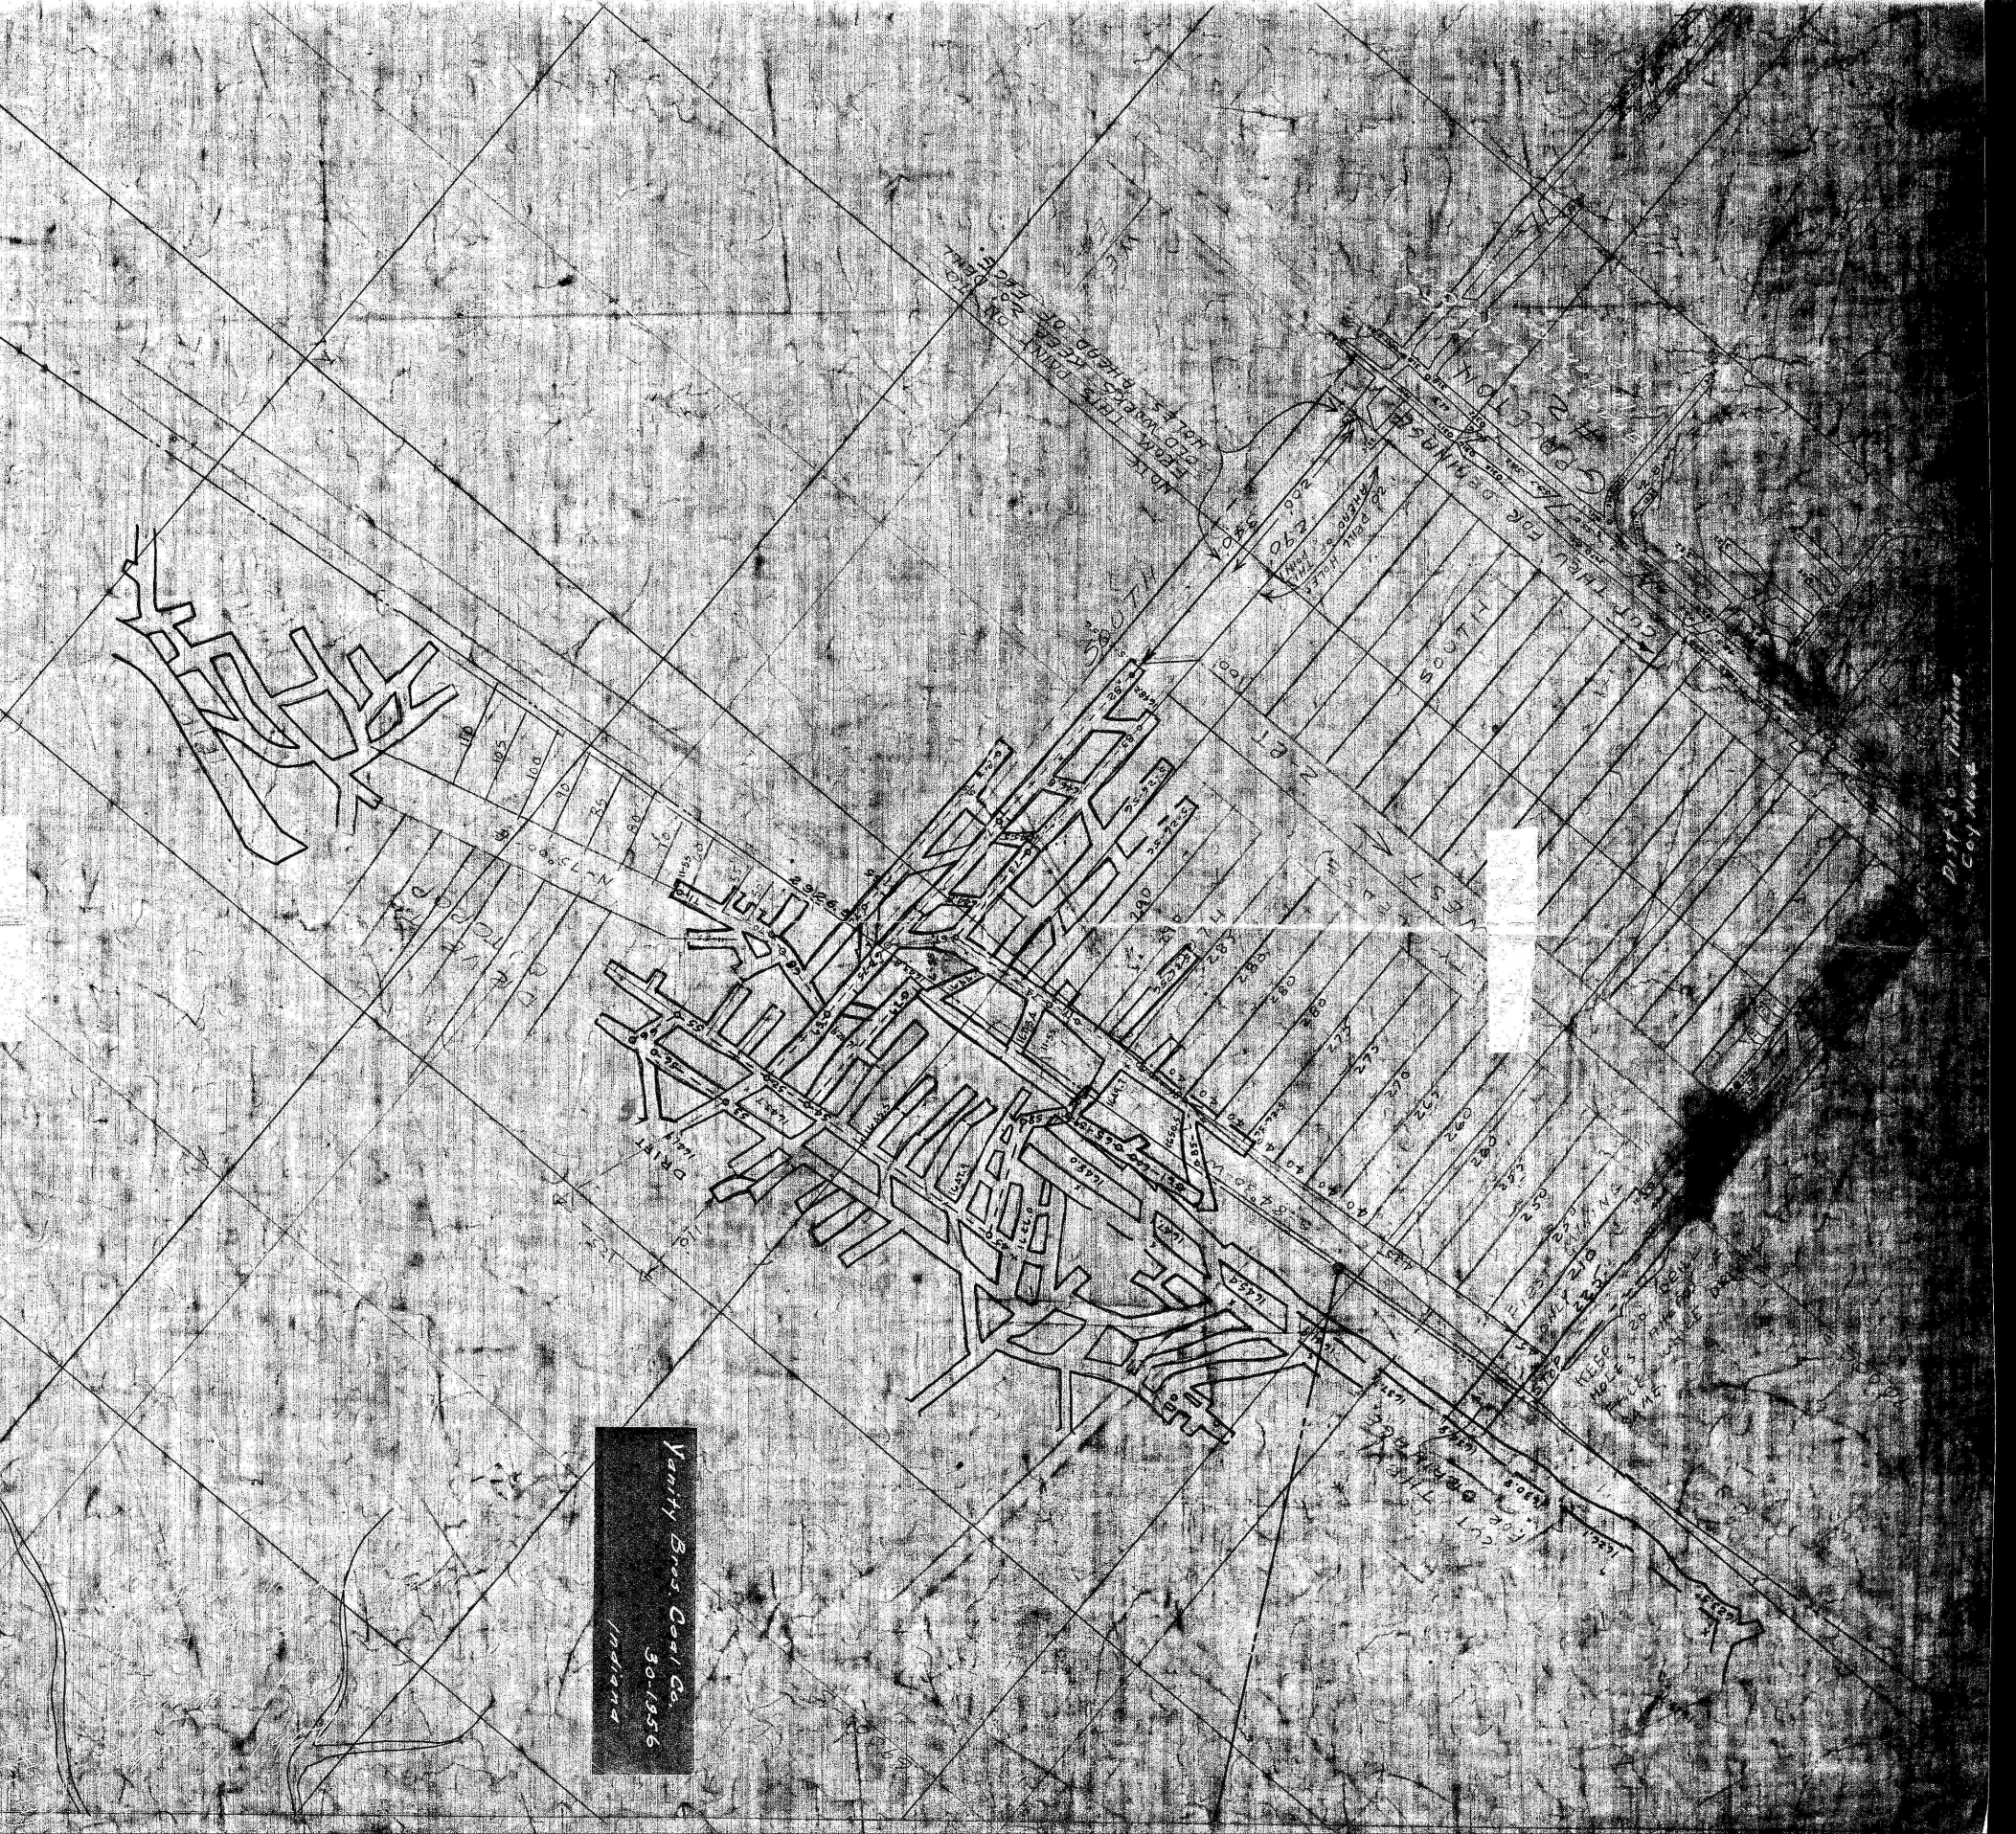

Yanity Bros. Coal Co.
30.1356
Indiana

Dist. 90 Indiana
