
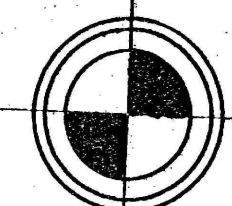


SCALES
DIPPLE

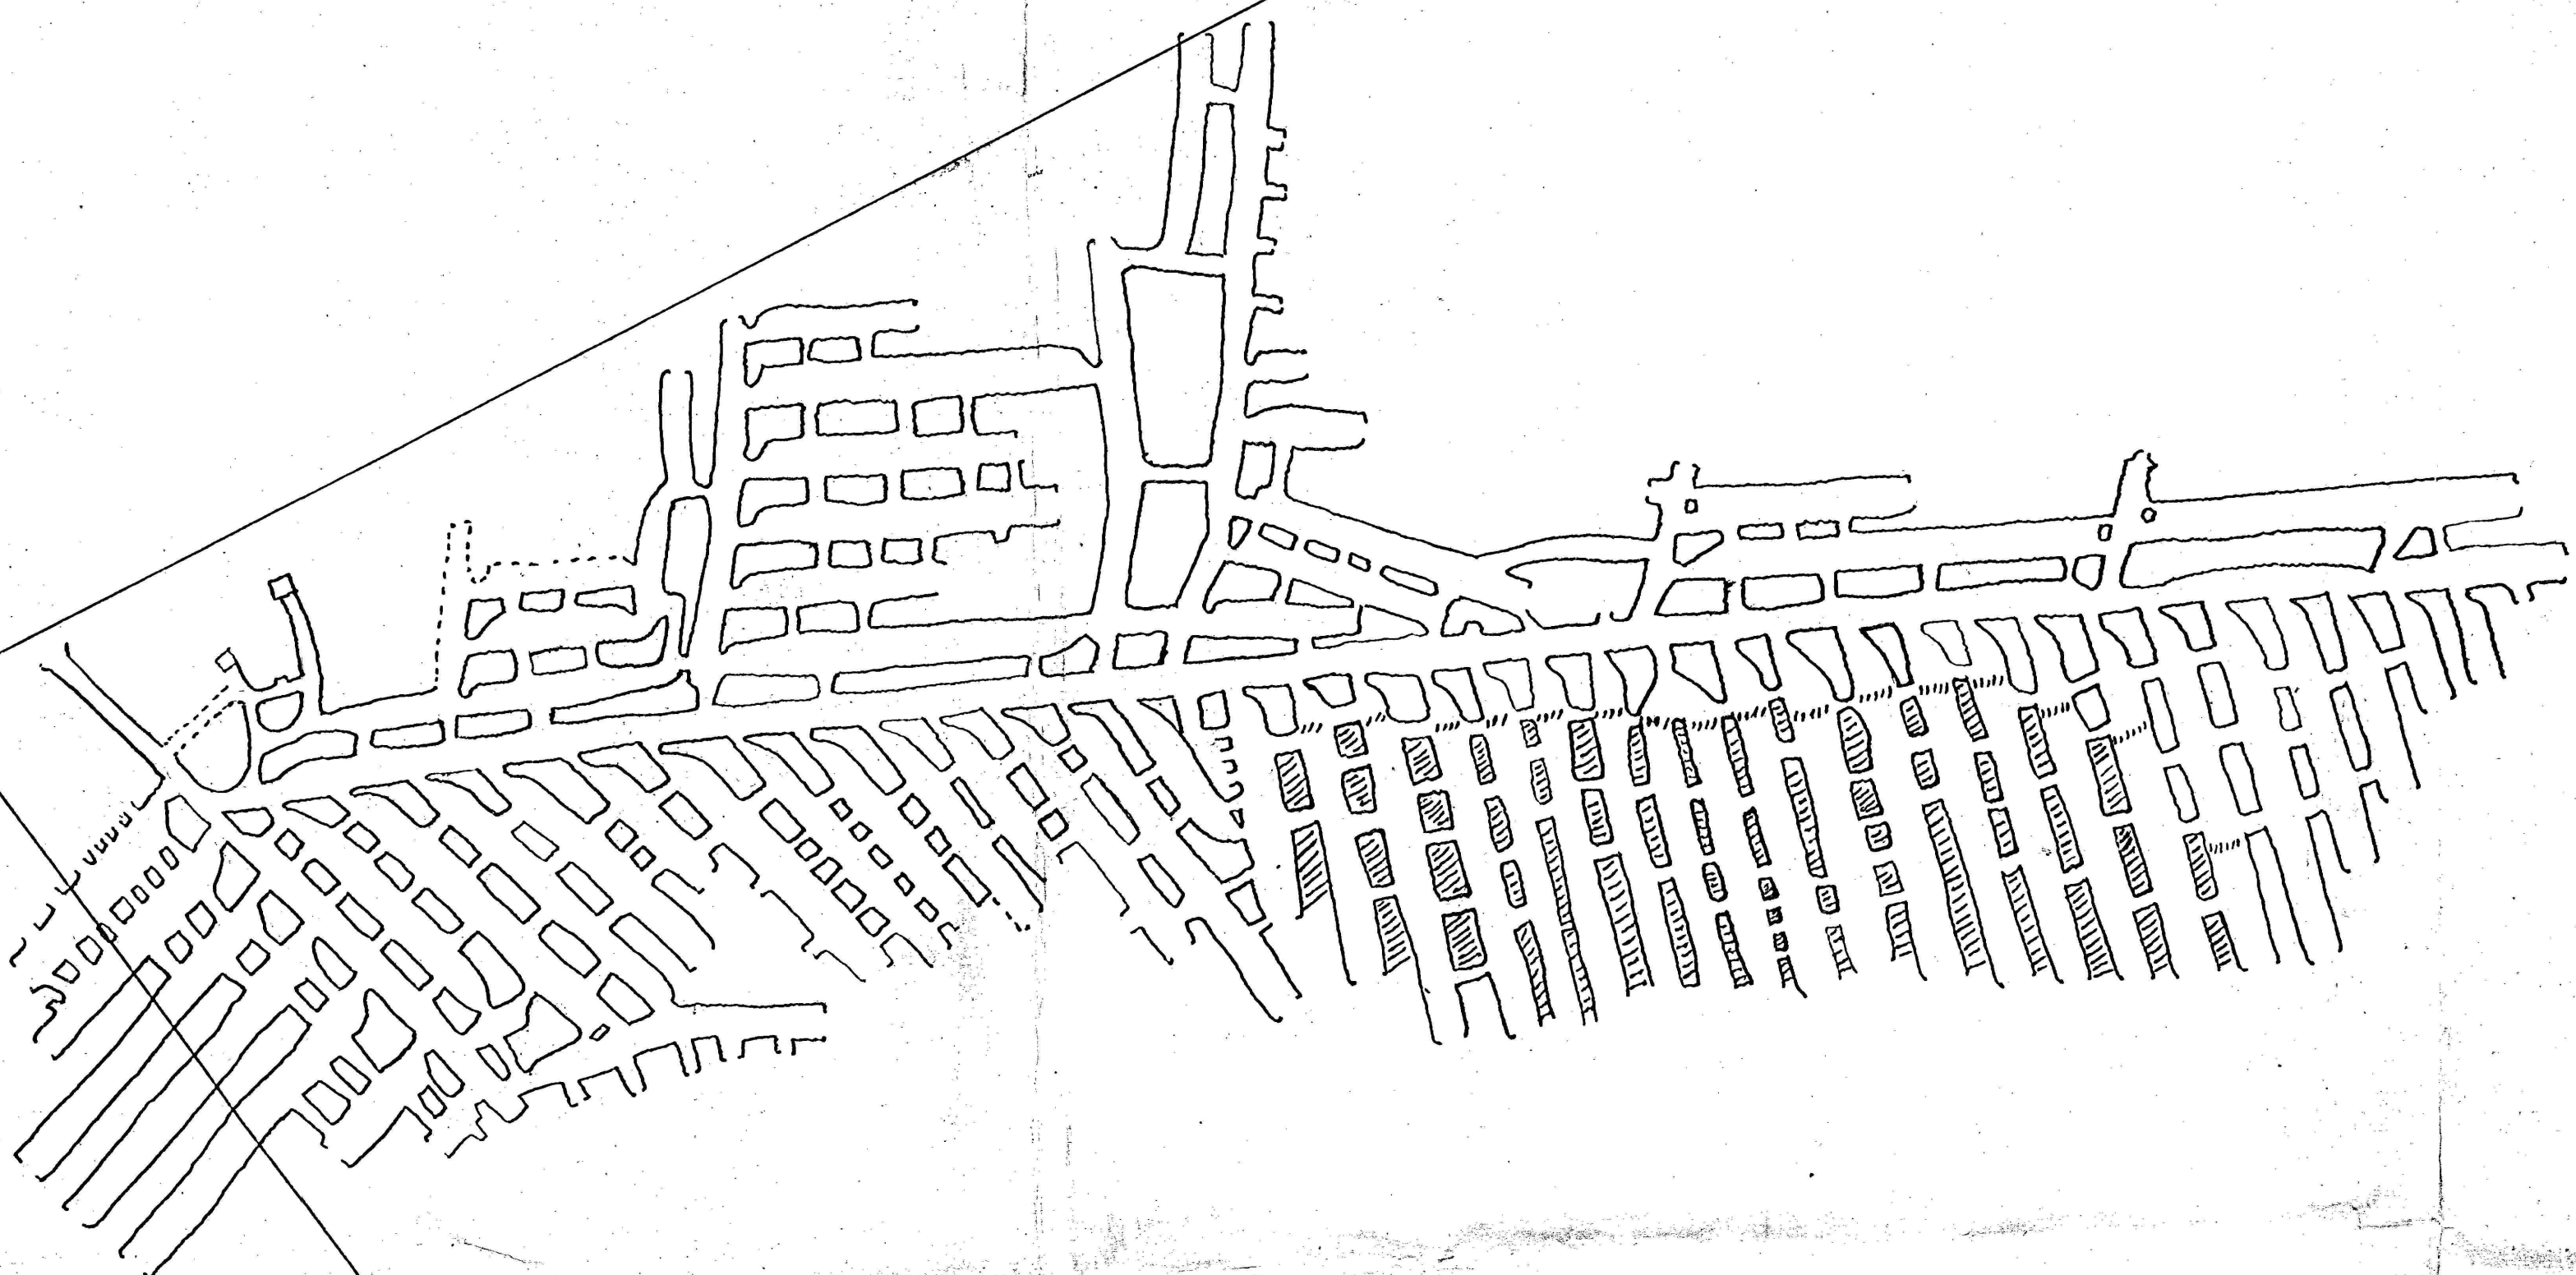

1882

MAP
CREEKSIDE COAL CO.
JORDAN TOWNSHIP CLEARFIELD COUNTY PENNA
SCALE 1"=100'
27
By *Wm A. Hall*

#1199
1-11-00