


Exhibit A.
Affidavit of L. Henry
Oct. 12 - 1920

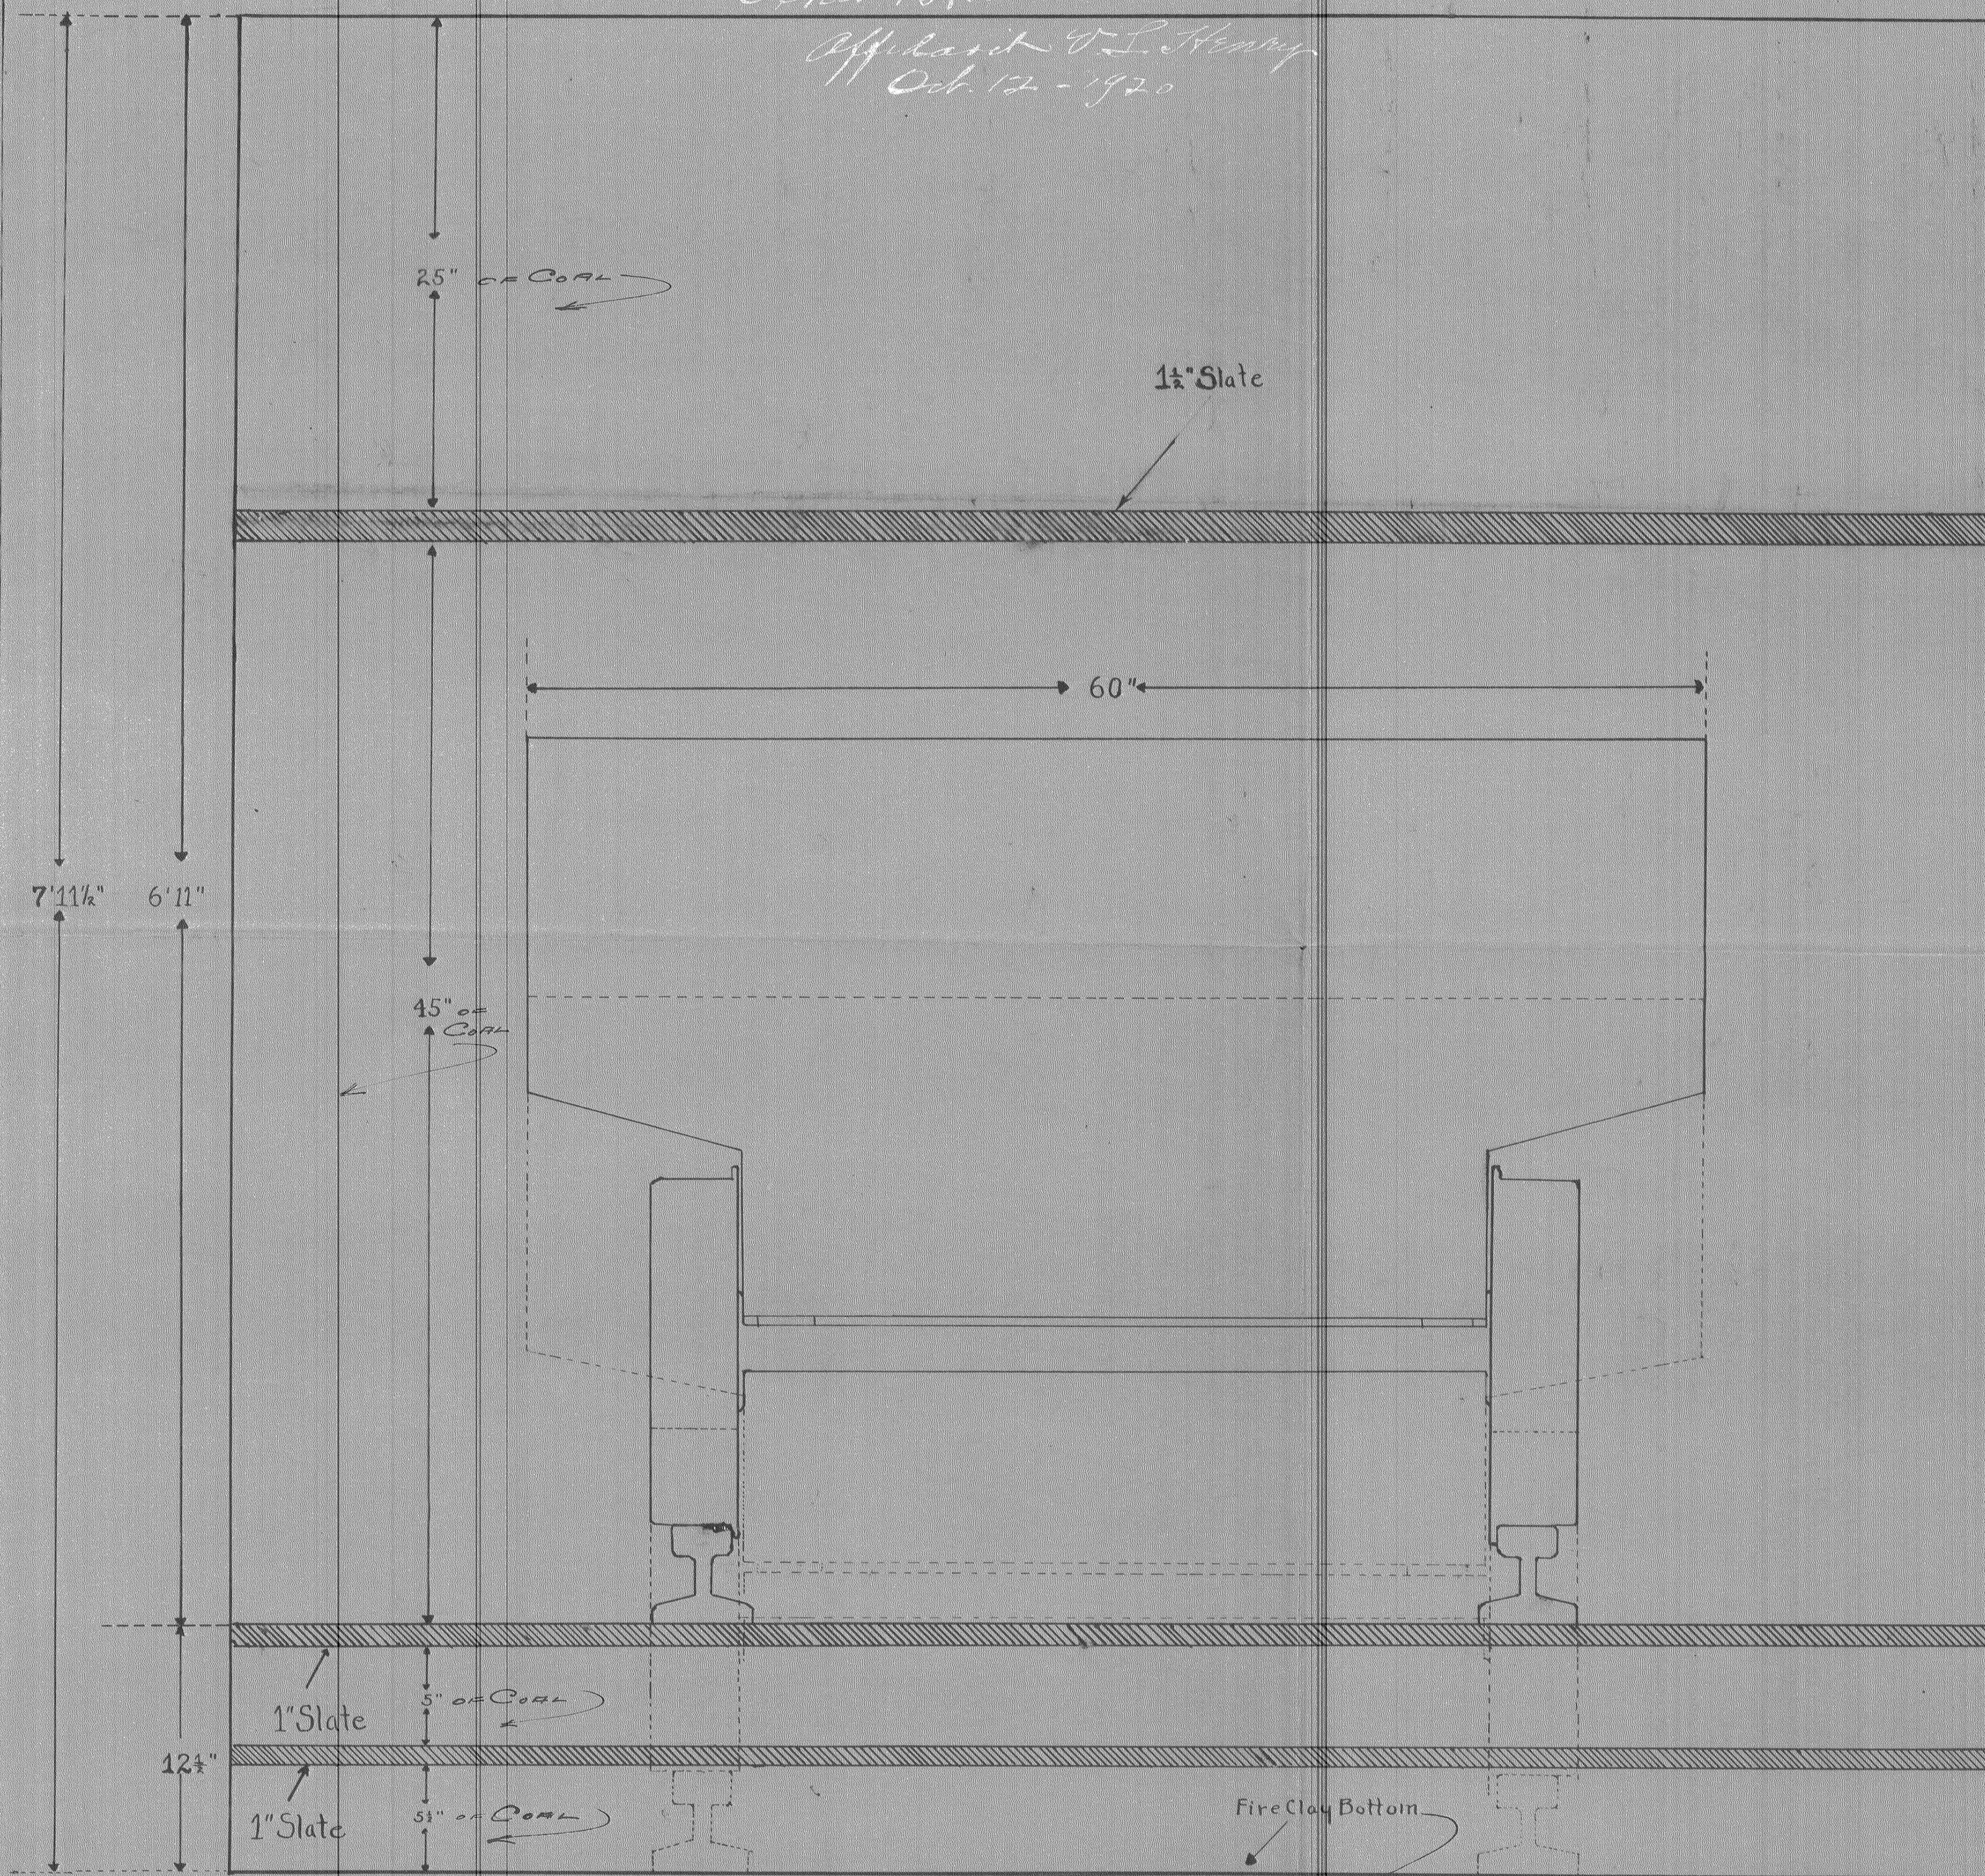

NOTE:— WHEN THIS SLATE AND BONE BINDER BECOMES 14" OR MORE IN THICKNESS— THE TOP COAL IS NOT MINED, THE LOWER MINABLE BENCH OF COAL IS THEN MINED AS "LOW COAL".

THE
CREIGHTON COAL WORKS
CROSS SECTION
of
COAL SEAM
18 Section
Showing
Present Bottom Cutting
and
Proposed Bottom Cutting
Scale 1" = 6" Oct 20 1919
HPB.

#153
7-2-20
cc