


#686
7-1-99
CC

CRESCENT HILLS COAL CO. INC
CRESCENT HILLS MINE
WEST PIKE RUN TWP WASHINGTON CO PA
SCALE: 1"=200 DATE - 10-10-83

Harvey S. Lewis

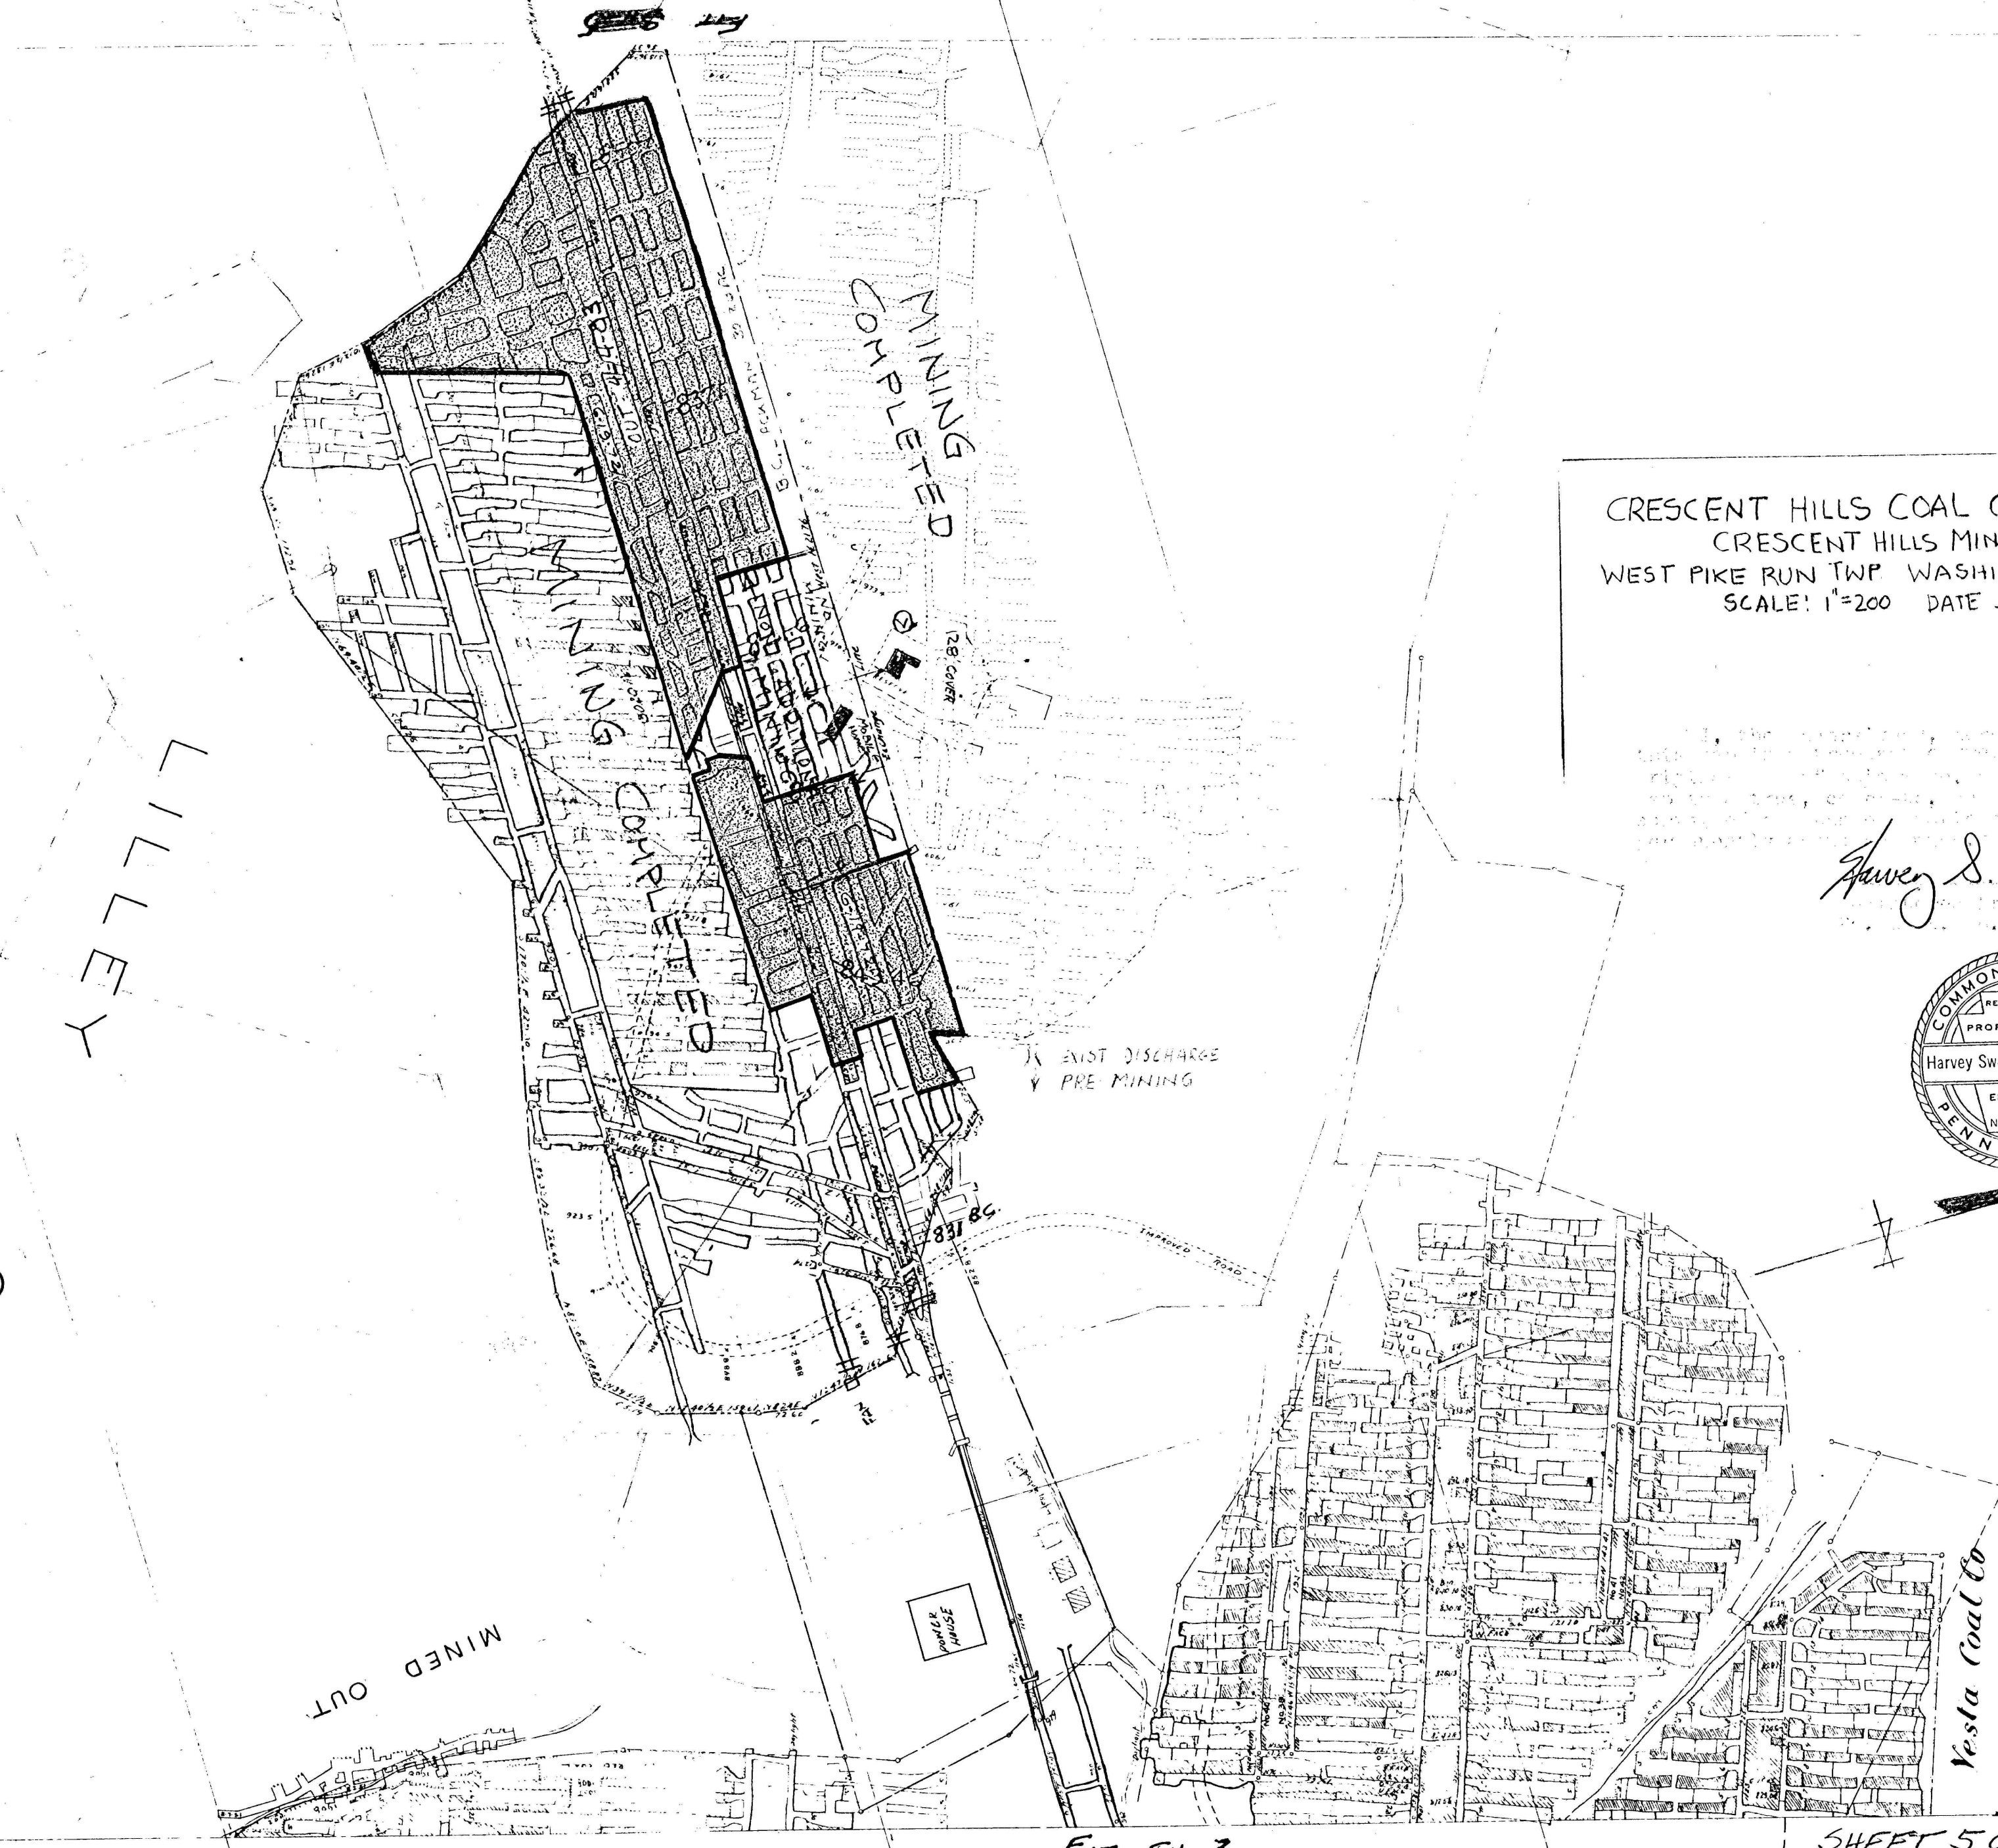

SHEET 5 OF 9

CO

FIT SN 3

SHEET 5 OF 9 SH. ~~11~~