



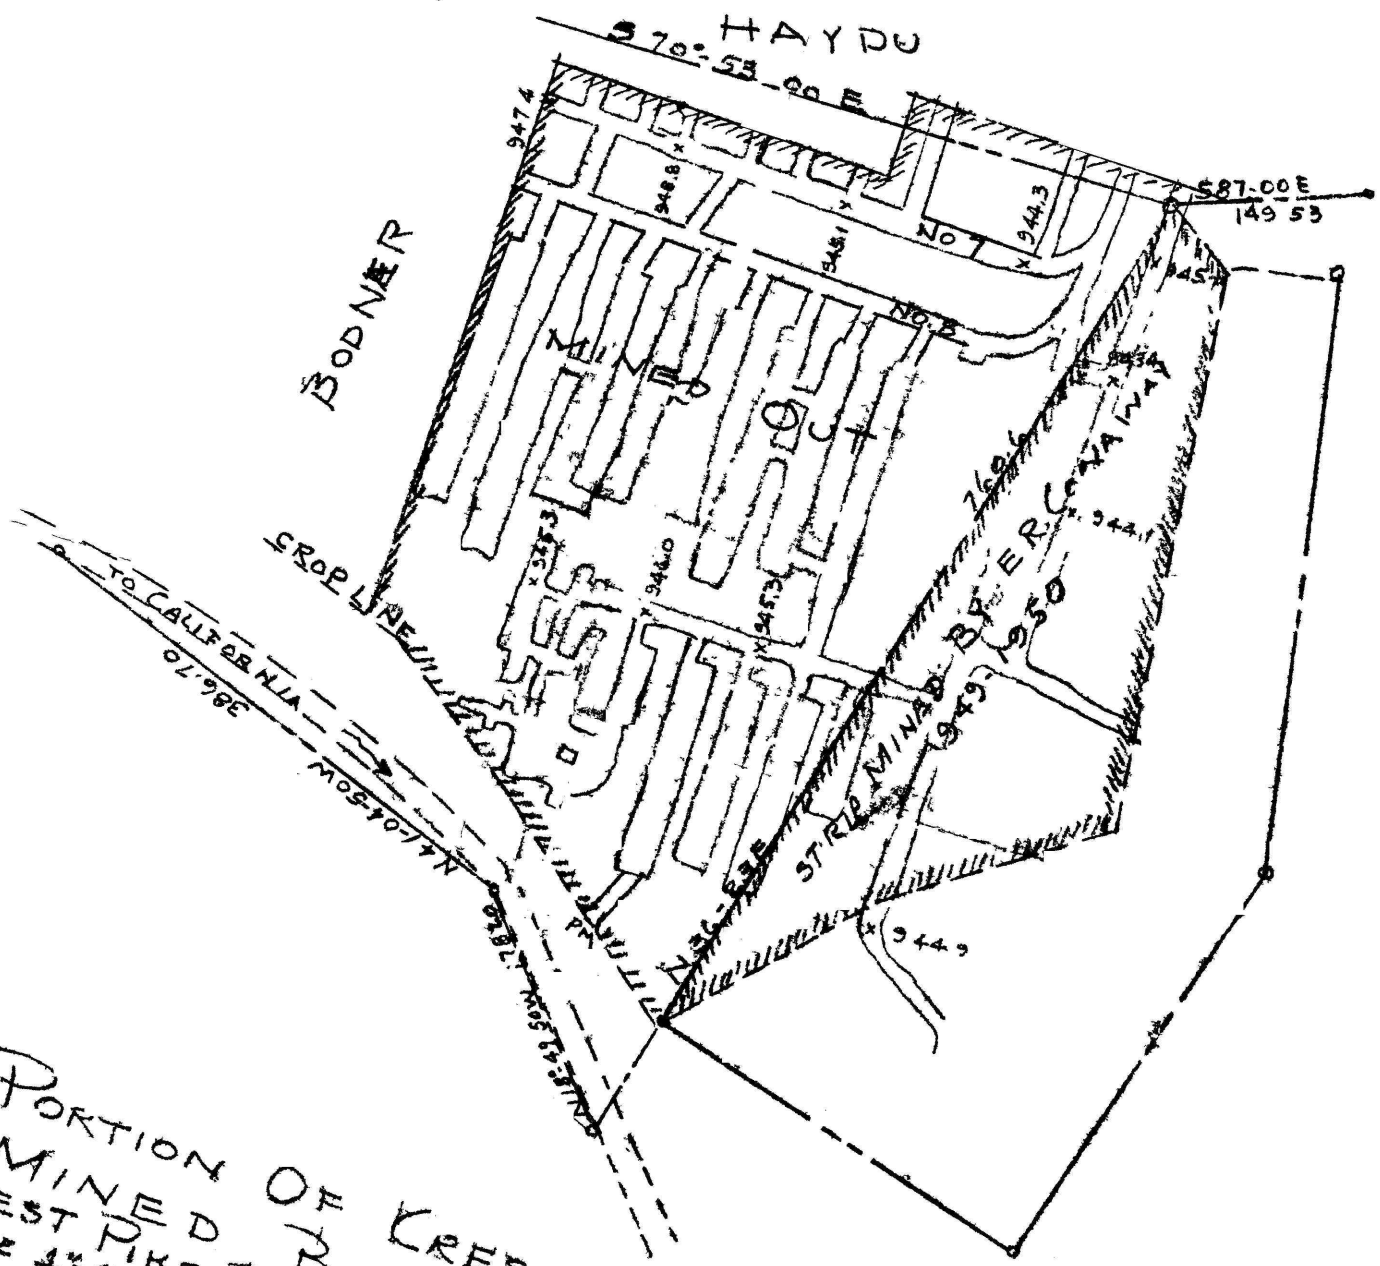

PORTION OF KRESCENT NO. 1 MINE
MINED BY MIKE BODNER
WEST PIKE RUN TWP WASHINGTON CO. PA
SCALE 1"=100'

I hereby certify this is a true
copy of the original map
and this is a true survey to
the best of my knowledge
Wm Thistlethwaite

AND STEPHEN H. BODNER
3-24-62

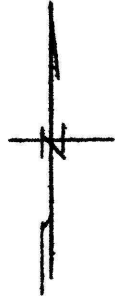