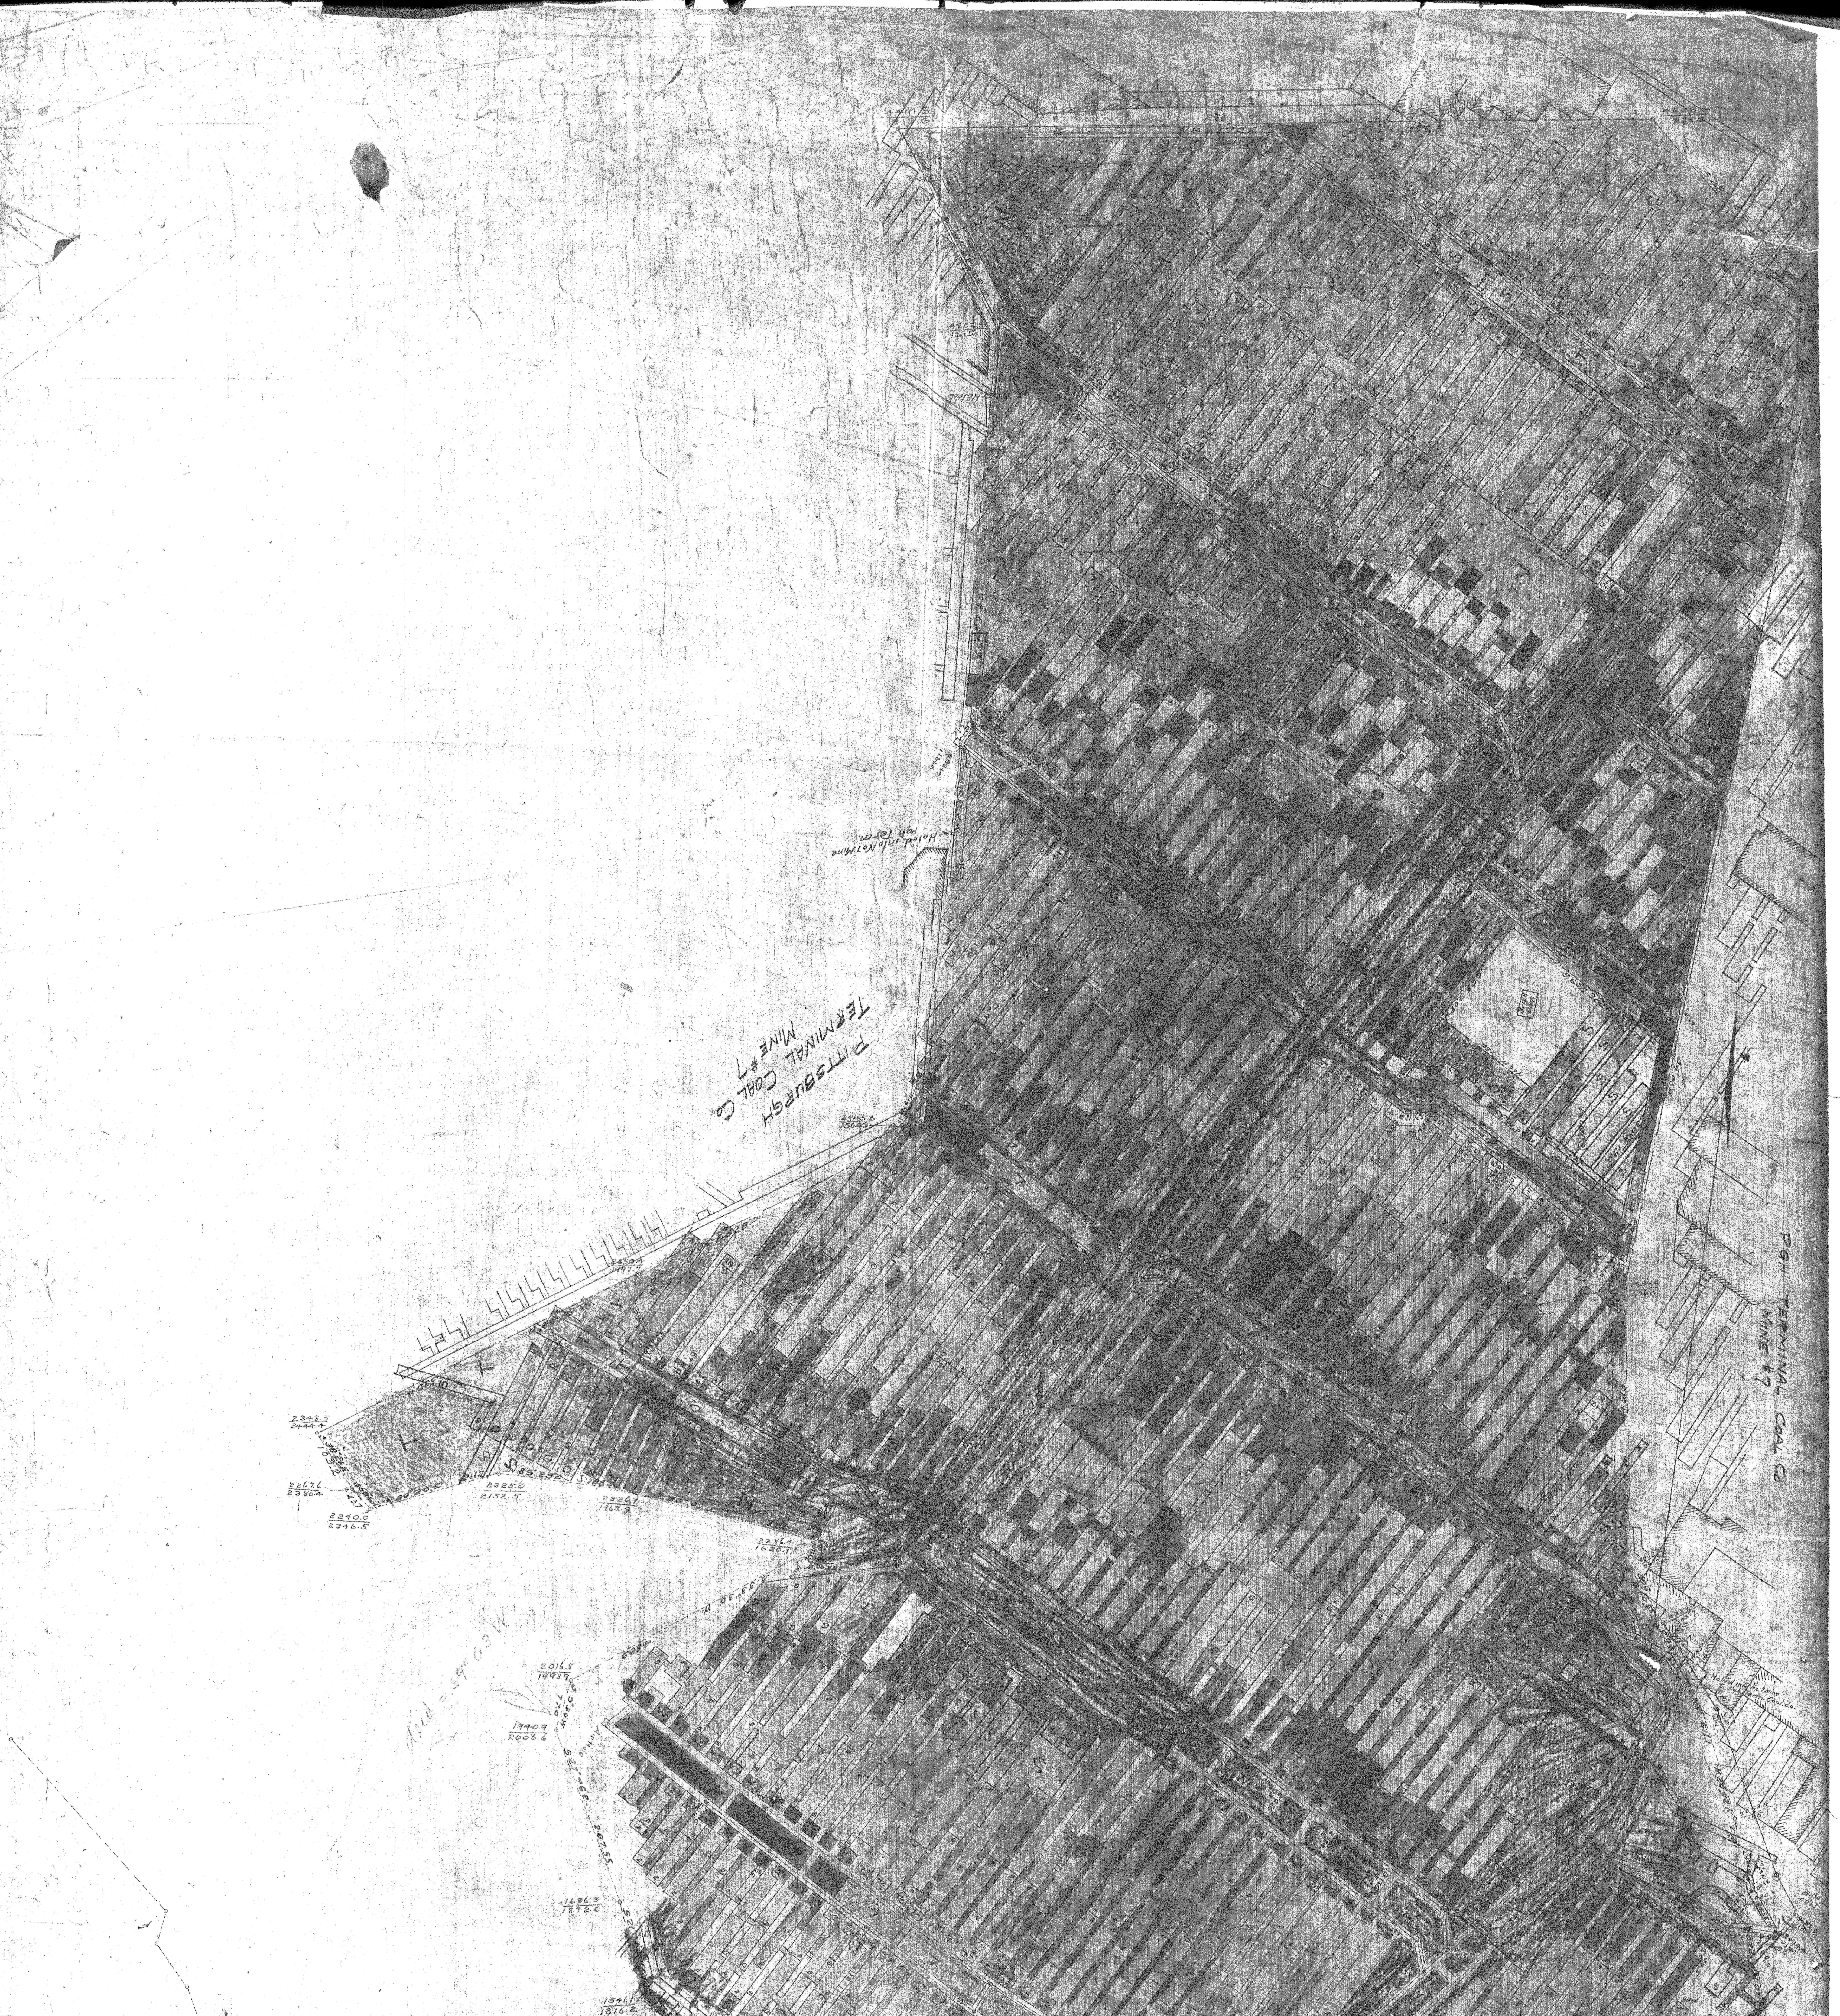
Pittsburgh Terminal Coal Co. Mine #7
Pgh Terminal Coal Co Mine #7
Mine exhausted June 1st 1918
Daylight
Furnace

MINE Nº 3.

CRESCENT COAL CO

JEFFERSON TOWNSHIP ALLEGHENY CO PA
July 1908
Scale 1" = 100 Ft

HARROP, HOPKINS AND TAYLOR
CIVIL AND MINING ENGRS.
PGH. PA.

Work Done Up To	July	1908	B
" " " "	Dec.	1908	C
" " " "	July	1909	D
" " " "	Jany	1910	E
" " " "	July	1910	■
" " " "	Jany	1911	G
" " " "	July	1911	H
" " " "	Dec.	1911	J
" " " "	May 1st	1912	K
" " " "	Jan	1913	L
" " " "	Aug.	1913	M
" " " "	Jan	1914	N
" " " "	July	1914	O
" " " "	Jan.	1916	S
" " " "	July	1916	■
" " " "	Jan	1917	B
" " " "	Jan	1918	V
" " " "	June	1918	W