


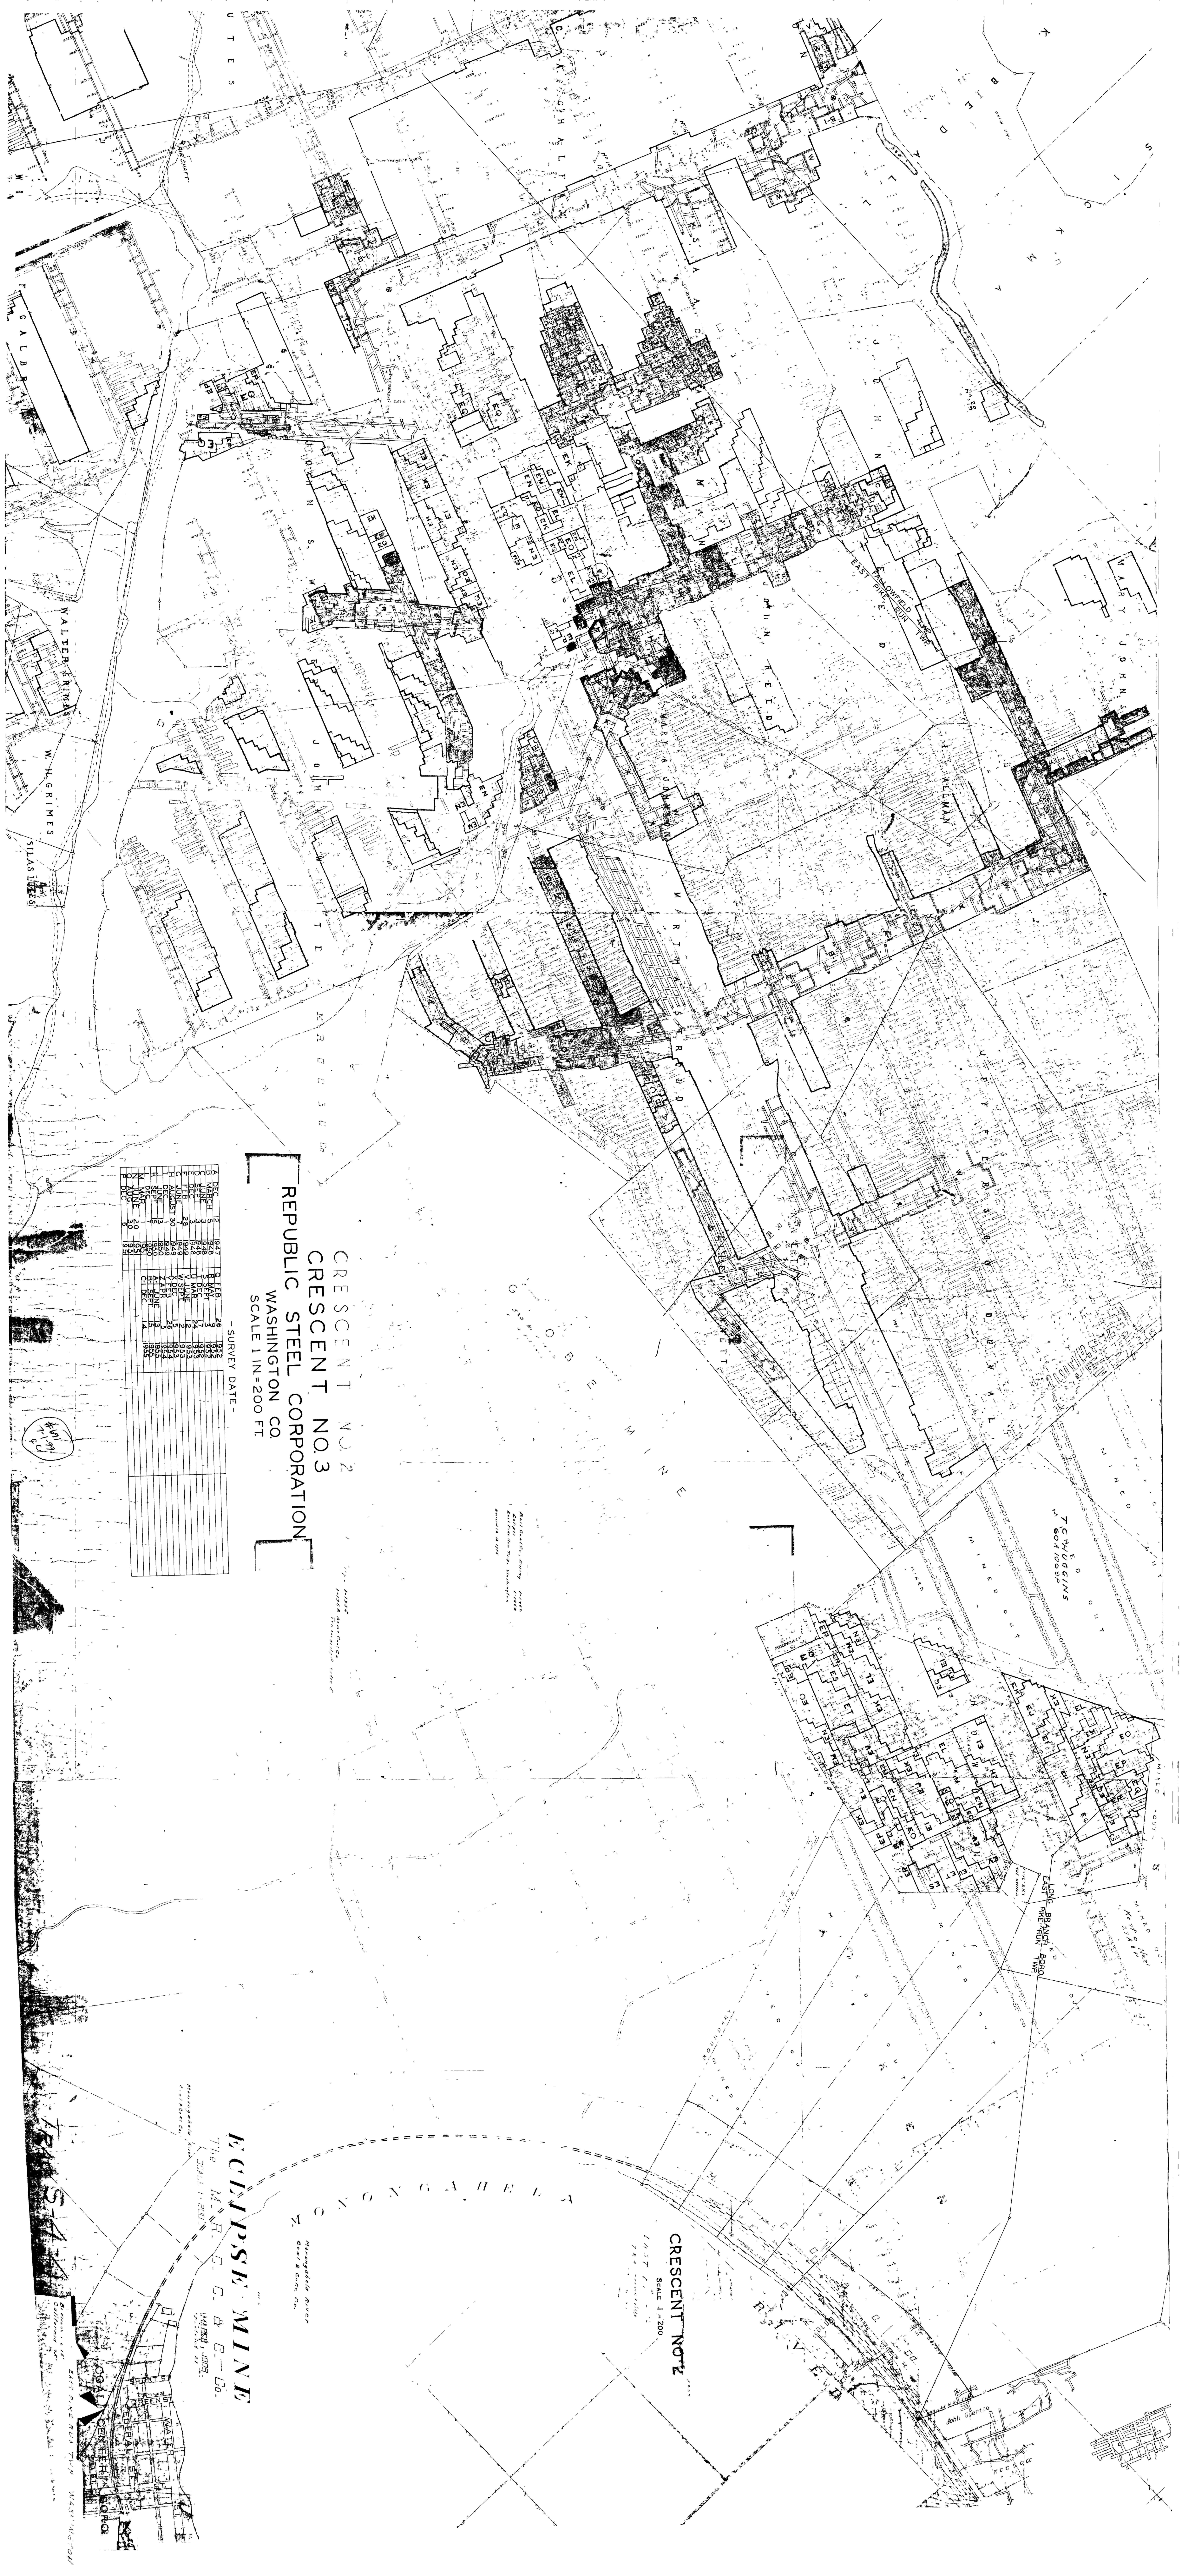

CRESCENT NO. 2
CRESCENT NO. 3
REPUBLIC STEEL CORPORATION
WASHINGTON CO
SCALE 1 IN = 200 FT

- SURVEY DATE -

1	2	
1	2	

SCALE 1 IN = 200 FT

ECLIPSE MINE
SCALE 1 IN = 200 FT

TR 5-4-4
ECLIPSE MINE
WASHINGTON