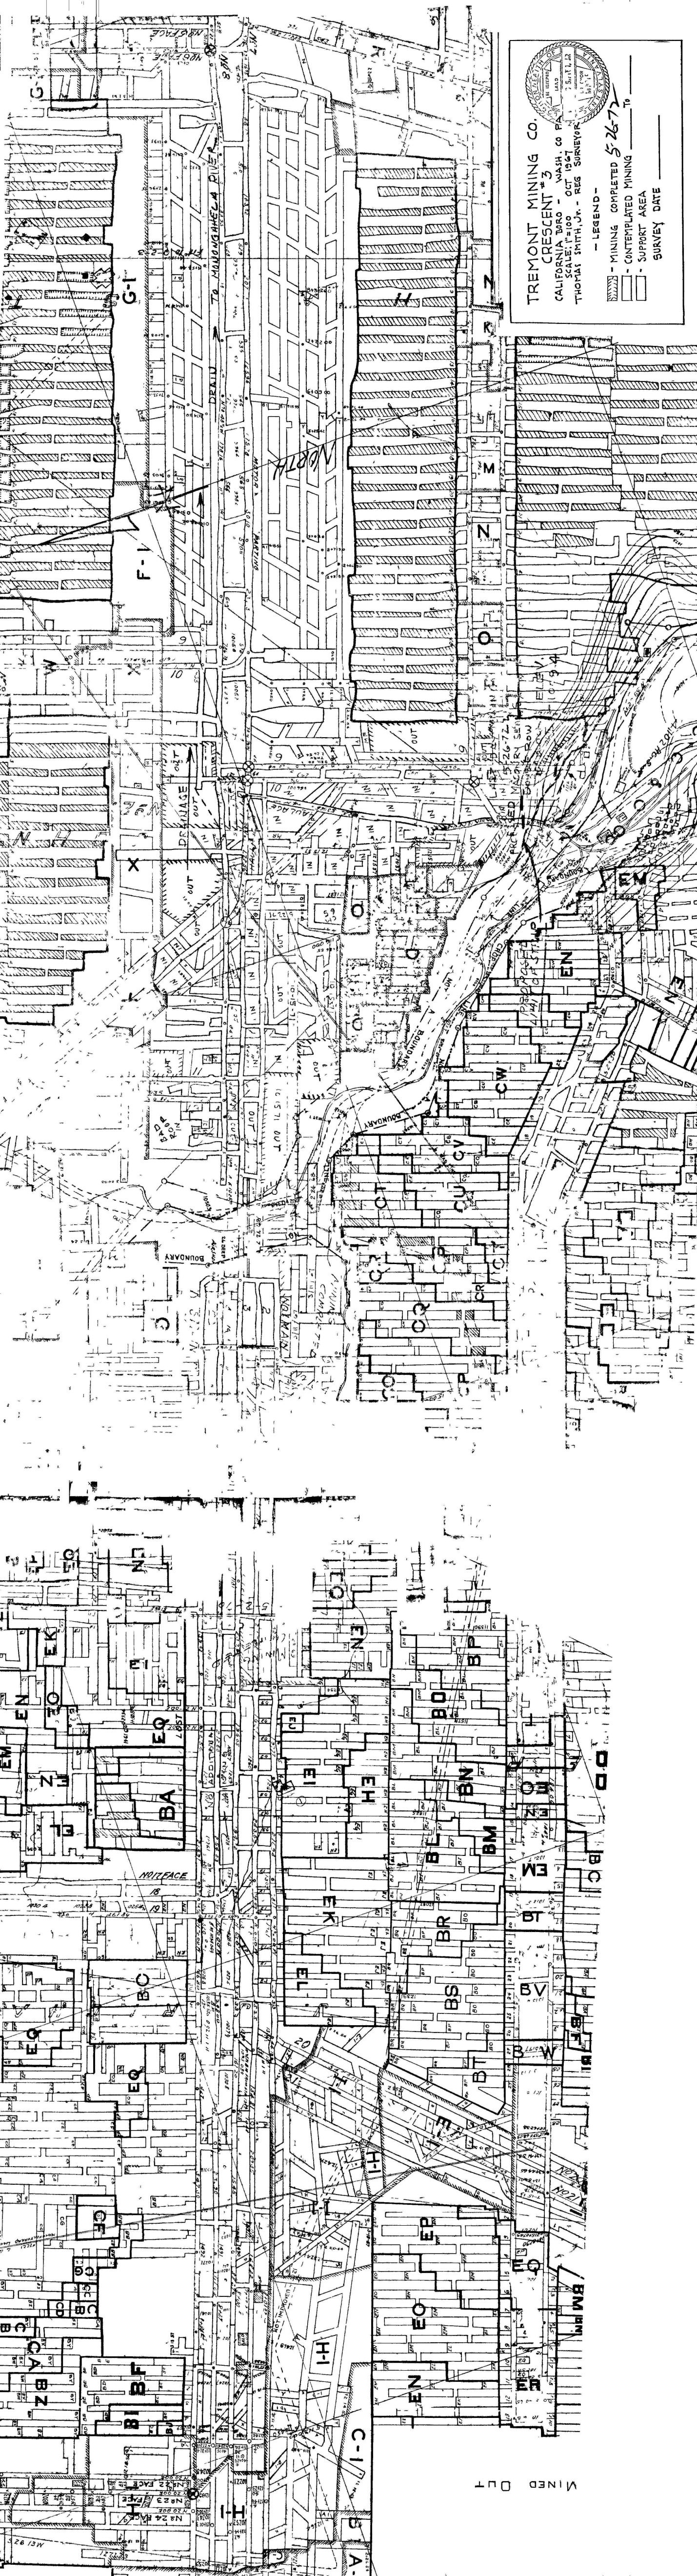


TREMONT MINING CO.
CRESCENT #3
CALIFORNIA BORO - WASH. CO. PA.
SCALE: 1"=100' OCT 1967
THOMAS SMITH, JR. - REG. SURVEYOR

- LEGEND —
- MINING COMPLETED 5-26-72
 - CONTEMPLATED MINING
 - SUPPORT AREA
 - SURVEY DATE