


I O S E P II

H A R R I S O N

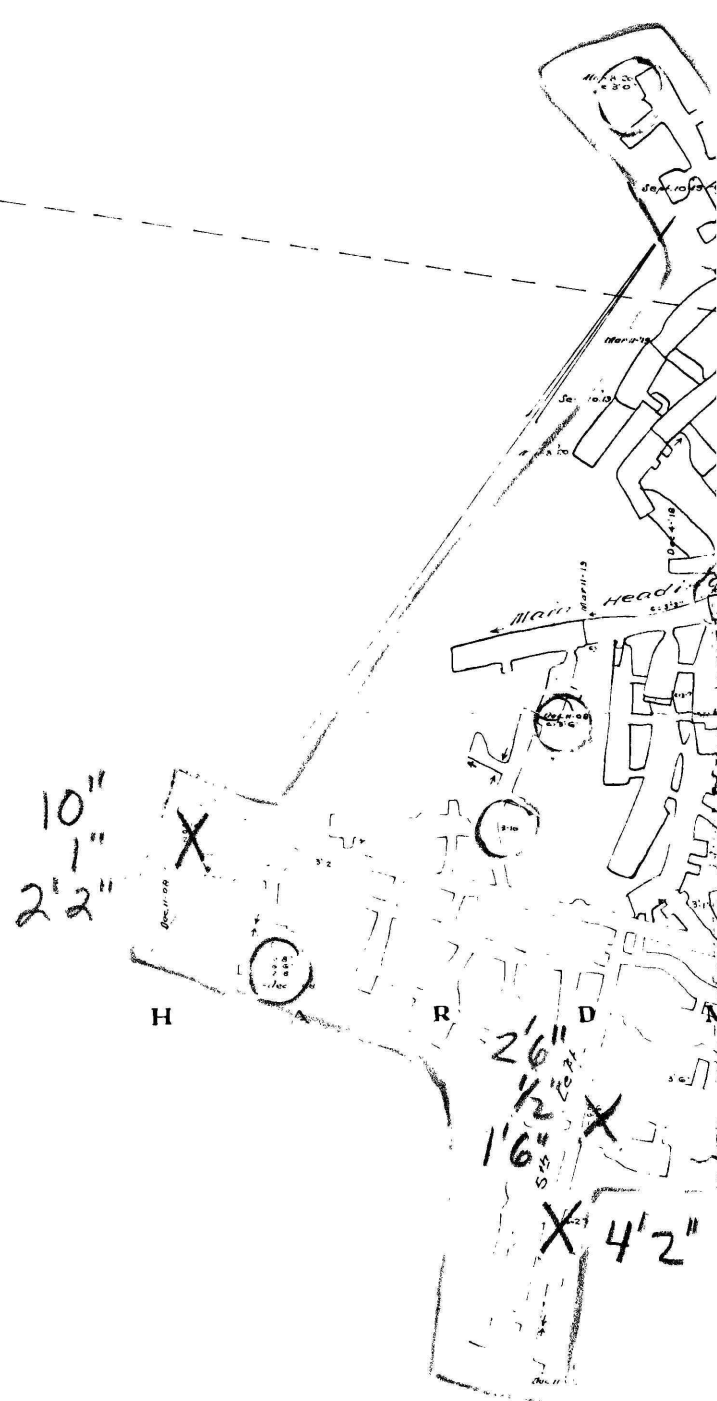

F R E D E R I C K

P H I L I P S B U R G C O A L & L A N D

Cripple Creek Slope