


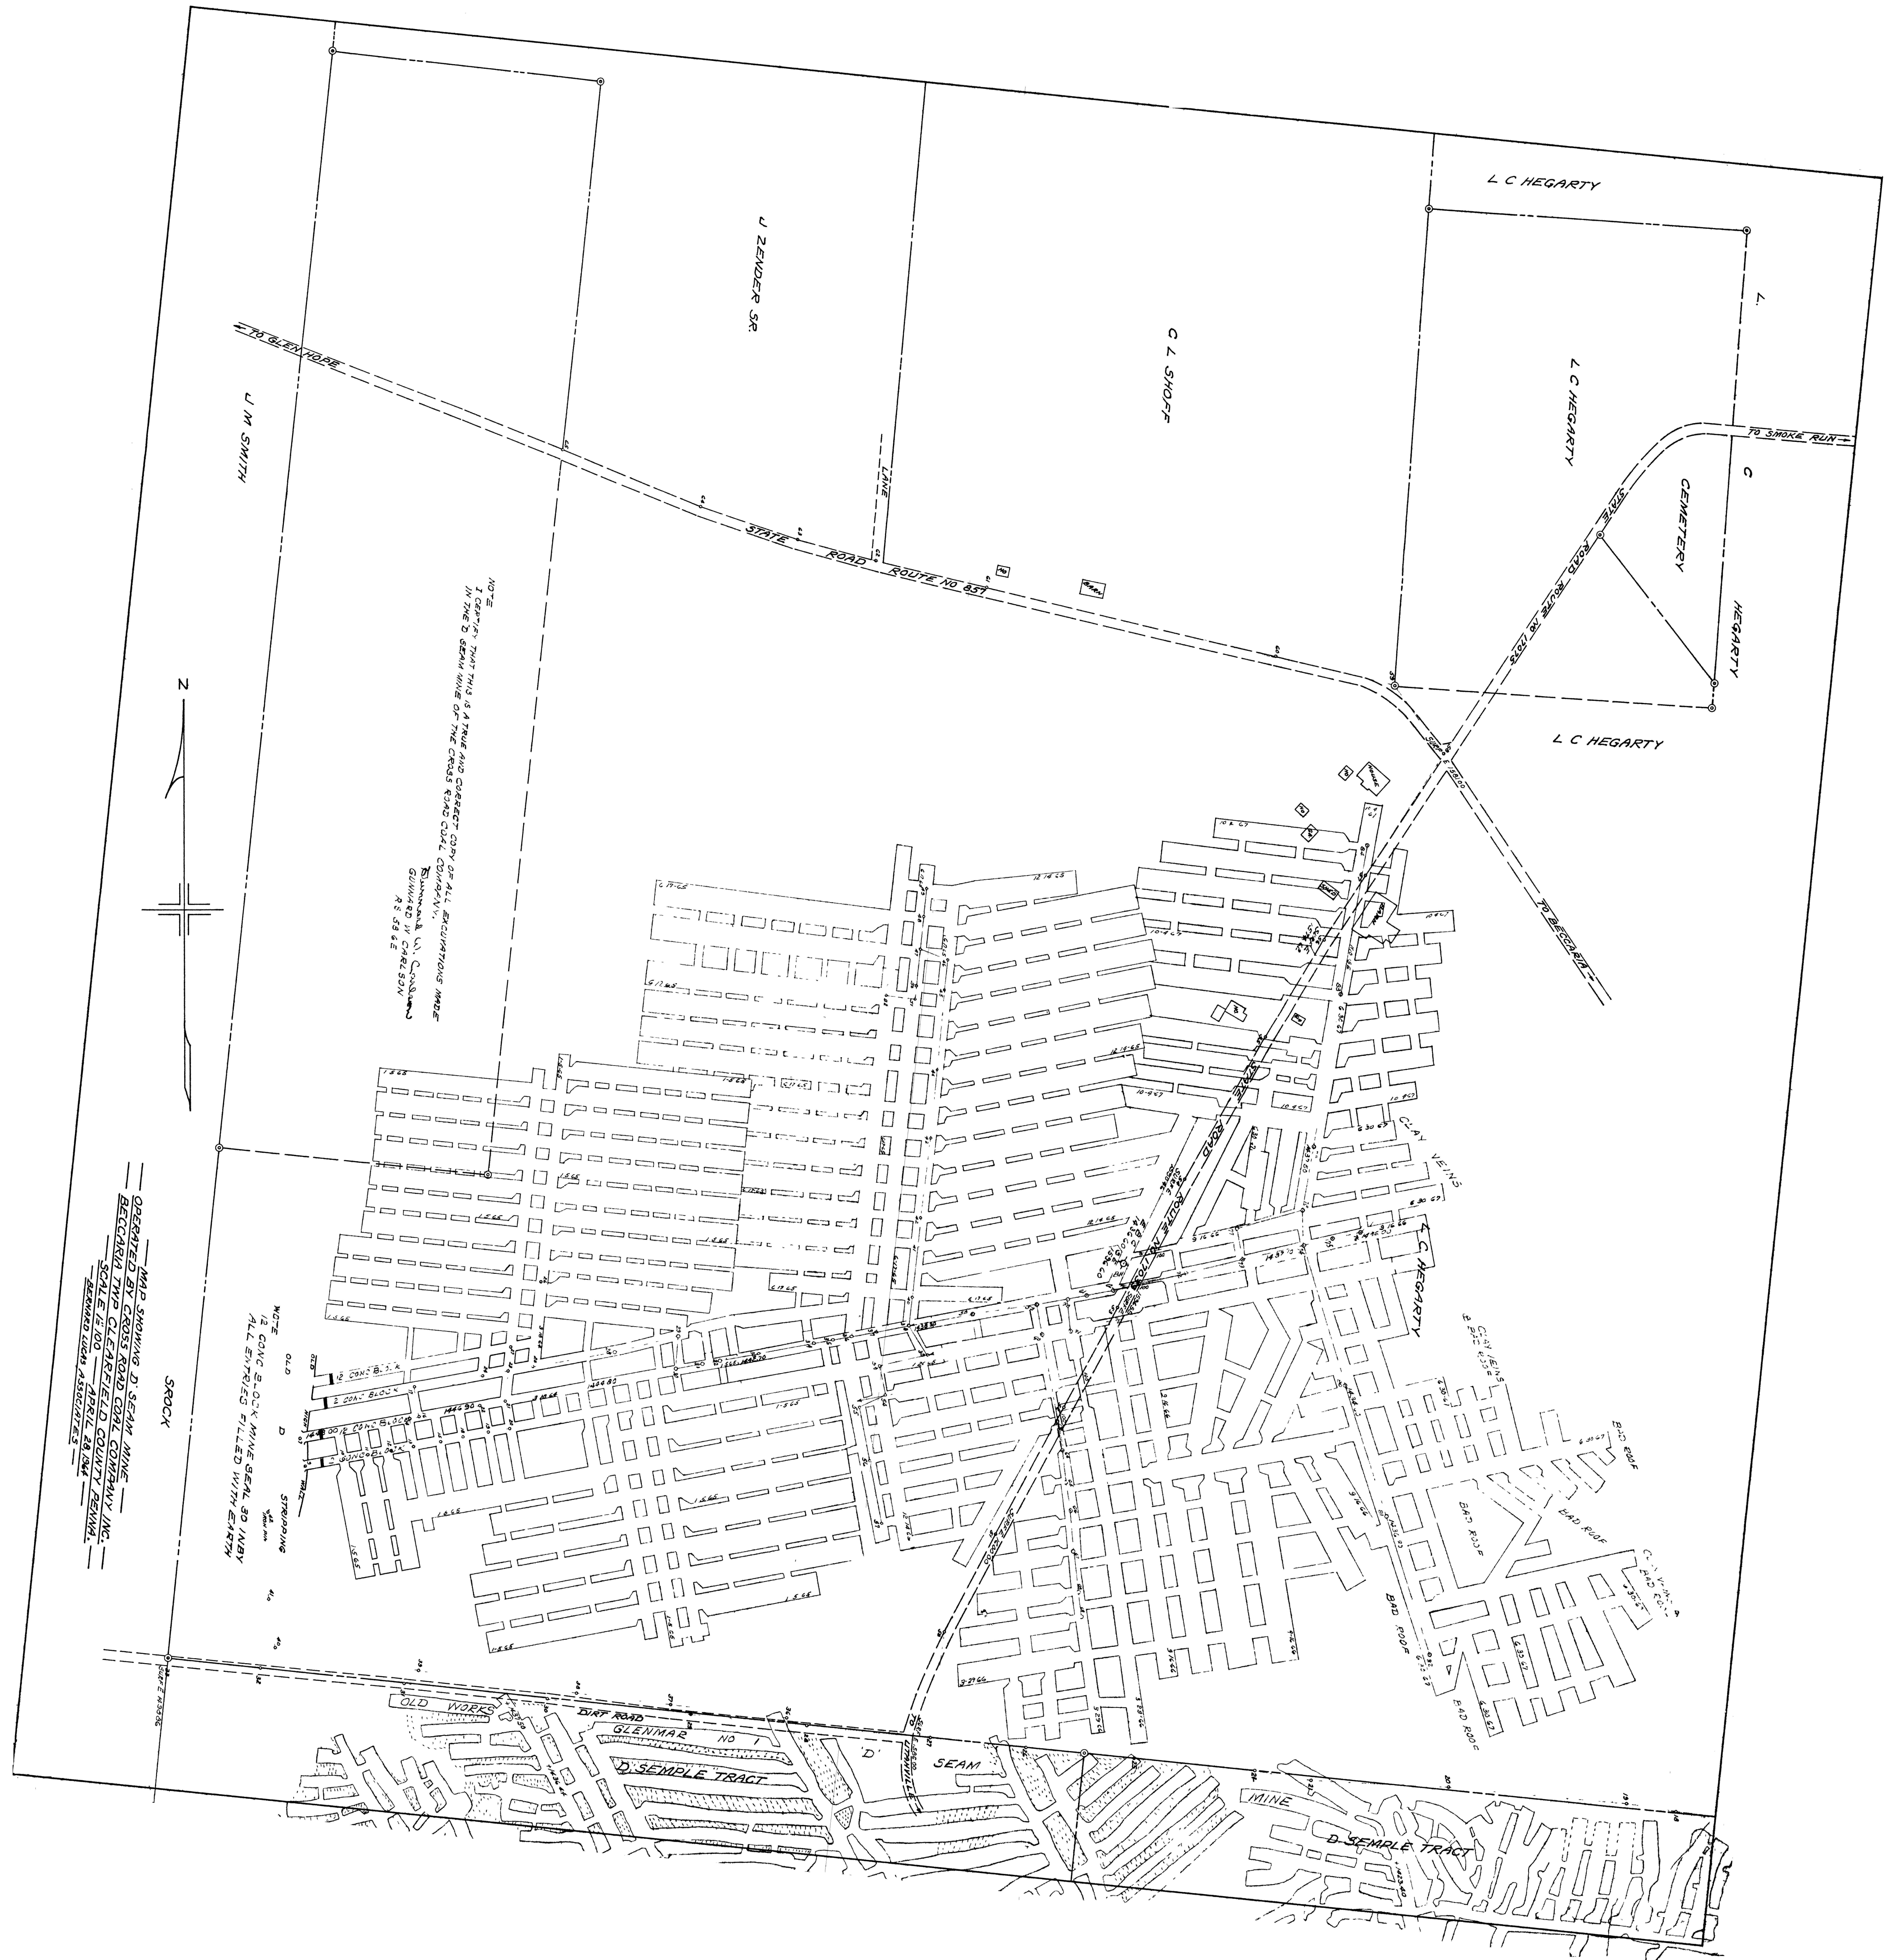

NOTE
I HEREBY CERTIFY THAT THIS IS A TRUE AND CORRECT COPY OF ALL EXCAVATIONS MADE
IN THE D. SEMPLE MINE OF THE CROSS ROAD COAL COMPANY, INC.
SUNNINGDALE, N.Y. C. L. SHOFF
OWNED BY CARLSON
AS 59 6 E

NOTE
OLD
D
STANDING
1/2 CONC. B-OK MINE SEAM, 30 INCH
ALL ENTRIES FILLED WITH EARTH

MAP SHOWING D. SEMPLE MINE
OPERATED BY CROSS ROAD COAL COMPANY, INC.
BEGGARIA TWP. CLEARFIELD COUNTY, PENNA.
SCALE 1/2 IN. = 100 FEET
APRIL 28, 1944
BENJAMIN RICH ASSOCIATES