


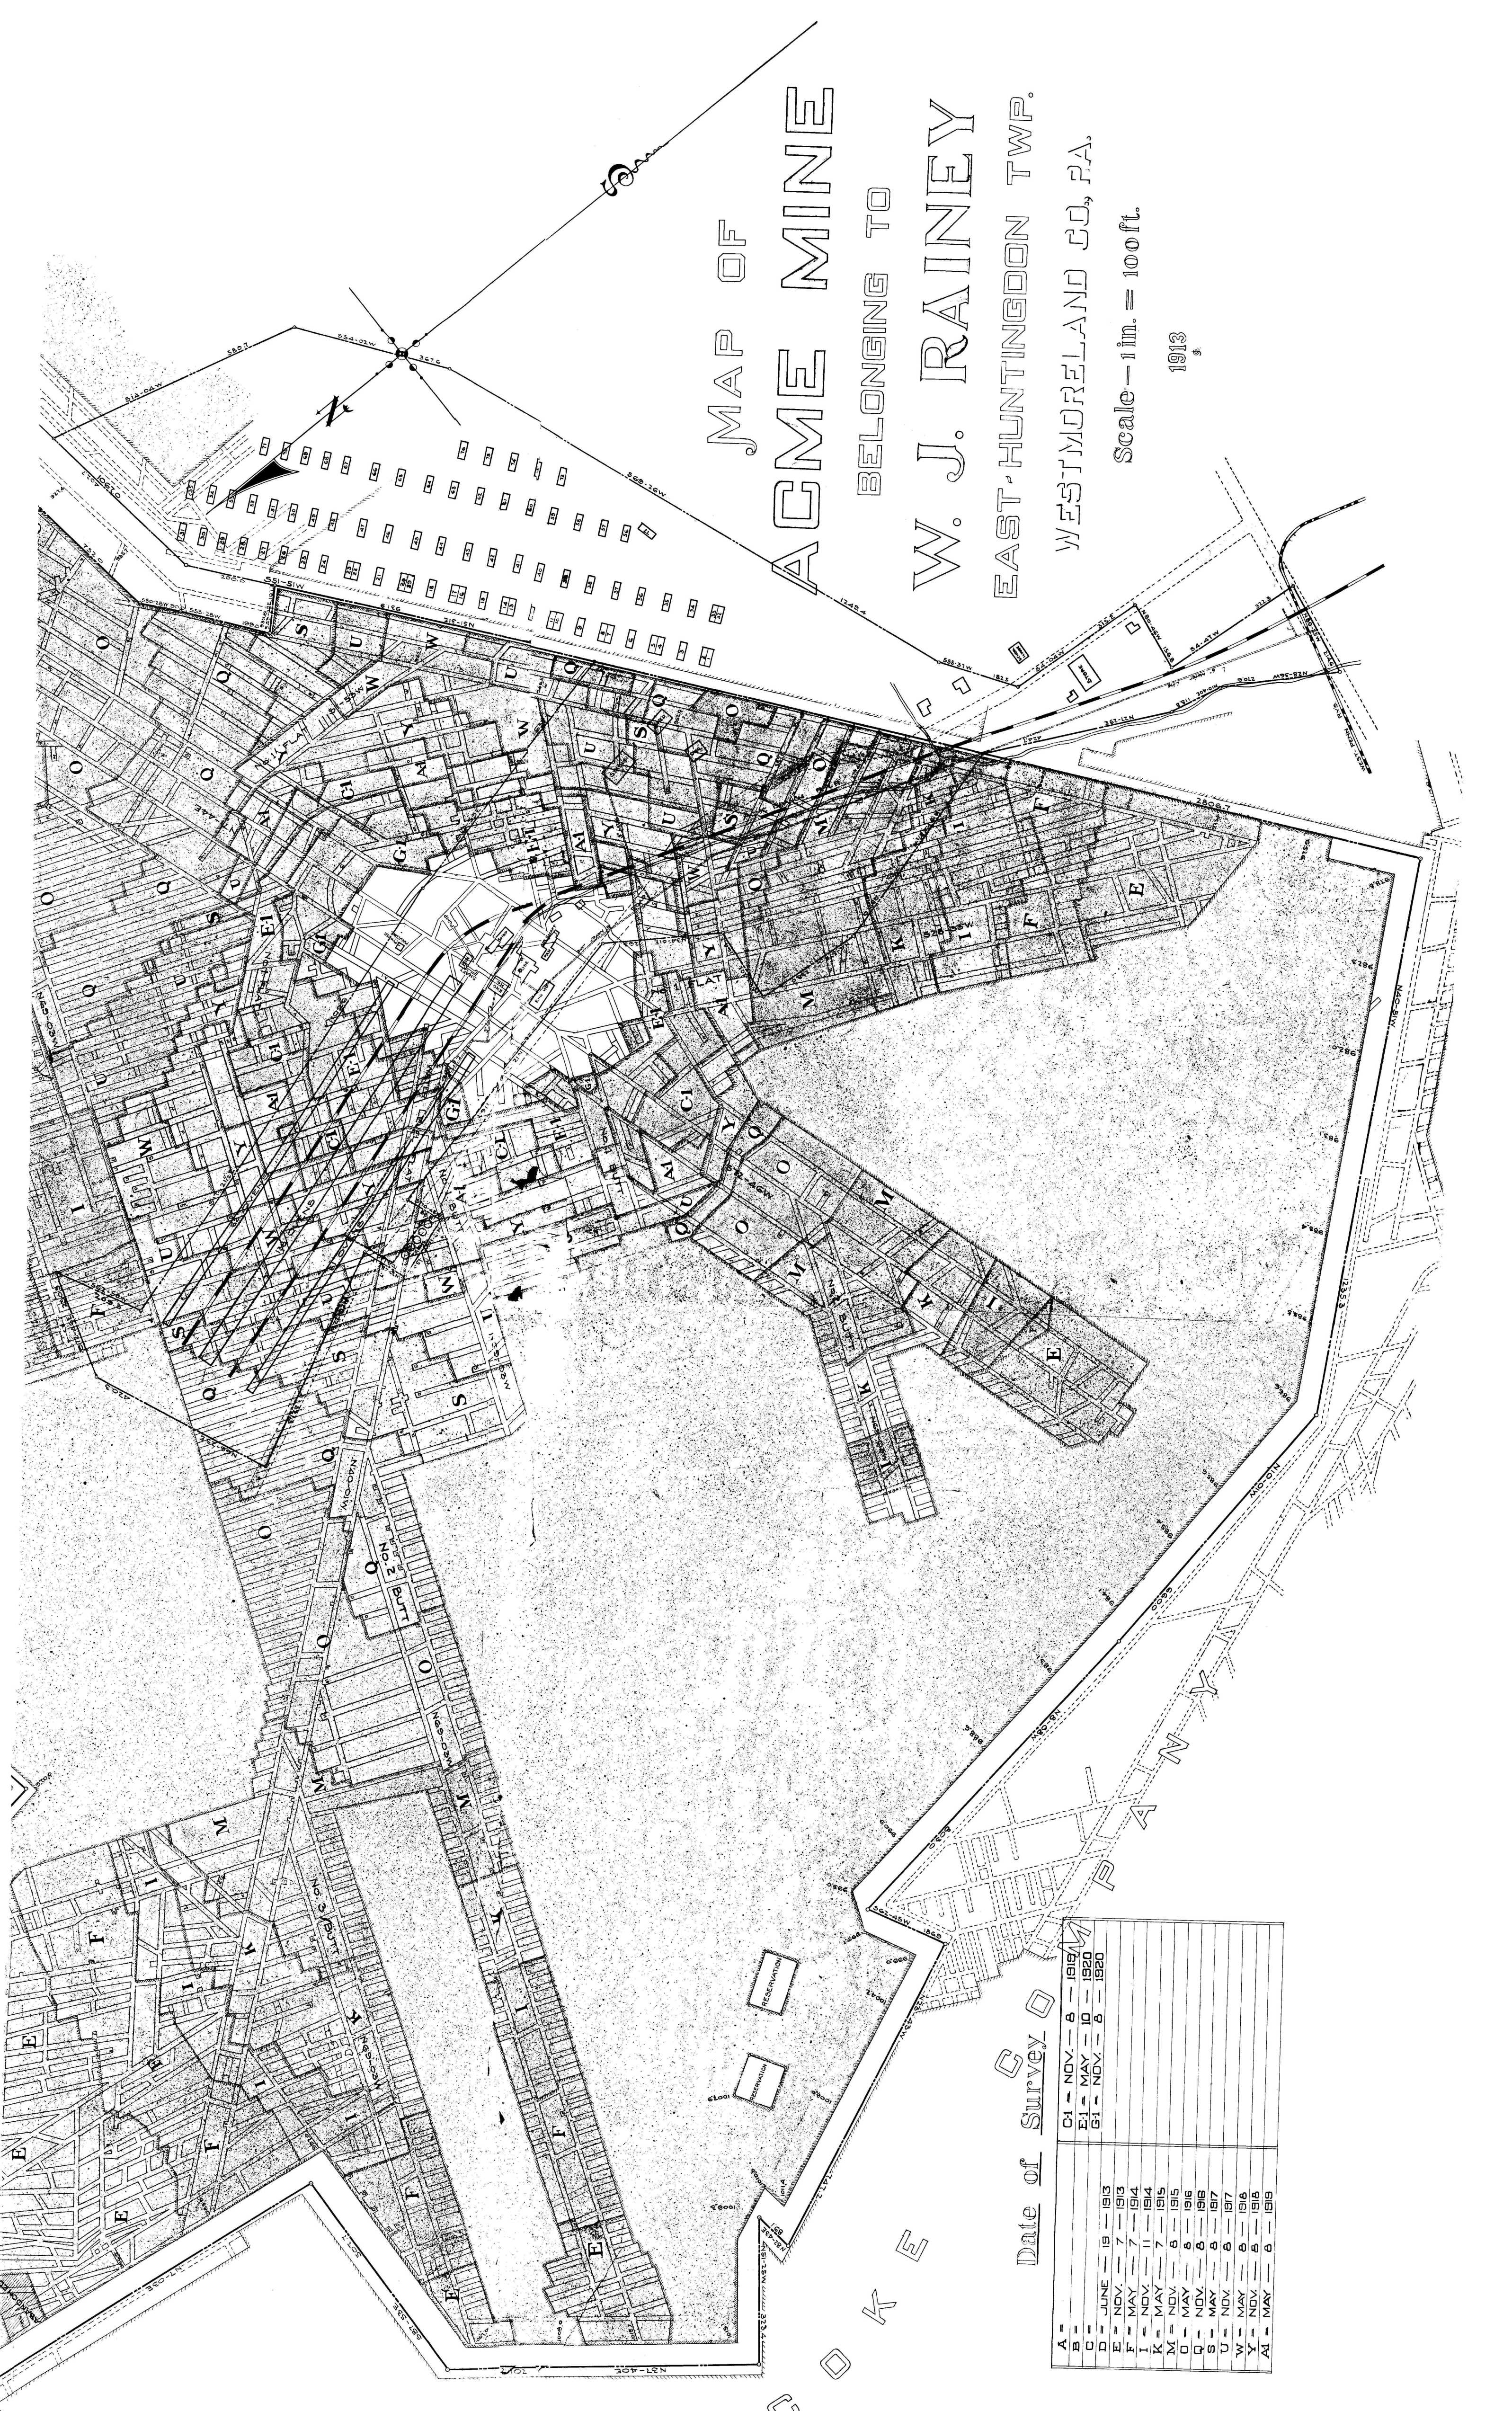

MAP OF ACME MINE

BELONGING TO
W. J. RAINEY
EAST-HUNTINGDON TWP.
WESTMORELAND CO., PA.
Scale - 1 in. = 100 ft.

1913

Date of Survey

A =	C1 - NOV. - 8 - 1913
B =	E1 - MAY - 10 - 1920
C =	G1 - NOV. - 8 - 1920
D =	JUNE - 19 - 1913
E =	NOV. - 7 - 1913
F =	MAY - 7 - 1914
G =	NOV. - 11 - 1914
H =	MAY - 7 - 1915
I =	NOV. - 6 - 1915
J =	MAY - 6 - 1916
K =	NOV. - 6 - 1916
L =	NOV. - 6 - 1917
M =	NOV. - 6 - 1917
N =	NOV. - 6 - 1918
O =	NOV. - 6 - 1918
P =	NOV. - 6 - 1919