CROSSLAND MINE

OF THE

H. C. FRICK COKE CO.

NORTH UNION TWP.- FAYETTE CO.- PA.

DATUM OF 7 PEELS 10.1 FT. BELOW MEAN TIDE AT SANDY HOOK

SCALE 1"=100'

DATE OF SURVEYS

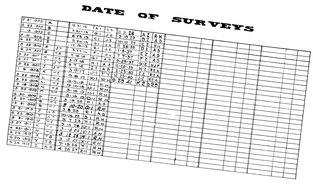

These Tracings are certified to show to the best of my knowledge and belief the Crossland Mine Field as of September 23, 1941, when the mining was finished

T. [illegible] Chief Engineer

Dated October 2, 1941