


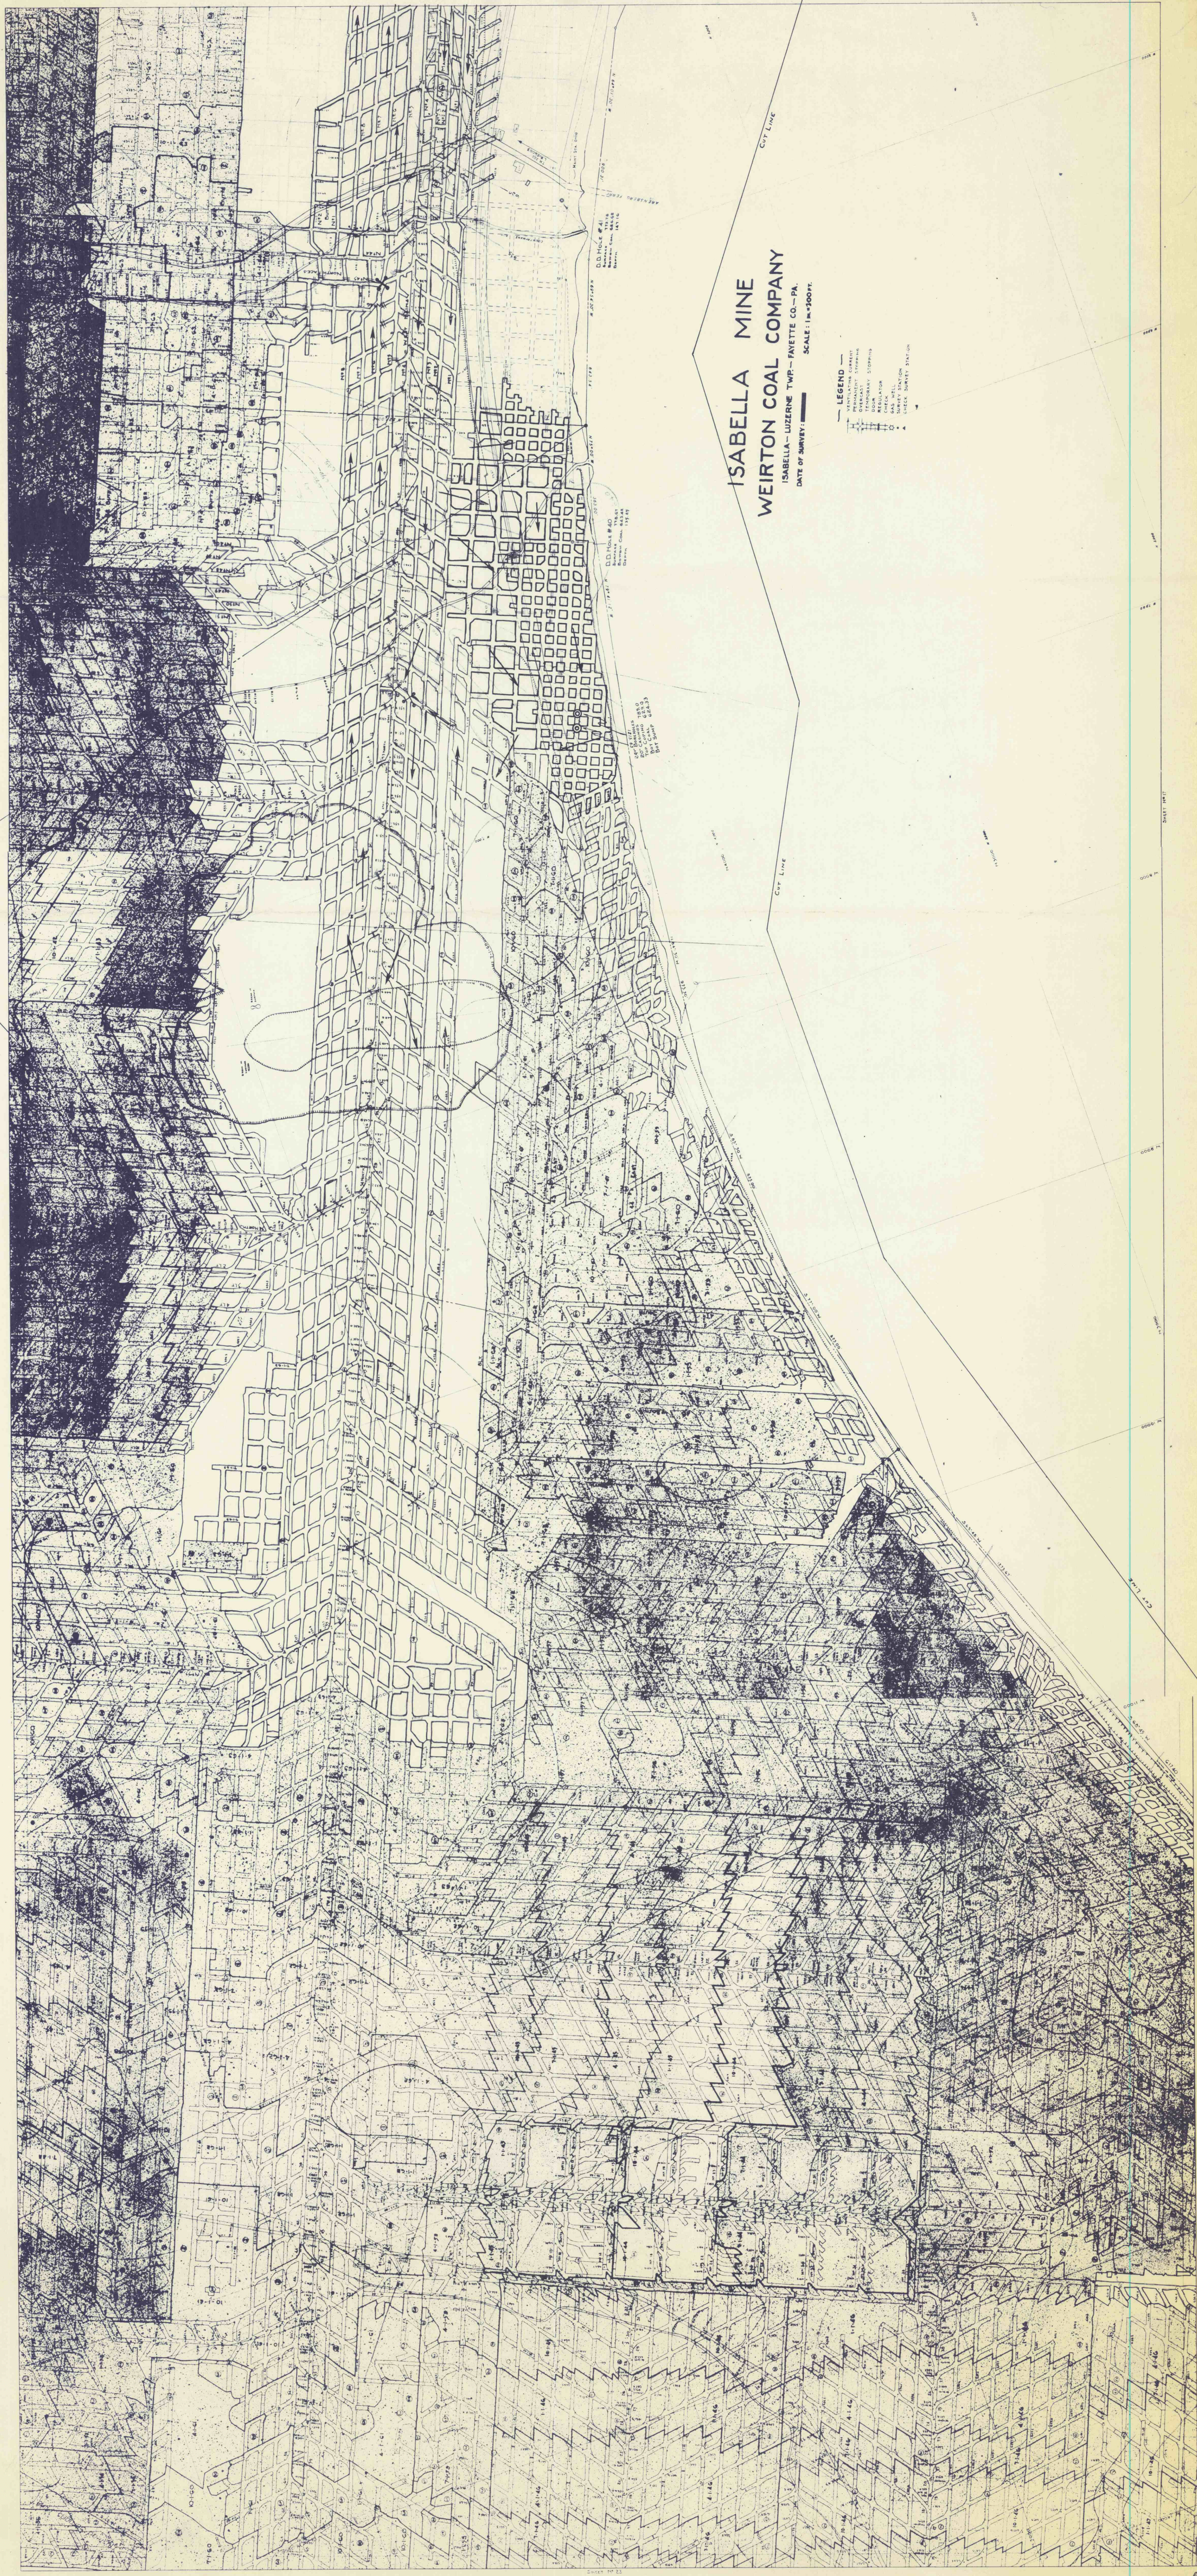

ISABELLA MINE
WEIRTON COAL COMPANY
ISABELLA - LUZERNE TWP. - FALETTE CO. - PA.
DATE OF SURVEY: _____
SCALE: 1" = 500 FT.

- LEGEND**
