


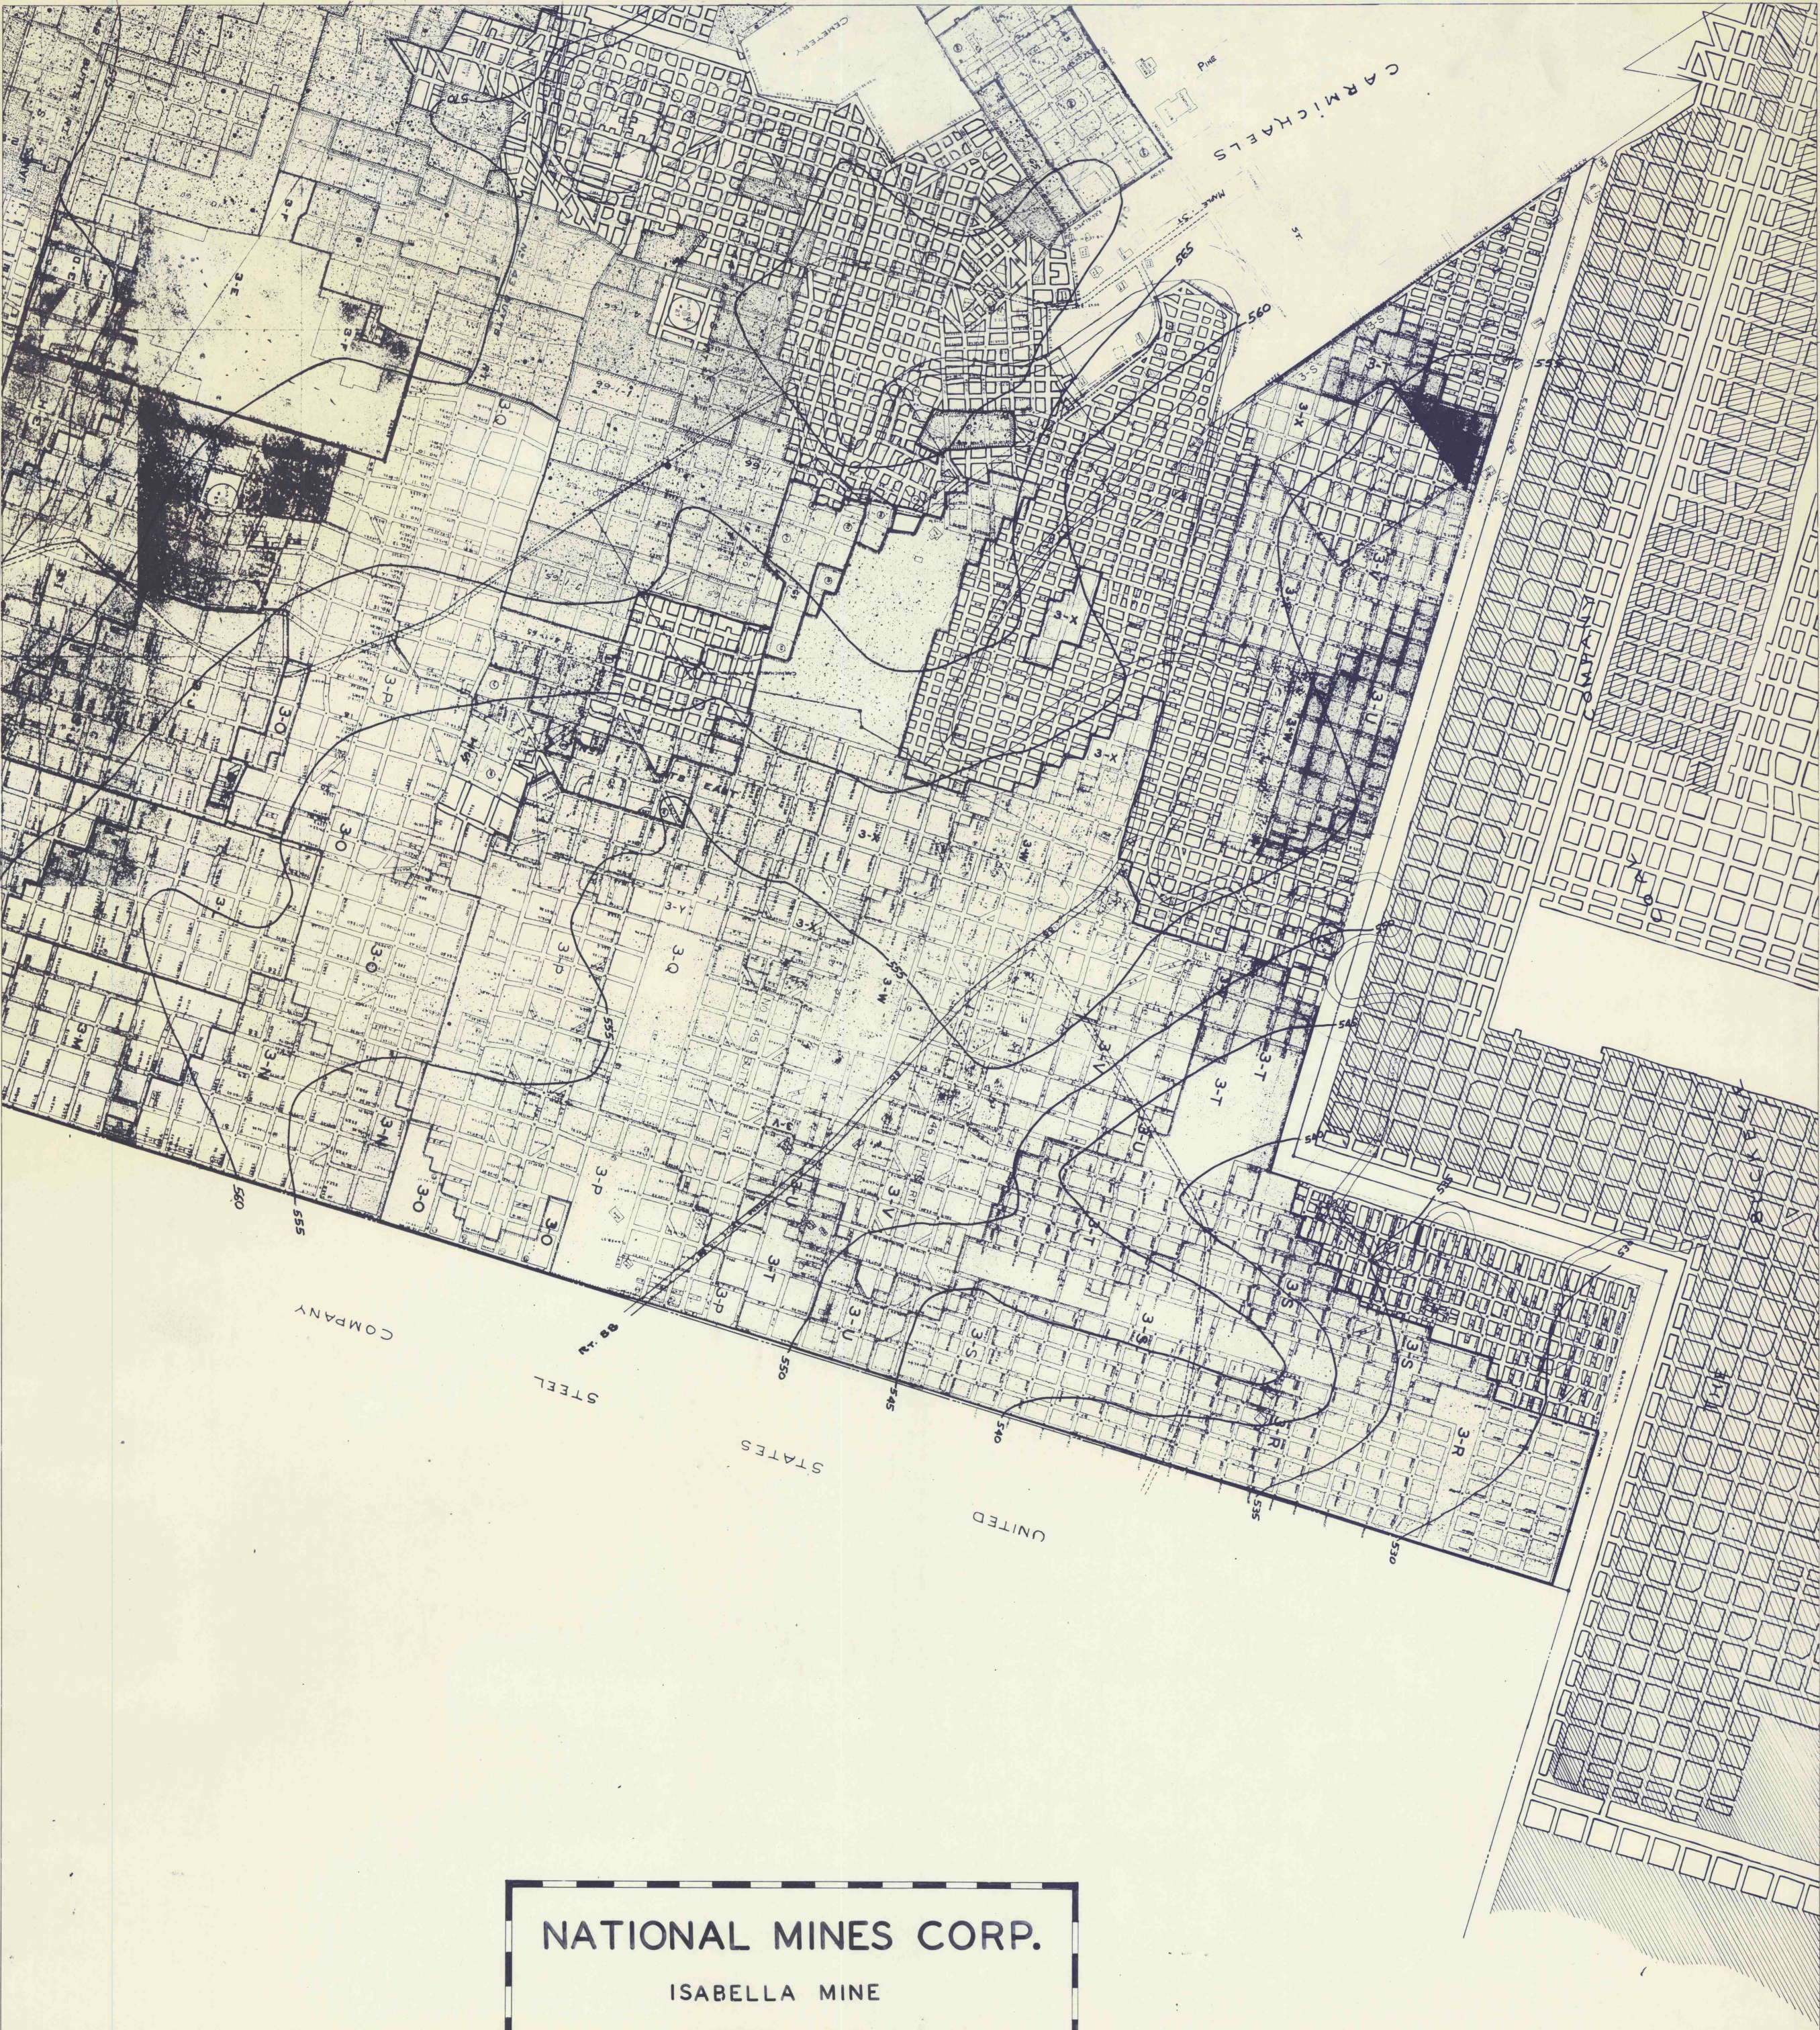

NATIONAL MINES CORP.

ISABELLA MINE

ISABELLA PA.

FEDERAL MINE NO. 36 00899

DATE _____ SCALE 1"=200'

52-1-7
602#