


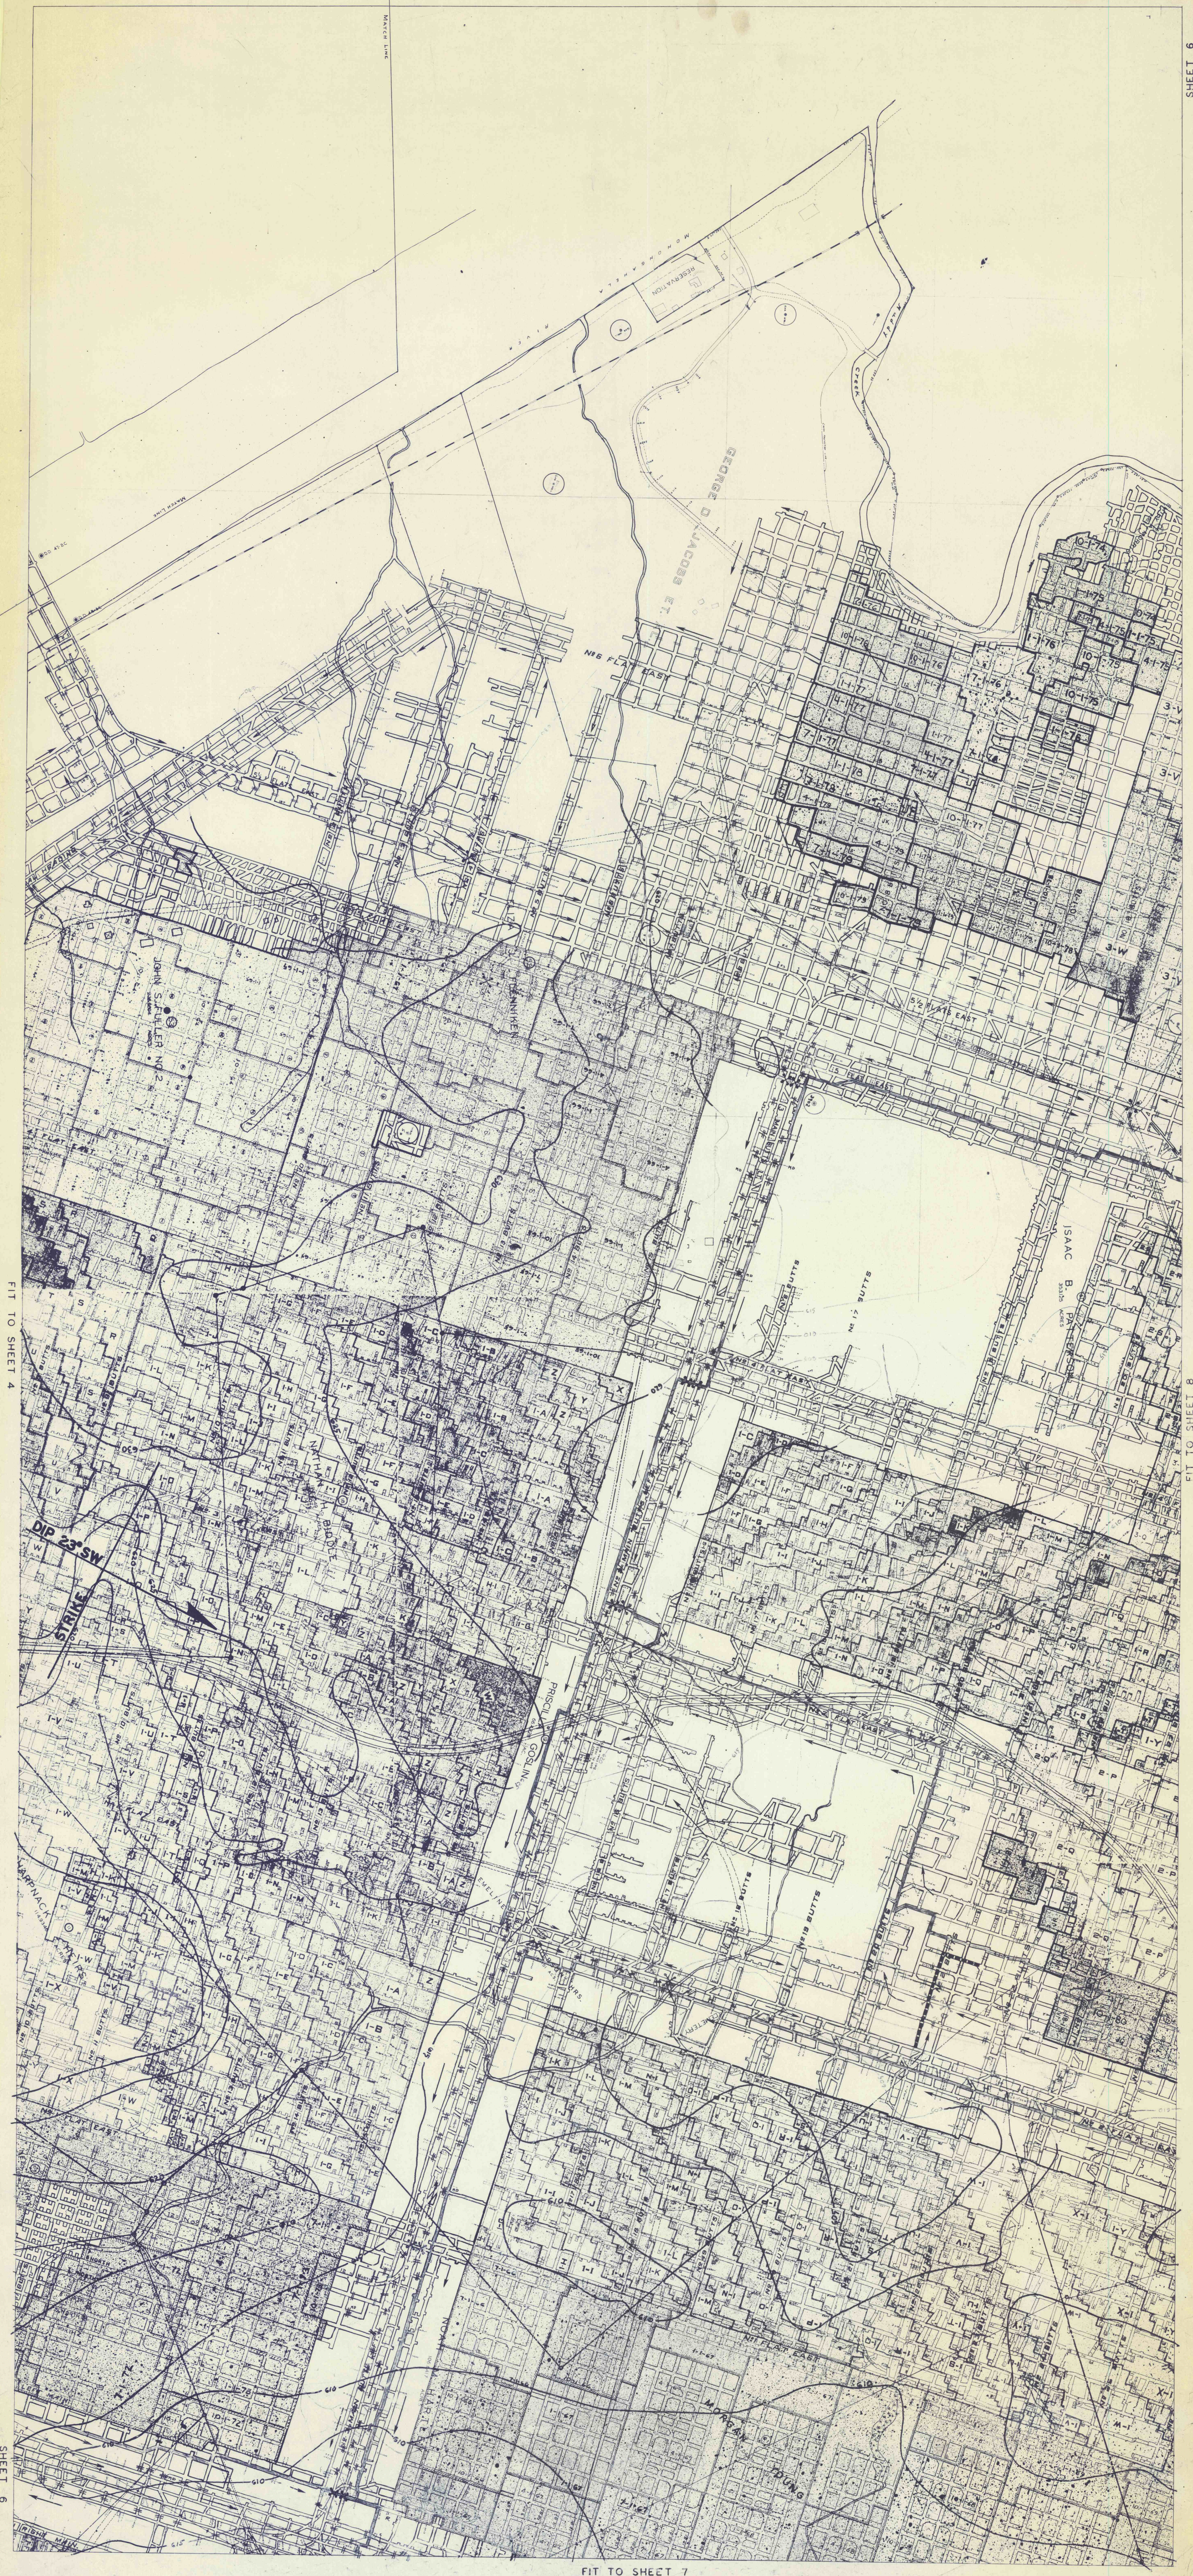

FIT TO SHEET 4

FIT TO SHEET 8

SHEET 6

FIT TO SHEET 7