


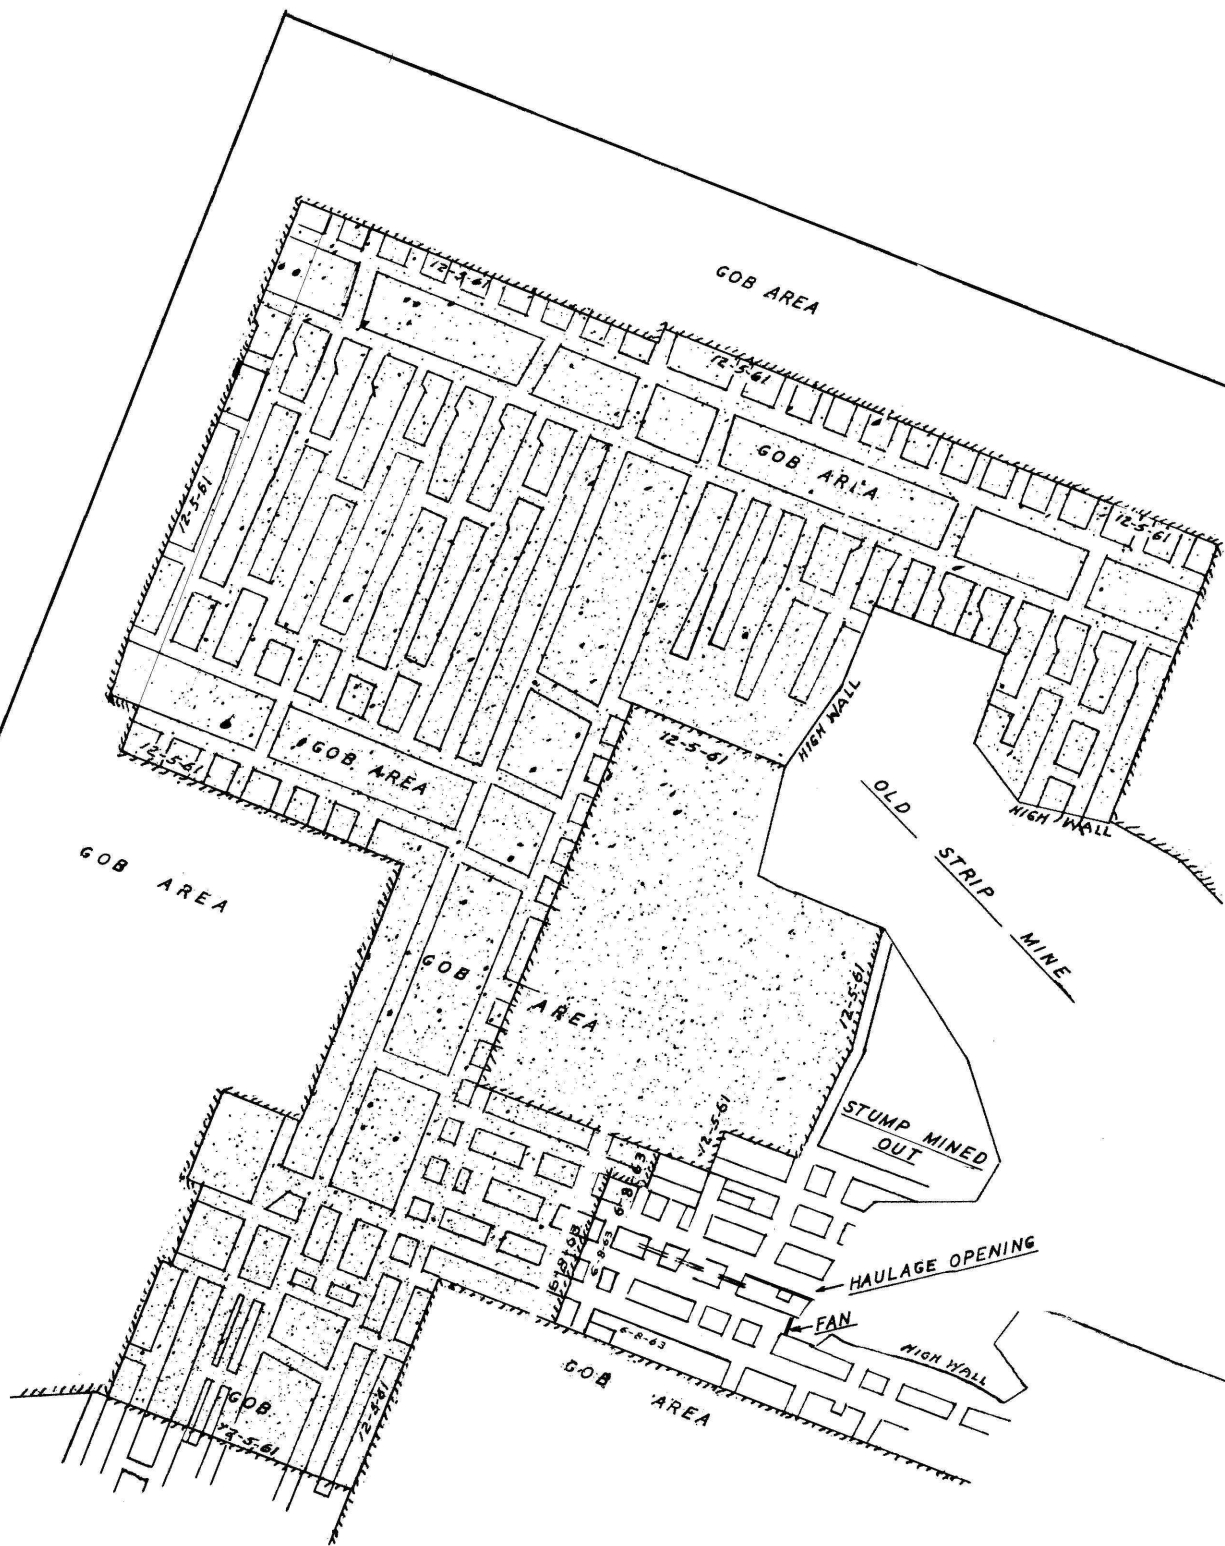

CRYSTAL MINE
SPRINGHILL, TWP. FAYETTE, CO. PA.
GANS MINING CO. INC.
LLOYD WILBURN OPERATOR
P.O. BOX 16
GANS, PA.
SCALE 1"=100 FT.
DATE JUNE 8 1963

SURVEY DATES
NOV. 25, 1960 J.M. CUBBAGE
DEC. 5, 1961 J.M. CUBBAGE
JUNE 8, 1963 C.H. REED

Charles H. Reed
 FOR GANS MINING CO. INC.