


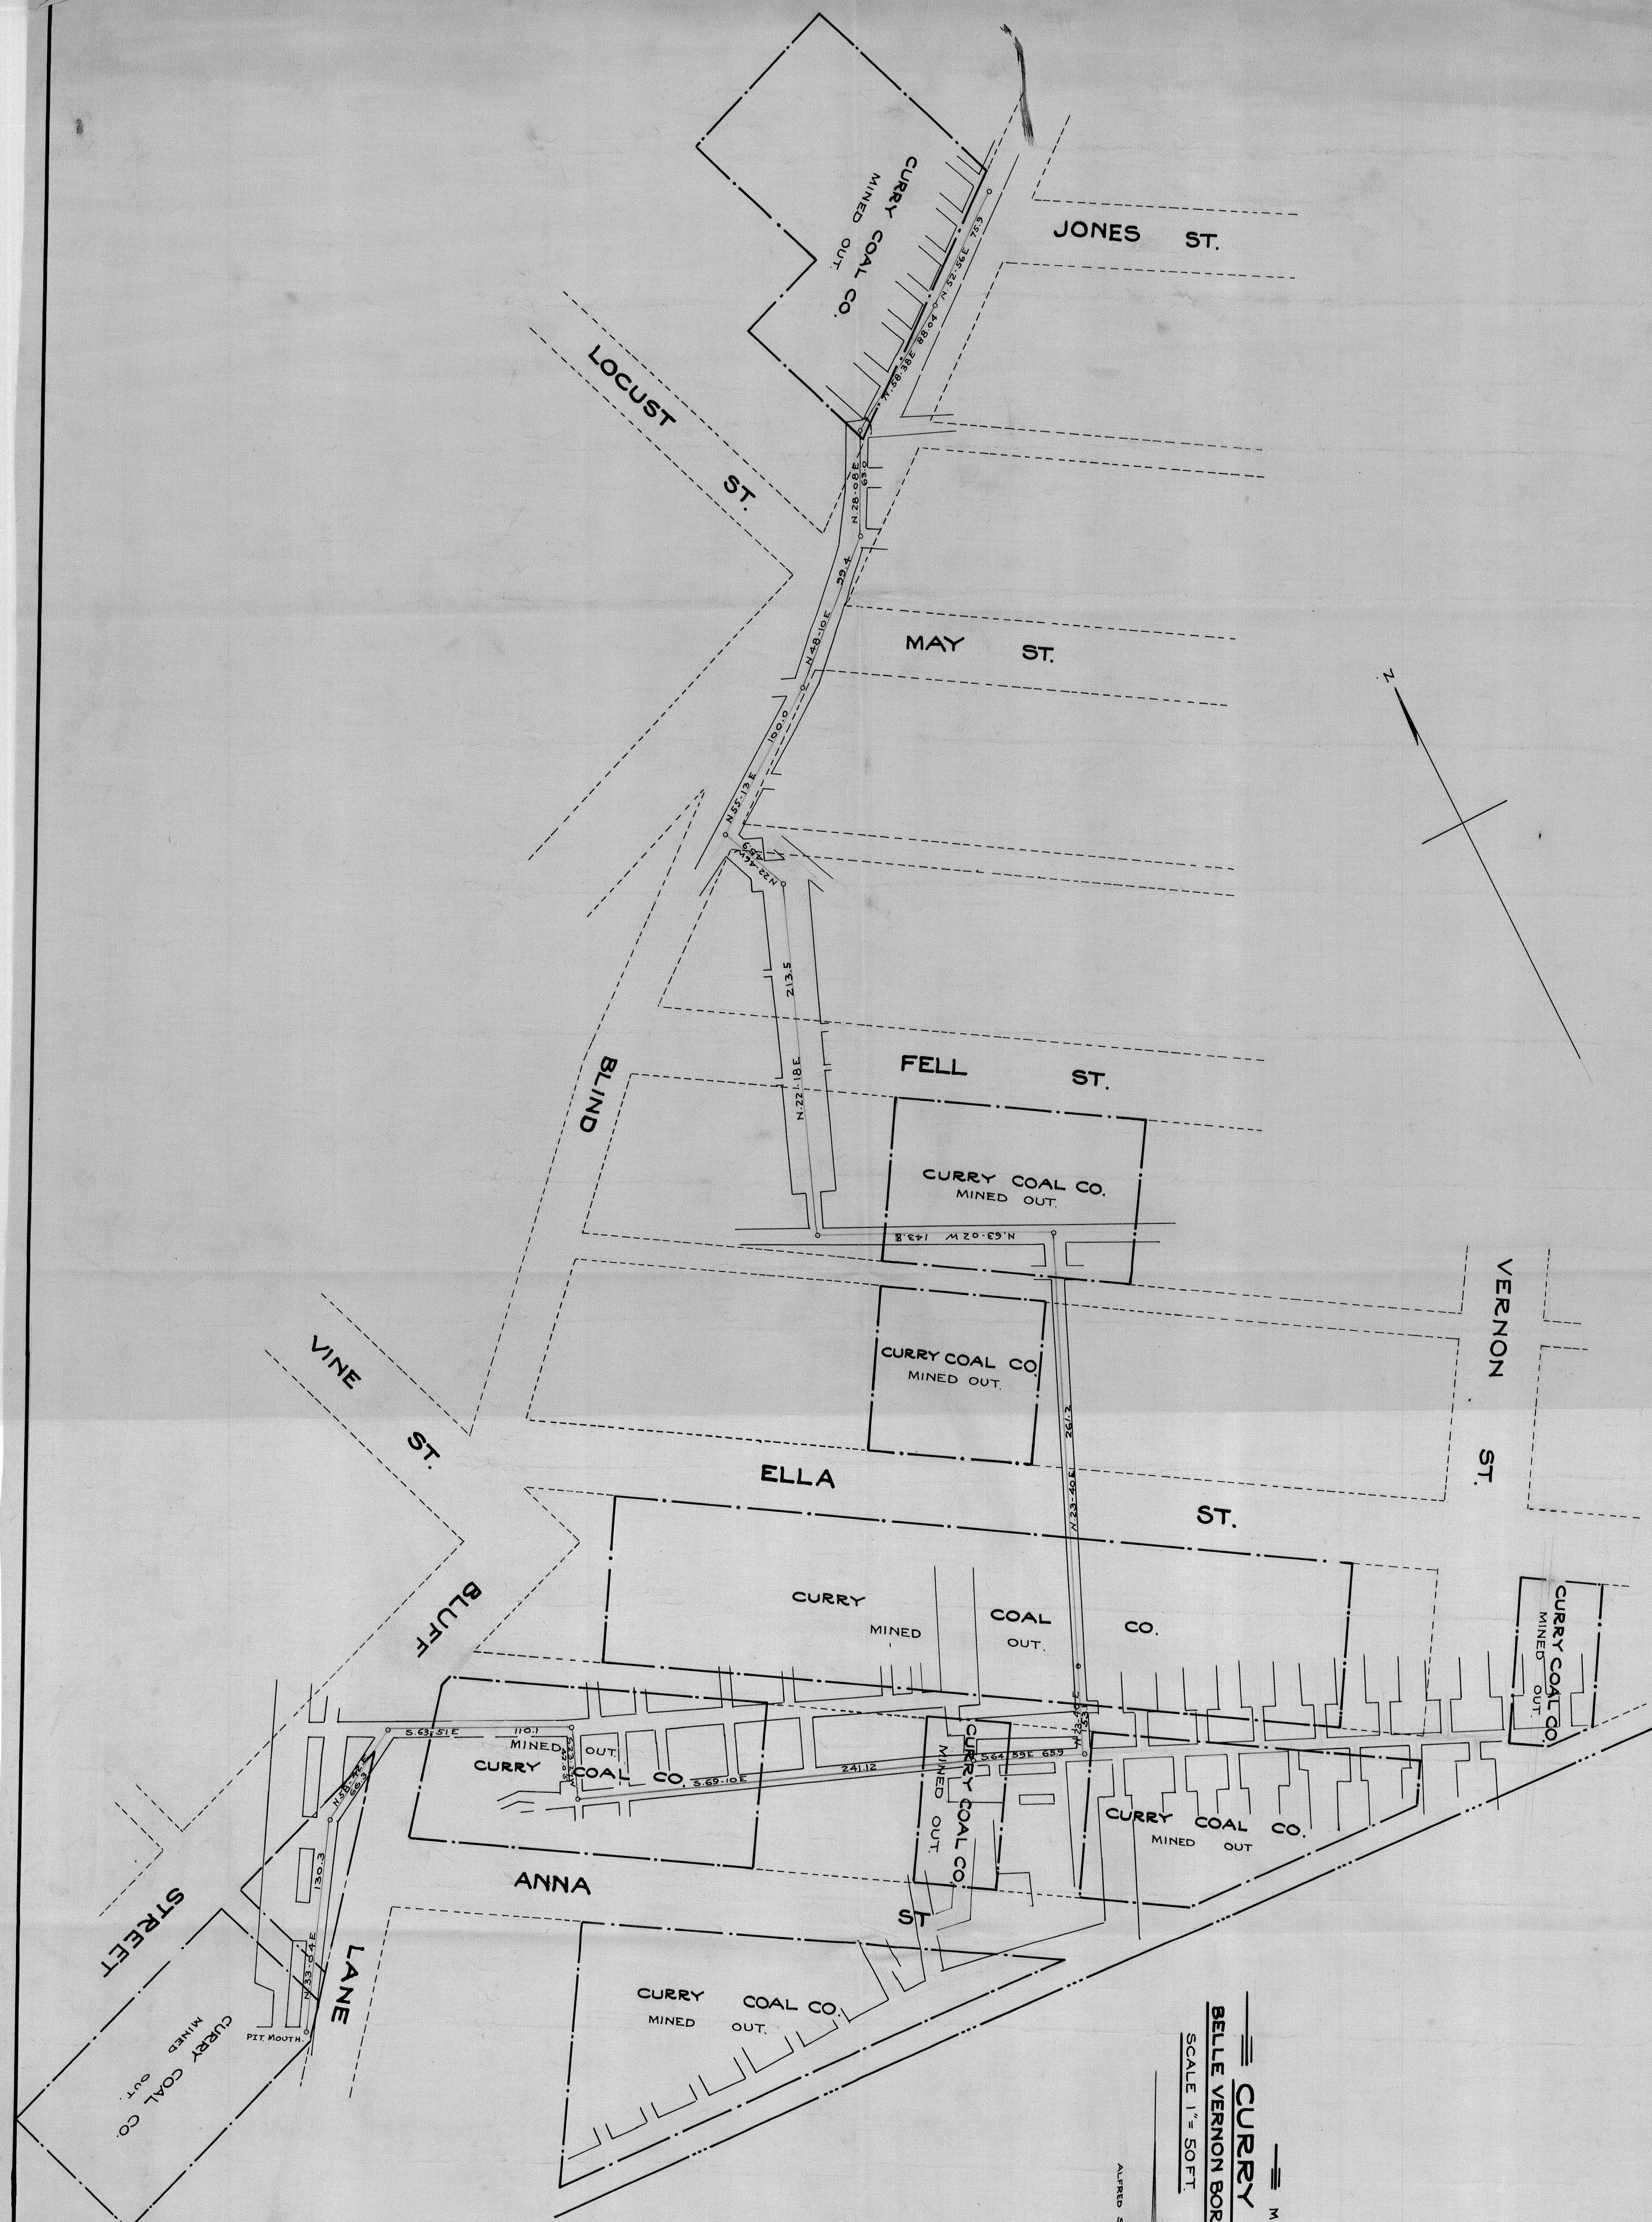

MINE OF
CURRY COAL CO.
BELLE VERNON BORO, WESTMORELAND CO. PA.
SCALE 1" = 50 FT.
JUNE 21, 1926

ALFRED S. PUGH, INC.

182218

#710
7-2-26
C.C.