


#715
7-8-99
C.C.

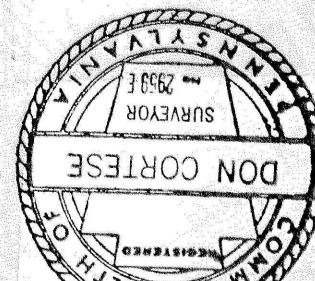

FINAL MAP
H.S. NO. 2999-E
Scale: 1" = 100'
Survey: JENNIFER TWP., SOMERSET CO., PA.
UPPER FREEPORT SEAM
BOYD L. SUSSEX COAL CO., INC. OPERATOR
Sept. 1, 1969

JACOB & MORGAN SHAFER

RESERVE

SOLID Support No Mining
Martin Blough

COAL OUT 8-20-65

COAL OUT (5-25-52)

COAL OUT (2-13-51)

OUTCROP E SEAM

MAHLON

COAL

WALL 55

WALL 55

